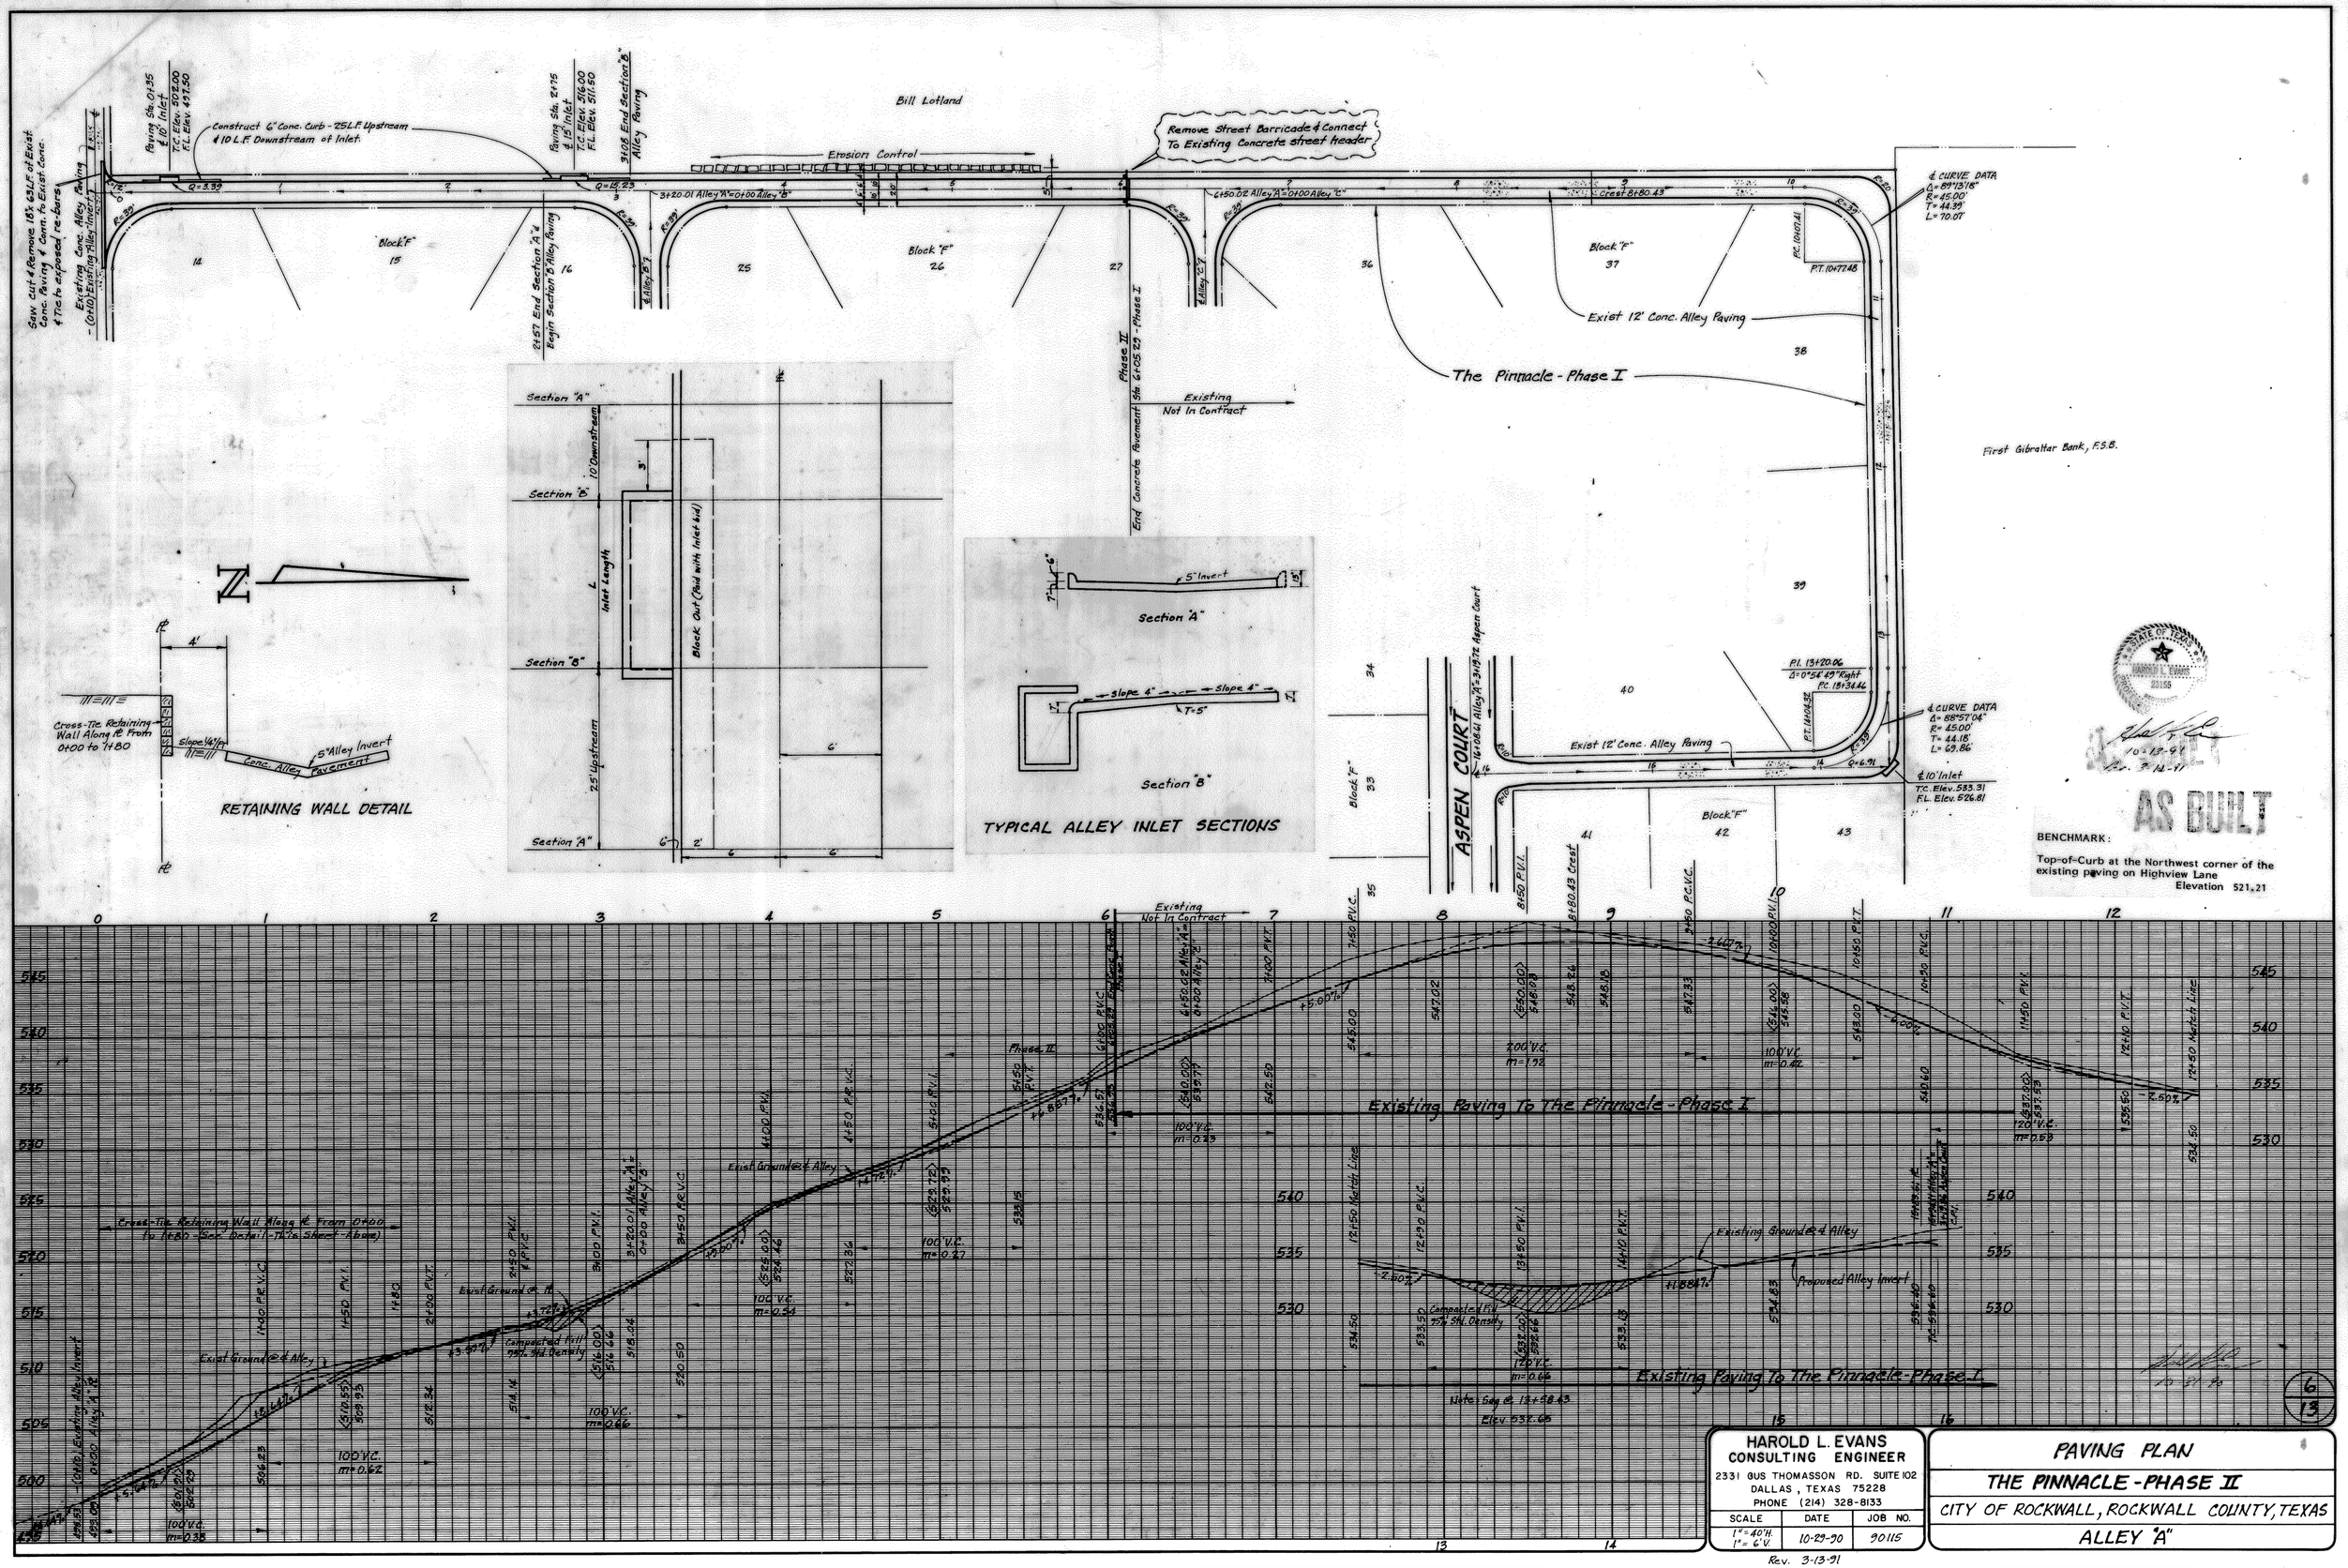

AS BUILT

BENCHMARK:

Top-of-Curb at the Northwest corner of the existing paving on Highview Lane
Elevation 521.21

HAROLD L. EVANS
CONSULTING ENGINEER
2331 GUS THOMASSON RD. SUITE 102
DALLAS, TEXAS 75228
PHONE (214) 328-8133

SCALE	DATE	JOB NO.
1" = 40' H. 1" = 6' V.	10-29-90	90115

Rev. 3-13-91

PAVING PLAN

THE PINNACLE - PHASE II

CITY OF ROCKWALL, ROCKWALL COUNTY, TEXAS

ALLEY "A"

6/13