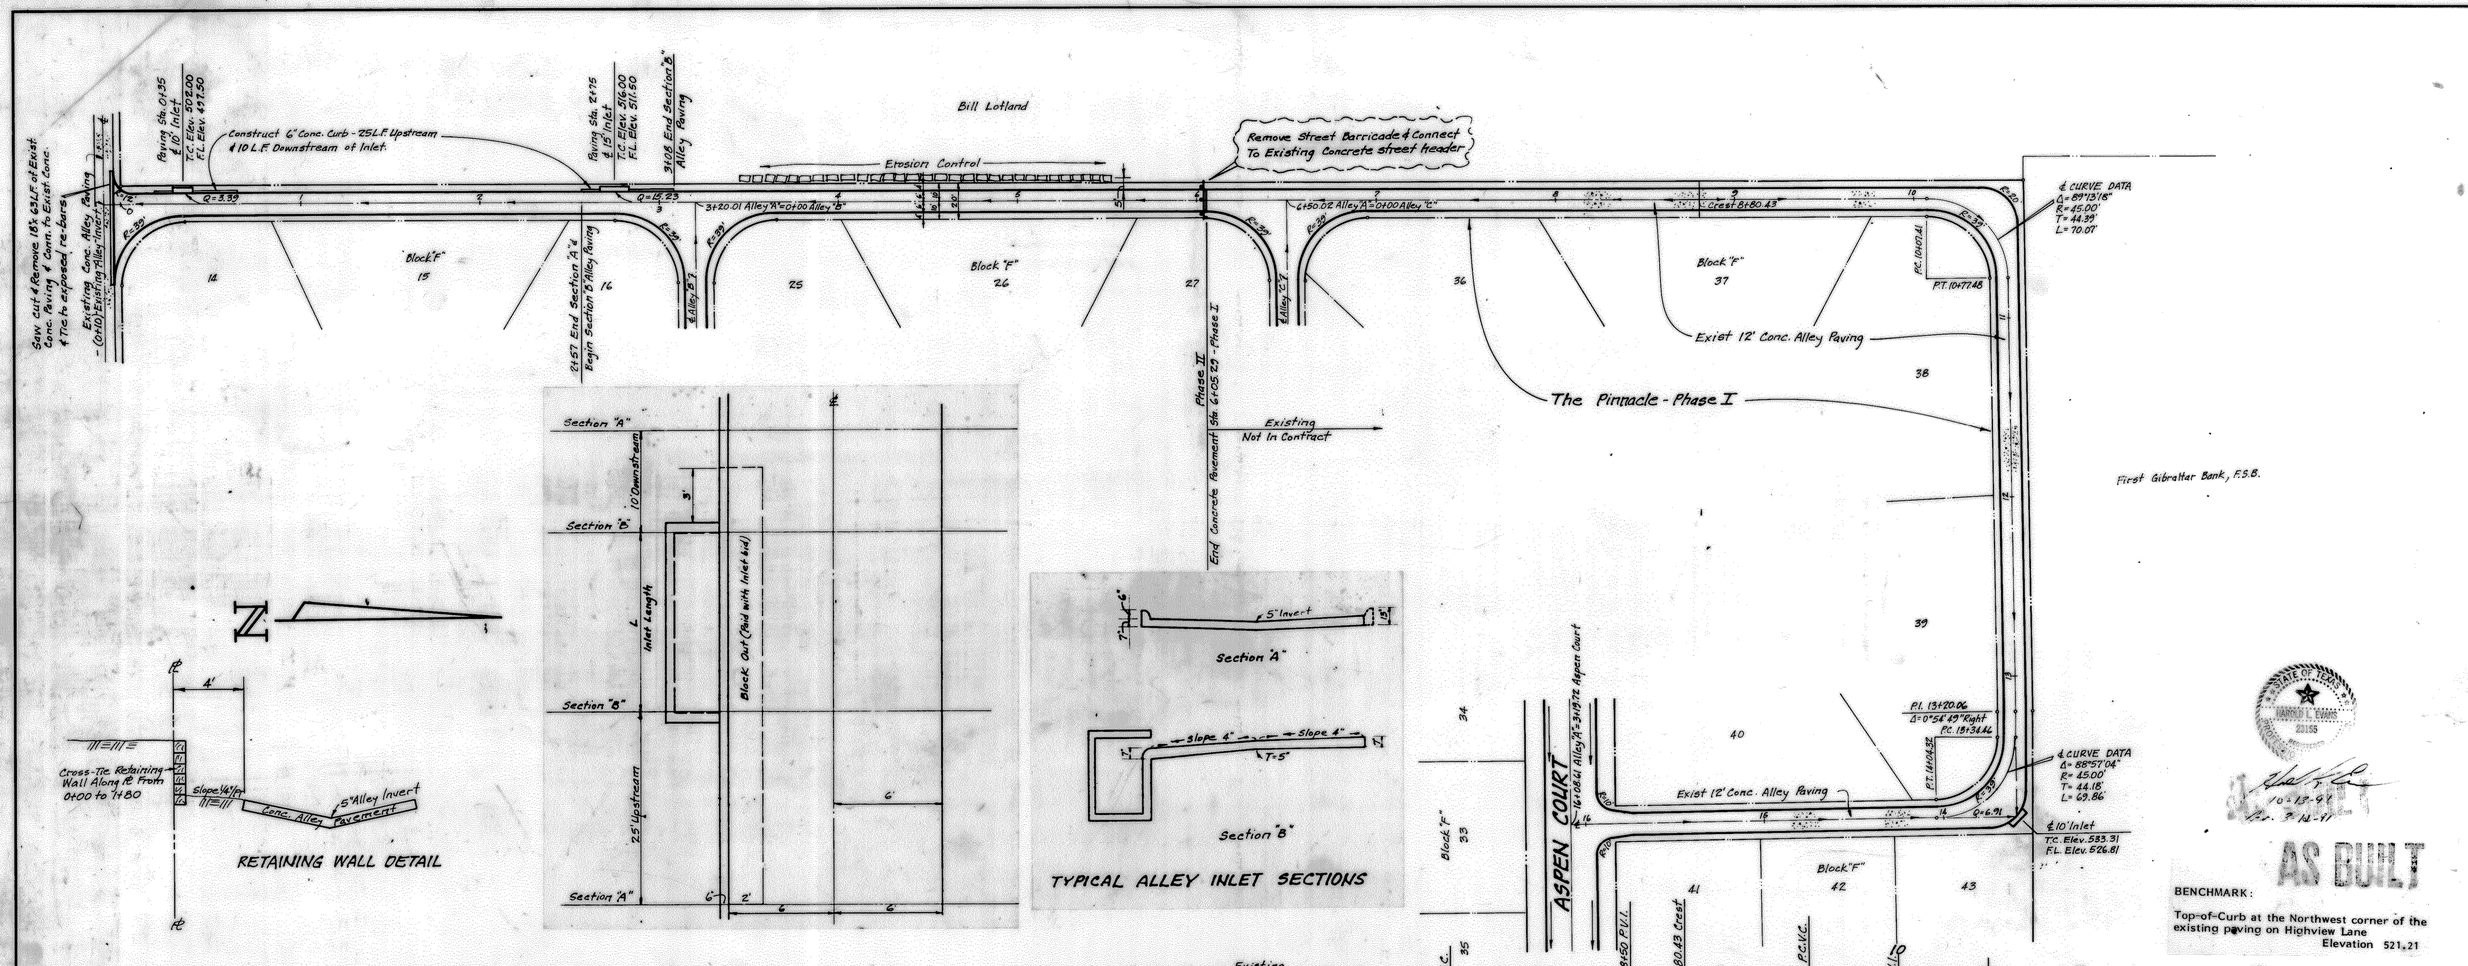

STATE OF TEXAS
HAROLD L. EVANS
23155
10-29-90

AS BUILT

BENCHMARK:

Top-of-Curb at the Northwest corner of the existing paving on Highview Lane
Elevation 521.21

6
13

HAROLD L. EVANS CONSULTING ENGINEER		
2331 GUS THOMASSON RD. SUITE 102 DALLAS, TEXAS 75228 PHONE (214) 328-8133		
SCALE	DATE	JOB NO.
1"=40'H. 1"=6'V.	10-29-90	90115

PAVING PLAN
THE PINNACLE - PHASE II
CITY OF ROCKWALL, ROCKWALL COUNTY, TEXAS
ALLEY 'A'

Rev. 3-13-91