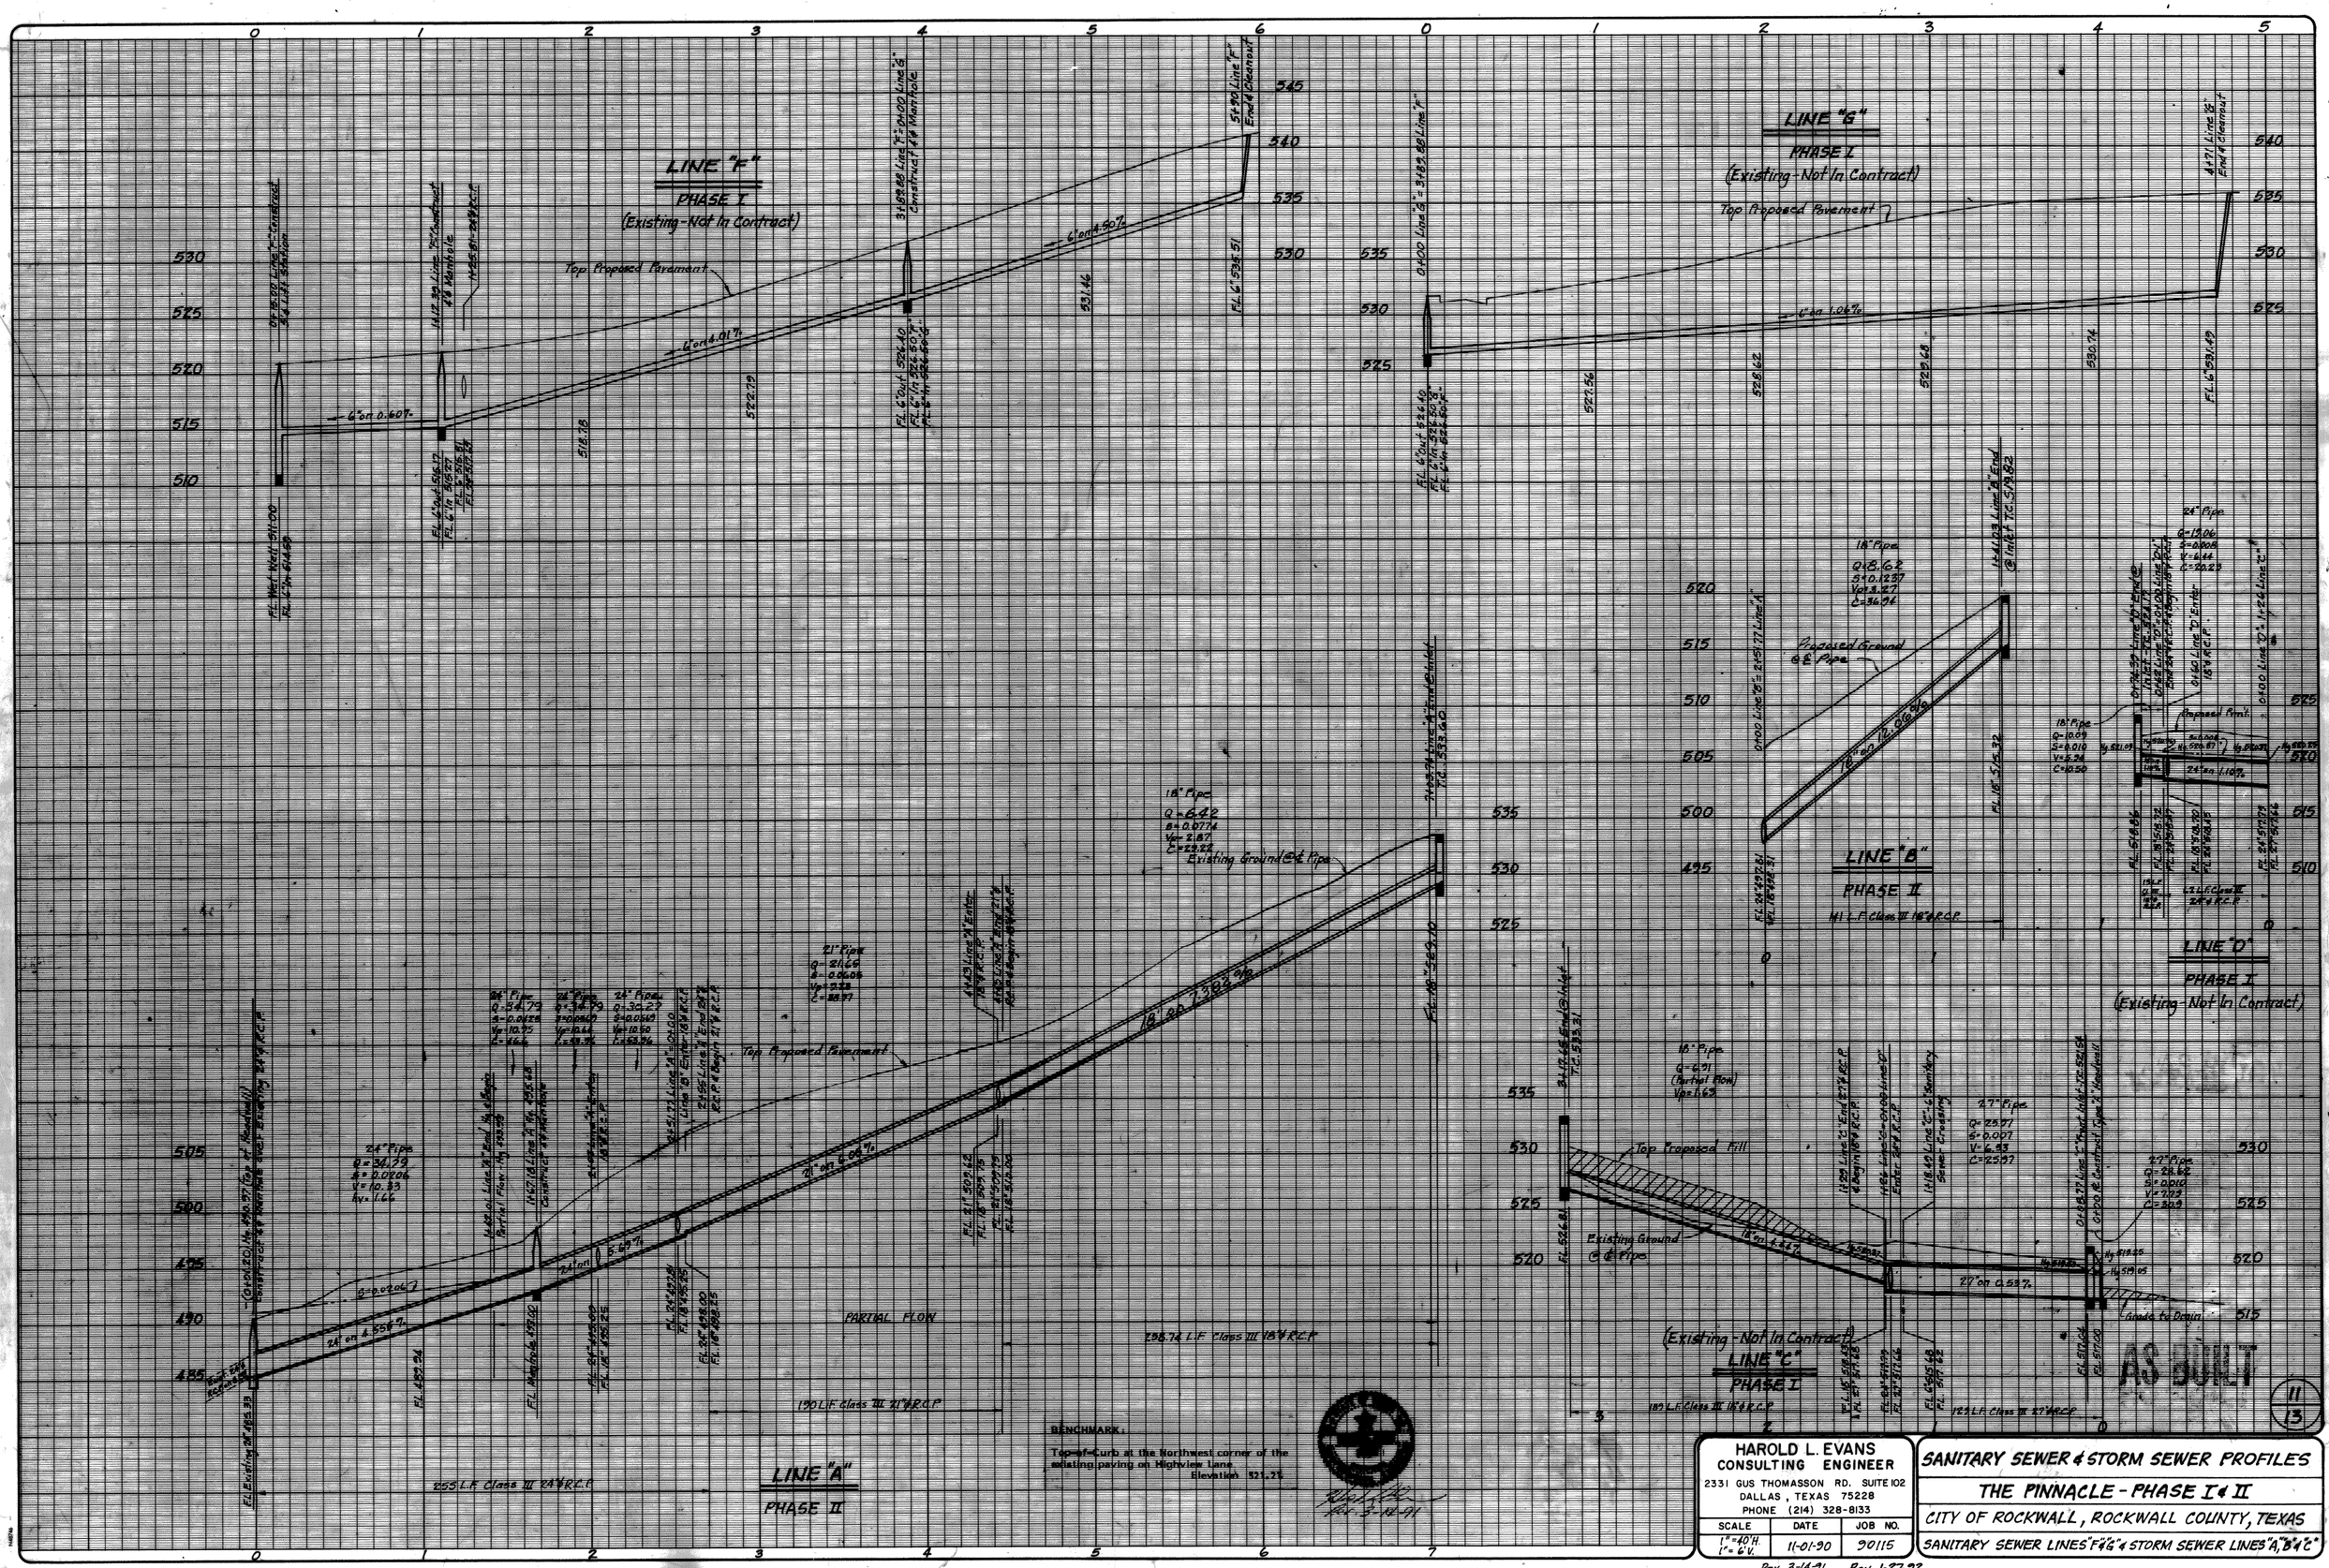

HAROLD L. EVANS CONSULTING ENGINEER		
2331 GUS THOMASSON RD. SUITE 102 DALLAS, TEXAS 75228 PHONE (214) 328-8133		
SCALE	DATE	JOB NO.
1"=40' H. 1"=6' V.	11-01-90	90115

SANITARY SEWER & STORM SEWER PROFILES

THE PINNACLE - PHASE I & II

CITY OF ROCKWALL, ROCKWALL COUNTY, TEXAS

SANITARY SEWER LINES "F" & "G" & STORM SEWER LINES "A", "B" & "C"

Rev 3-14-91
Rev. 1-10-92
Rev. 1-27-92
Rev 1-30-92