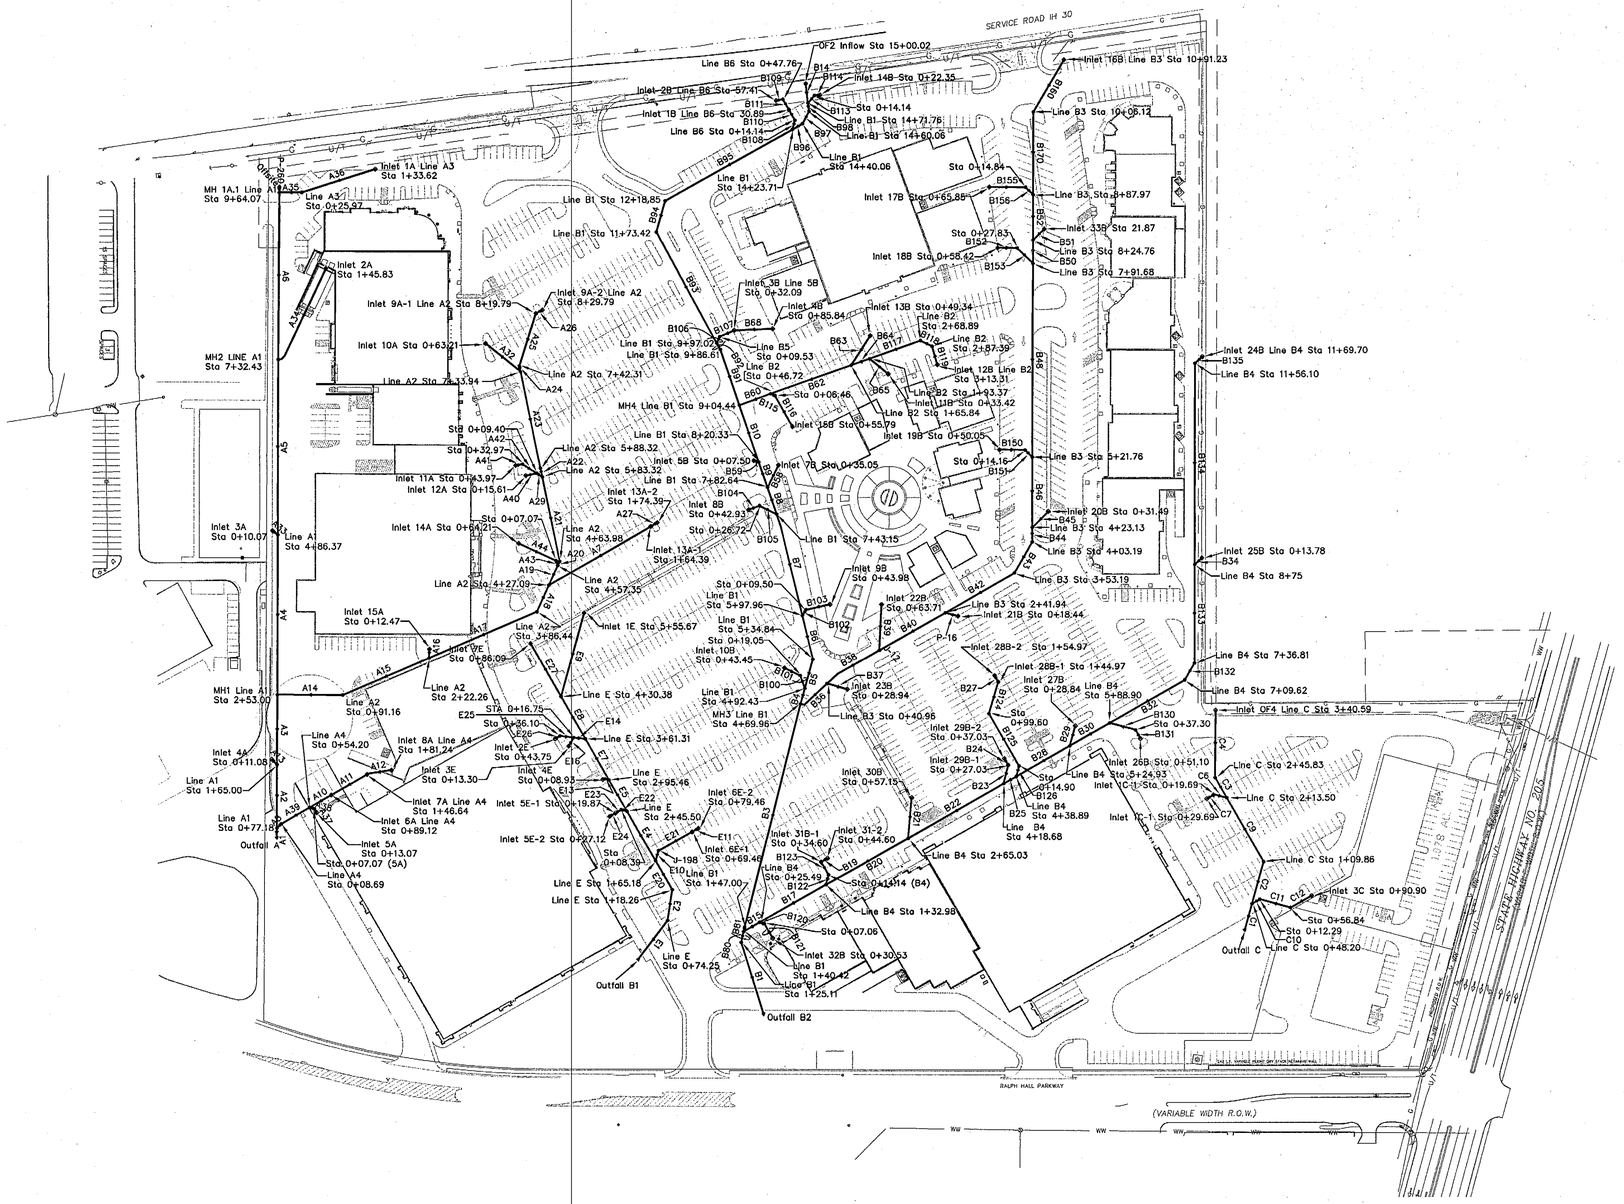

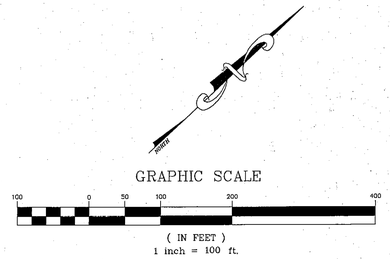

DISCLAIMER

TO THE BEST OF OUR KNOWLEDGE, THE WALLACE GROUP, INC. HEREBY STATES THAT THIS PLAN IS AS-BUILT/RECORD DRAWINGS. THE INFORMATION PROVIDED IS BASED ON SURVEYING CONDUCTED AT THE SITE AND INFORMATION PROVIDED BY THE CONTRACTOR.

REV	DATE	BY	DESCRIPTION

TEXAS ONE CALL SYSTEM 800-245-4545 STOP-CALL BEFORE YOU DIG!

DESIGNED: RDC
DRAWN: FM
CHECKED: RS

STATE OF TEXAS MATTHEW D. MORGAN 96329 LICENSED PROFESSIONAL ENGINEER

"THE SEAL APPEARING ON THIS DOCUMENT WAS AUTHORIZED BY MATTHEW D. MORGAN, P.E. # 95329
ON THE DATE SHOWN ON THE DAYSTAMP.
ALTERATION OF A SEALED DOCUMENT WITHOUT PROPER NOTIFICATION TO THE RESPONSIBLE ENGINEER IS AN OFFENSE UNDER THE TEXAS ENGINEERING PRACTICE ACT"

3/25/08 — DATE
Matt D. Morgan — NAME

ENGINEERS ARCHITECTS
THE WALLACE GROUP INC.
SURVEYORS PLANNERS

THE WOODMONT COMPANY

PLAZA AT ROCKWALL

STORM SEWER NETWORK PLAN

SHEET 50
C5.19
OF 56 SHEETS

G:\Projects\18358\Dwg\AS-BUILT\18358-AB_CS19-CS20-HYDRAULIC-DATA.dwg, NETWORK PLAN (C5.19), 2/28/2008 4:16:59 PM, mys, Xerox_Hybrid.pc3, 1:1