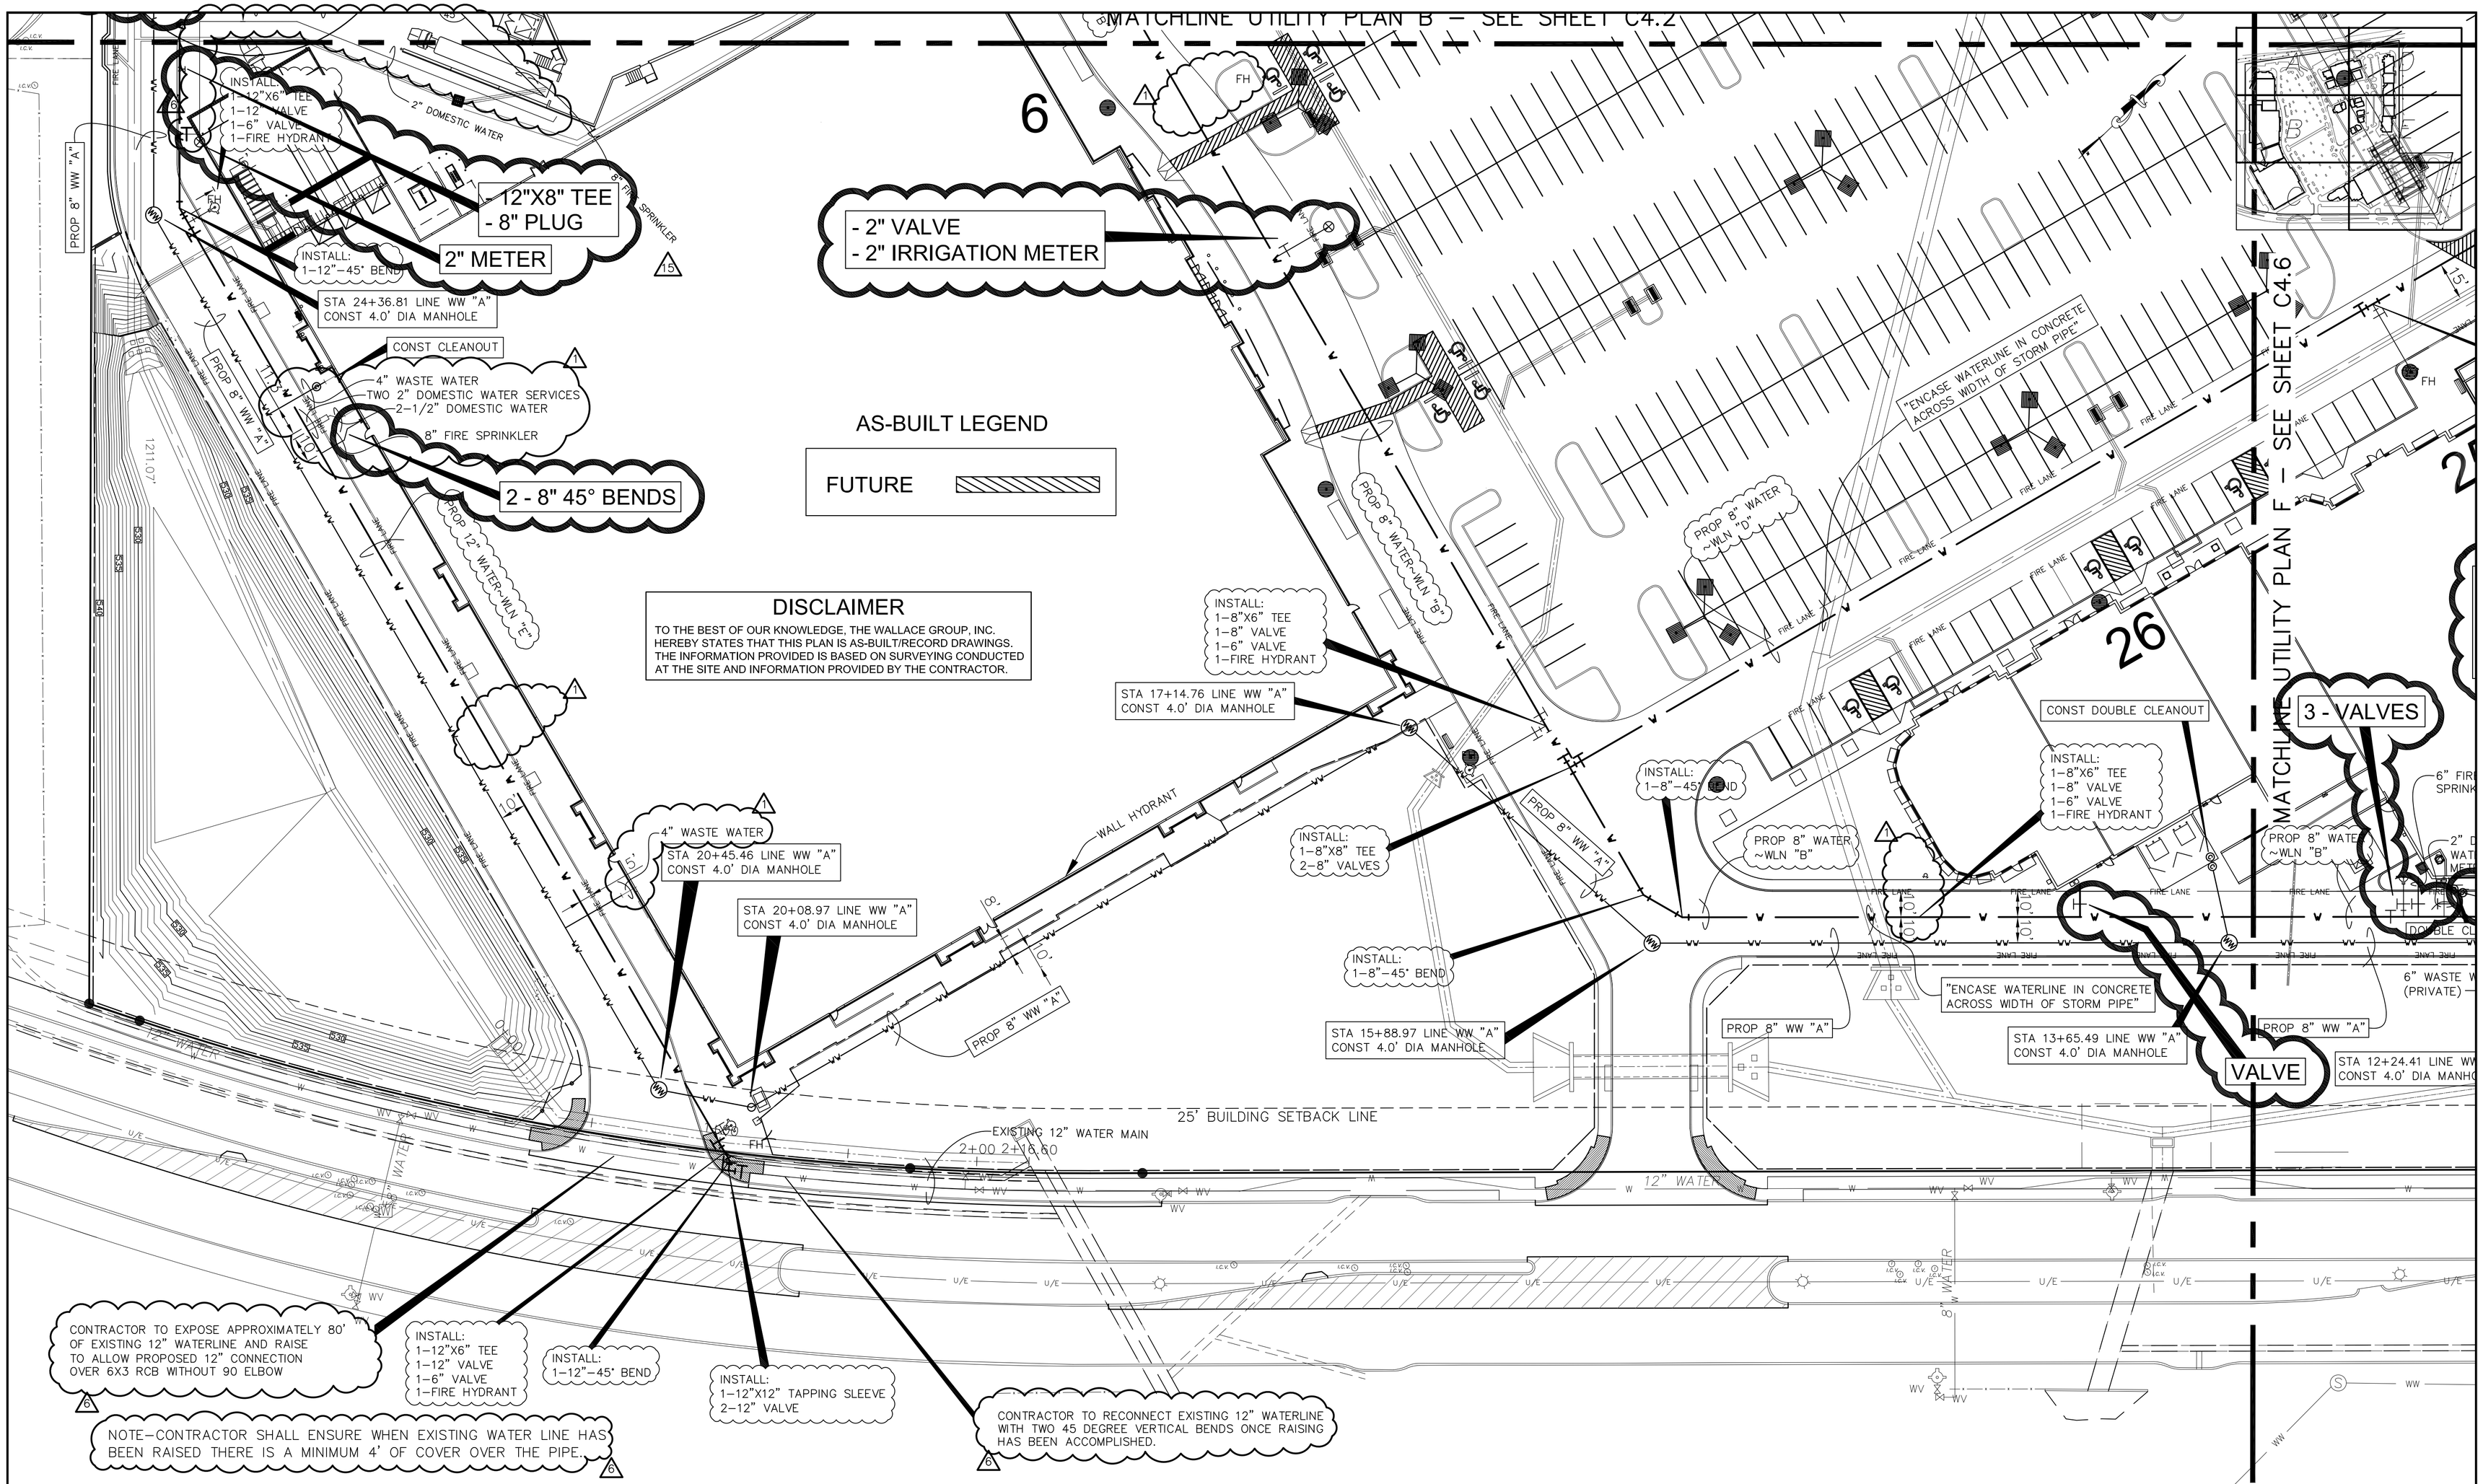

REV	DATE	BY	DESCRIPTION
4	6–8–07	MM	Revised 8" Fire line and 2" Domestic Service to Staples
3	5–25–07	RSJ	Revised 8" Fire line and 2" Domestic Service to Staples
2	3–30–07	MM	Revised existing waterline on Ralph Hall to get over proposed 6'x3' RCB
1	2–19–07	RSJ	Revised utility service connections & removed Fire Hydrants

TEXAS ONE CALL SYSTEM 1-800-245-4545 STOP-CALL BEFORE YOU DIG!

0 15 30 60 (IN FEET)

DESIGNED: ____
DRAWN: ____
CHECKED: ____

"THE SEAL APPEARING ON THIS DOCUMENT WAS AUTHORIZED BY MATTHEW D. MORGAN, P.E. # 96329 ON THE DATE SHOWN ON THE DAYSTAMP. ALTERATION OF A SEALED DOCUMENT WITHOUT PROPER NOTIFICATION TO THE RESPONSIBLE ENGINEER IS AN OFFENSE UNDER THE TEXAS ENGINEERING PRACTICE ACT"

DATE NAME

ENGINEERS SURVEYORS ARCHITECTS PLANNERS

THE WALLACE GROUP INC.

THE WOODMONT COMPANY

PLAZA AT ROCKWALL

UTILITY PLAN C

SHEET 24

C4.3

OF 56 SHEETS