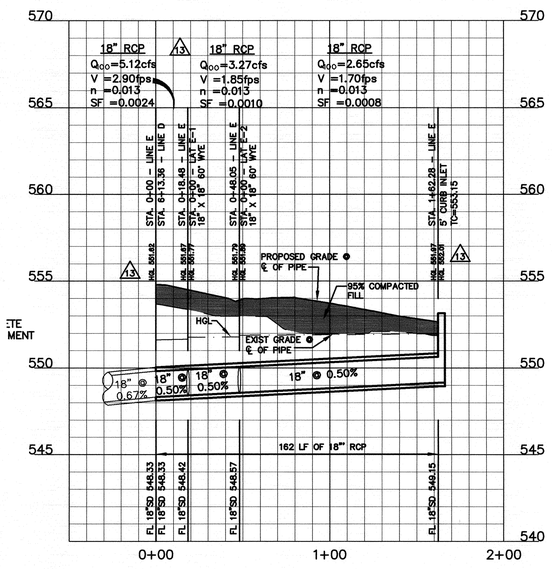

Line 'E'

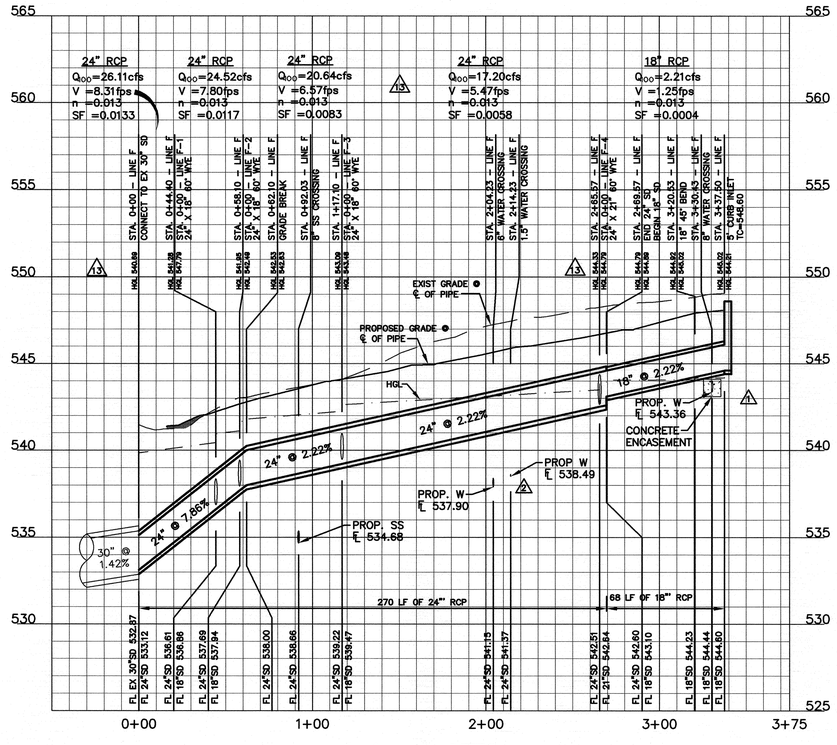

Line 'F'

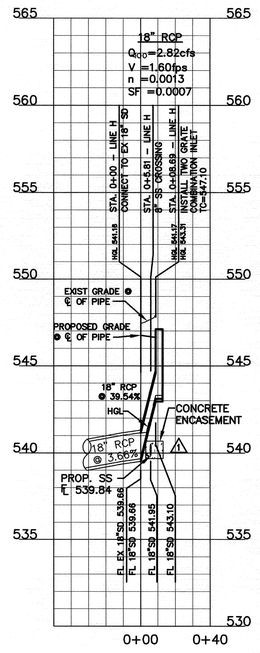

Line 'H'

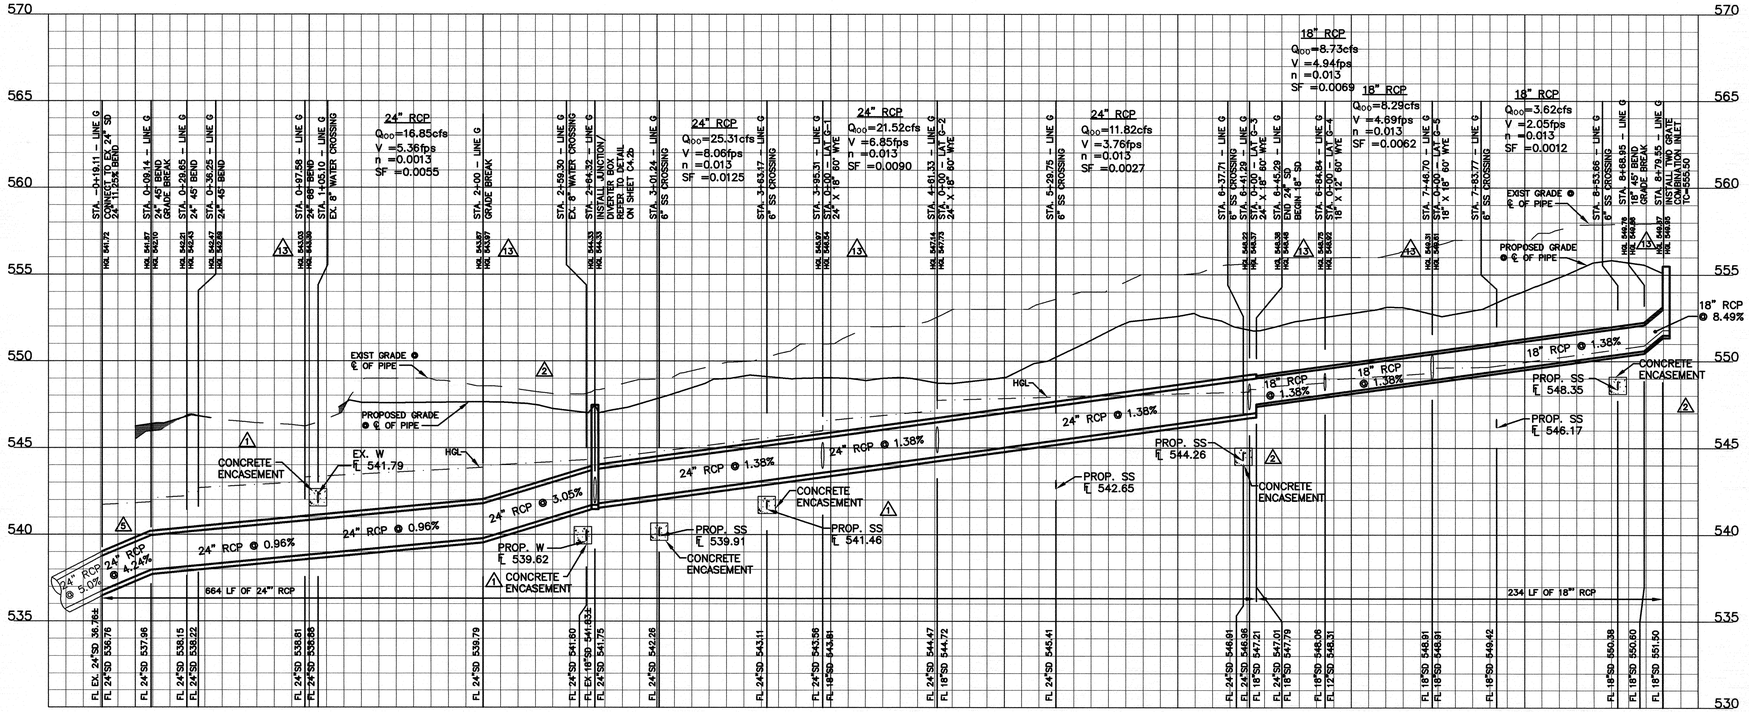

Line 'G'

CAUTION !!

CONTRACTOR IS TO CONTACT TEXAS ONE-CALL SYSTEM (1-800-245-4545) OR OTHER UTILITY LOCATING SERVICES AT LEAST 48 HOURS PRIOR TO CONSTRUCTION ACTIVITIES. BURY & PARTNERS IS NOT RESPONSIBLE FOR KNOWING ALL EXISTING UTILITIES IN THE PROJECT AREA NOR FOR DEPICTING THE EXACT LOCATIONS OF UTILITIES ON THESE DRAWINGS.

ALL RESPONSIBILITY FOR ADEQUACY OF DESIGN REMAINS WITH THE DESIGN ENGINEER. THE CITY OF ROCKWALL, IN REVIEWING AND RELEASING PLANS FOR CONSTRUCTION, ASSUMES NO RESPONSIBILITY FOR ADEQUACY OR ACCURACY OF DESIGN.

RECORD DRAWINGS:
THE INTENT OF THE OWNER AND ENGINEER WAS TO CONSTRUCT THE FACILITIES ACCORDING TO THESE PLANS AS APPROVED BY THE CITY OR GOVERNING AUTHORITY. TO THE BEST OF THE ENGINEERS KNOWLEDGE THE PLANS REFLECT REVISIONS MADE DURING CONSTRUCTION BASED ON A VISUAL SITE OBSERVATION BY THE ENGINEER AND INFORMATION PROVIDED BY:
W.B. KIBLER CONSTRUCTION CO, LTD
9722 ABERNATHY
DALLAS, TEXAS 75220
CONTACT: PHIL GULSVIG

0 20 40 60 80
1"=40' HORIZ.

0 2 4 6 8
1"=4' VERT.

ARCHITECT:
RUNYON Architects AND ASSOCIATES INC
2508 HIGHLANDER WAY, SUITE 100
CARROLLTON, TEXAS 75006
972-233-7705
WWW.RUNYONARCH.COM

M.E.P. ENGINEER:
ROBERT D. ANDERSON, INC.
11836 Judd Court, Inc.
Dallas, Texas 75243
T 972.669.0915 F 972.669.0917

LANDSCAPE ARCHITECT:
T.H. PRITCHETT / Associates
Landscape Architects
1218 Camino Lago
Irving, Texas 75039
T 972.869.3535 F 214.697.2580

STRUCTURAL ENGINEER:
HUNT & JOINER
1825 Market Center Blvd.
Suite 620
Dallas, Texas 75207
T 214.760.7000 F 214.760.7050

CIVIL ENGINEER:
Bury+Partners ENGINEERING SOLUTIONS
5310 Harvest Hill Road, Suite 100
Dallas, Texas 75230
Tel. (972)991-0011 Fax (972)991-0278
Texas Registration #F-1046

ROCKWALL PLAZA PHASE II

SHELL BUILDINGS 10-15
ROCKWALL, TEXAS 75087

△	ISSUE	DATE	DESCRIPTION
1	JAM	09/09/10	ADDENDUM #1
2	JAM	09/27/10	CITY COMMENTS
5	JAM	11/19/10	RFI#6 & RFI #7
12	JAM	05/13/11	AS BUILT DRAWINGS
13	JAM	09/29/11	OLIVE GARDEN
14	JAM	09/30/11	AS BUILT DRAWINGS (OLIVE GARDEN DRAINAGE)

RAA Project # : 1010
Project Manager : MWL

STATE OF TEXAS
JOSHUA A. MILLSAP
100118
LICENSED
PROFESSIONAL ENGINEER
9/30/11

C4.5

STORM DRAIN PROFILES

F:\(01)08673-30001\08730015\M-PR02.dwg modified by jbranch at Sep 30, 2011 - 9:18am