


- = WATER SERVICE CONNECTION
- = C.O.
- ⊗ = WATER VALVE

250	5467.04	4317.74	450.21	MAG. NAIL
251	5059.87	4894.56	500.85	MAG. NAIL
252	4935.23	4223.68	453.28	MAG. NAIL
253	5118.68	4384.14	453.81	MAG. NAIL
255	4984.16	4747.67	493.94	MAG. NAIL
258	4872.18	4675.18	492.53	MAG. NAIL
855	4838.90	4697.09	0.00	PROP. COR
856	4940.33	4080.19	0.00	PROP. COR
857	5593.13	4207.37	0.00	PROP. COR
859	5052.14	4764.48	0.00	PROP. COR
860	4948.56	4806.94	0.00	PROP. COR
861	5025.06	4738.19	0.00	PROP. COR

16	5429.26	4334.29	451.10	BC
17	5442.83	4320.82	450.86	BC
18	5120.80	4298.00	444.88	BC
19	5423.94	4317.07	450.81	BC
20	5112.08	4292.83	446.89	BC
21	5124.80	4298.17	448.18	BC
22	5427.08	4328.47	450.82	BC
23	5194.73	4295.80	444.17	BC
24	5182.47	4284.47	444.39	BC
25	5194.73	4295.80	444.17	BC
26	5030.89	4246.80	446.10	BC
27	5038.37	4246.45	446.82	BC
28	5174.09	4283.84	444.02	BC
29	5180.72	4285.04	443.70	BC
30	5077.77	4292.20	445.83	BC
31	5107.73	4280.85	448.87	BC
32	5491.81	4297.07	450.83	BC
33	5032.83	4292.38	443.84	BC
34	5498.80	4270.32	448.81	BC
35	4880.32	4653.32	468.87	BC
36	5021.32	4288.89	447.30	BC
37	5037.90	411.92	446.88	BC
38	5038.49	4225.55	446.72	BC
39	5214.34	4292.89	443.89	BC
40	5219.11	4291.87	444.23	BC
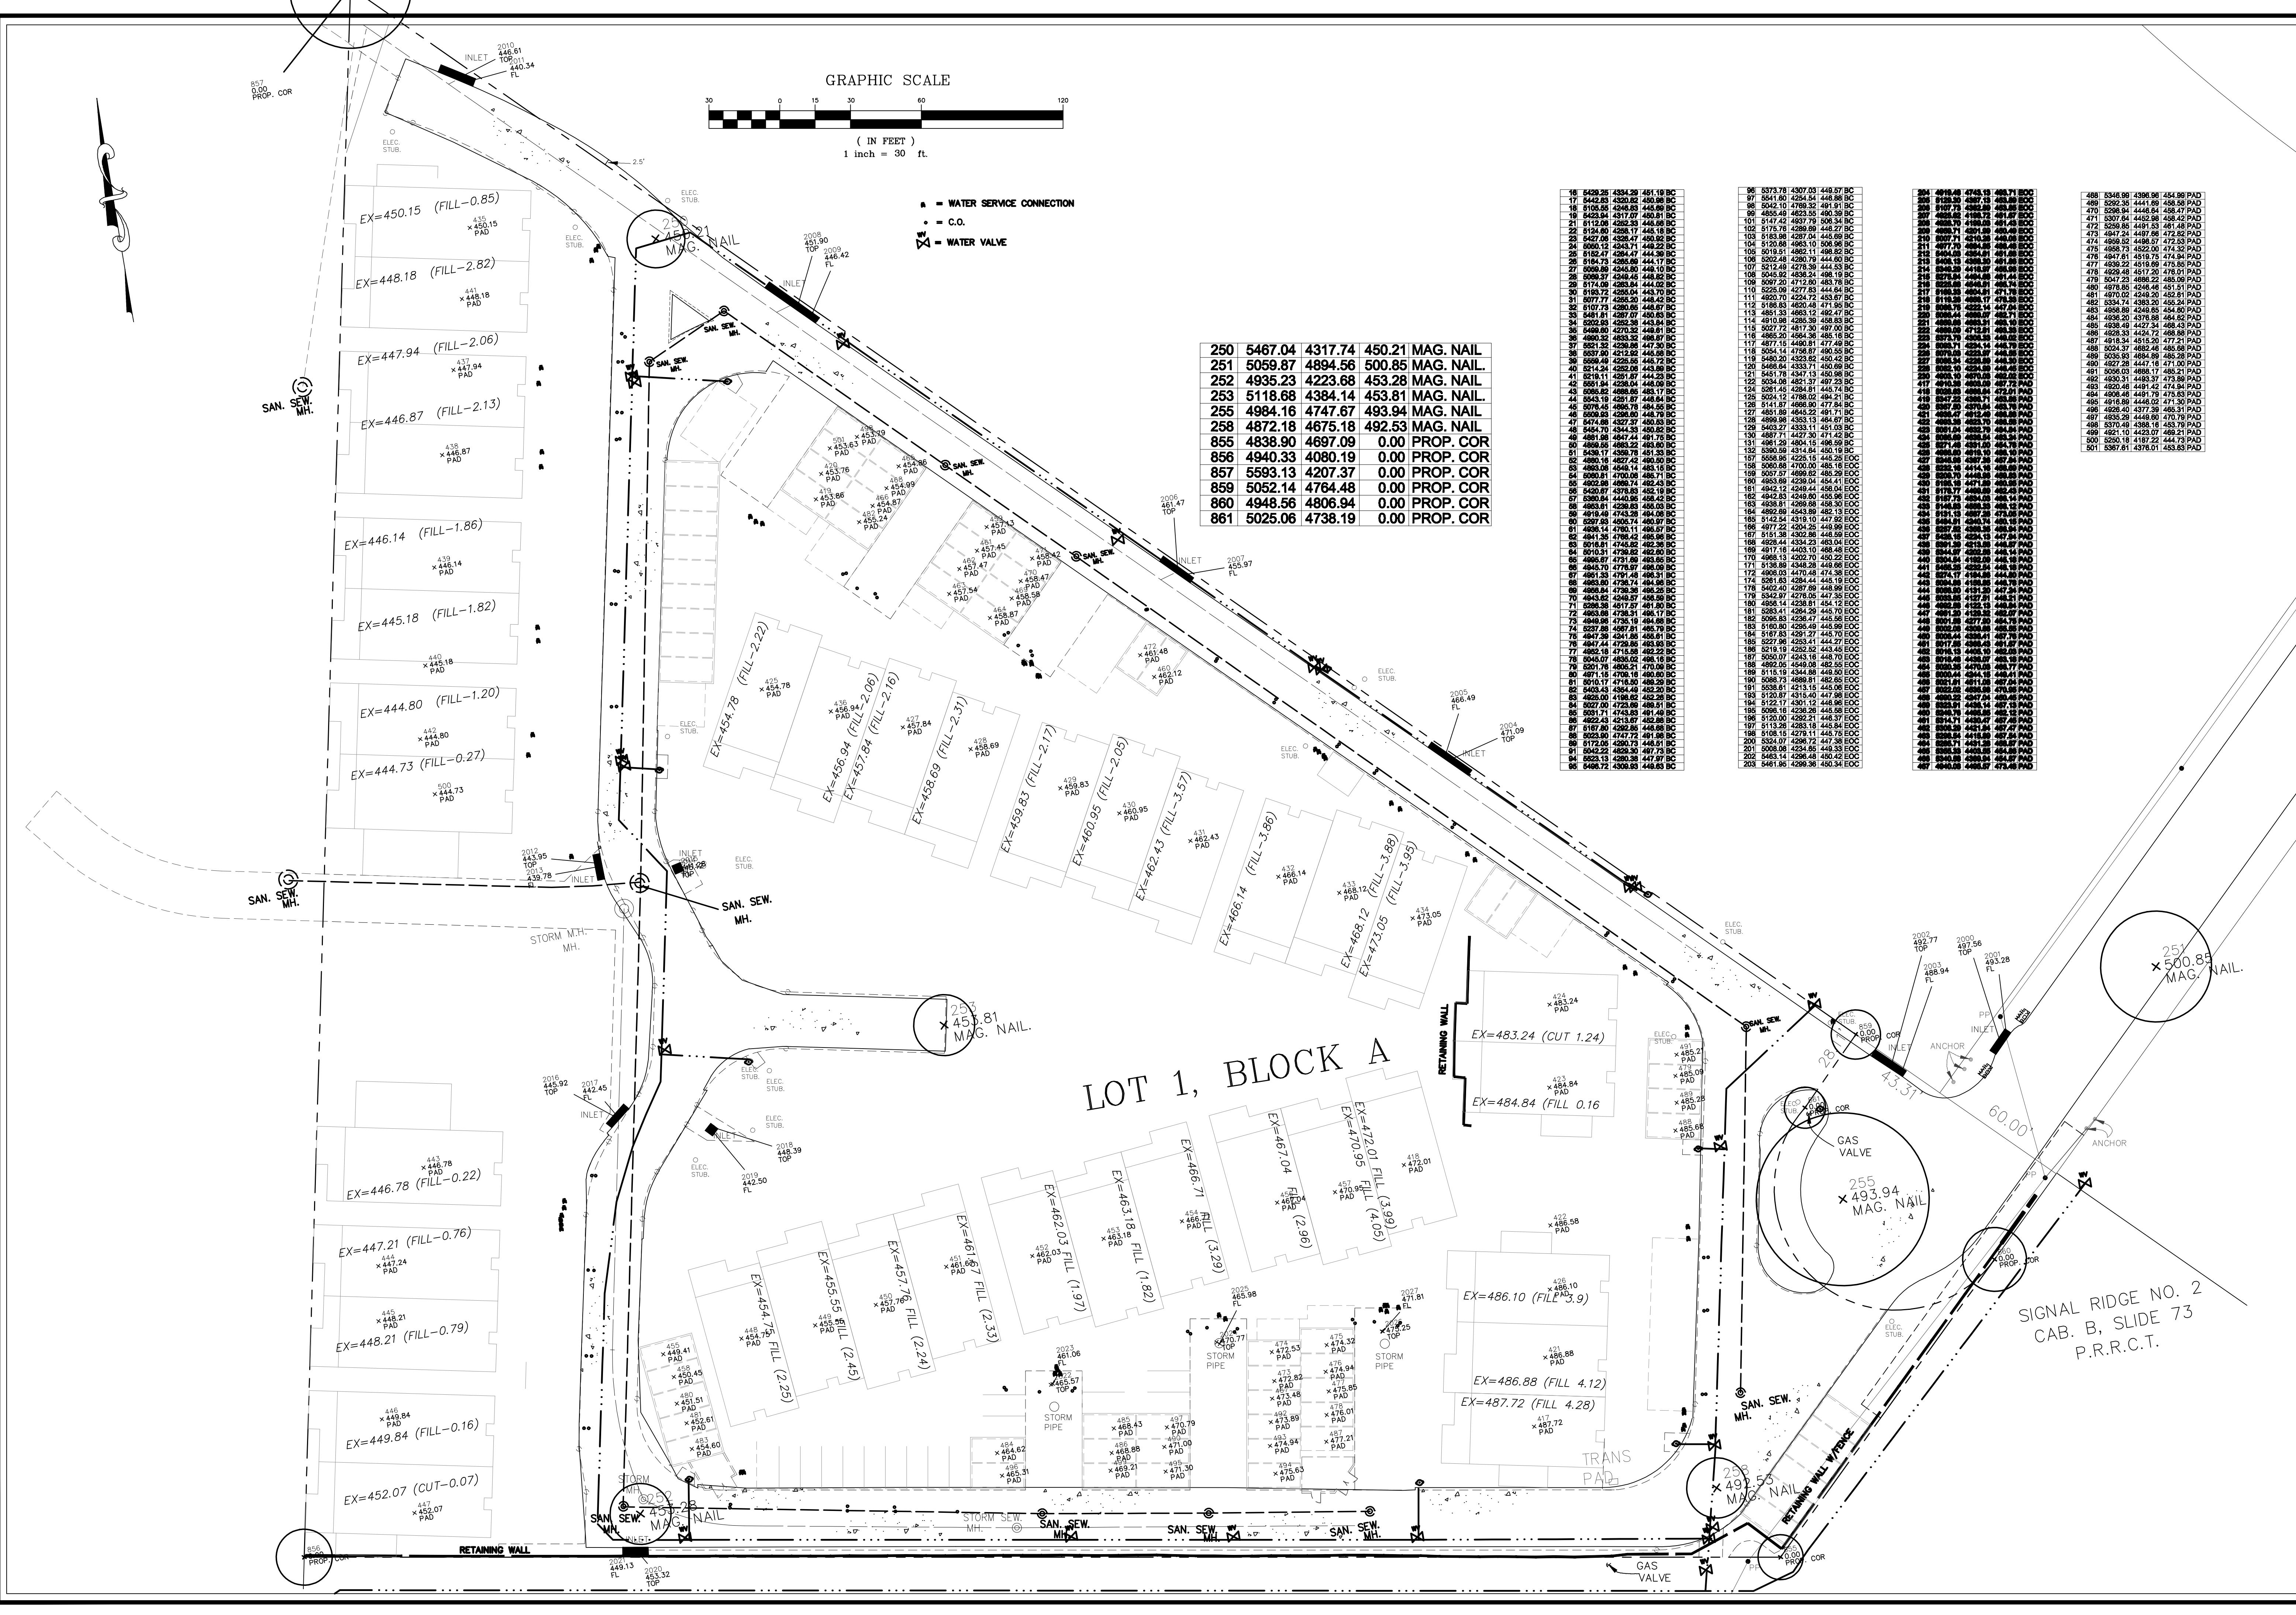

DOUPHRADE & ASSOCIATES, INC.  
 ENGINEERING - PROJECT MANAGEMENT - SURVEYING  
 2235 RIDGE RD., # 200 ROCKWALL, TEXAS 75087  
 PHONE: (972)771-9004 FAX: (972)771-9005

PAD & PAVING  
 ASBUILT  
 VILLAS DE PORTOFINO  
 CITY OF ROCKWALL, ROCKWALL COUNTY, TEXAS

REVISION
W.L.D. CHECKED
4/17/03 DATE
9853 AB 4-17-03 PROJECT
1 OF