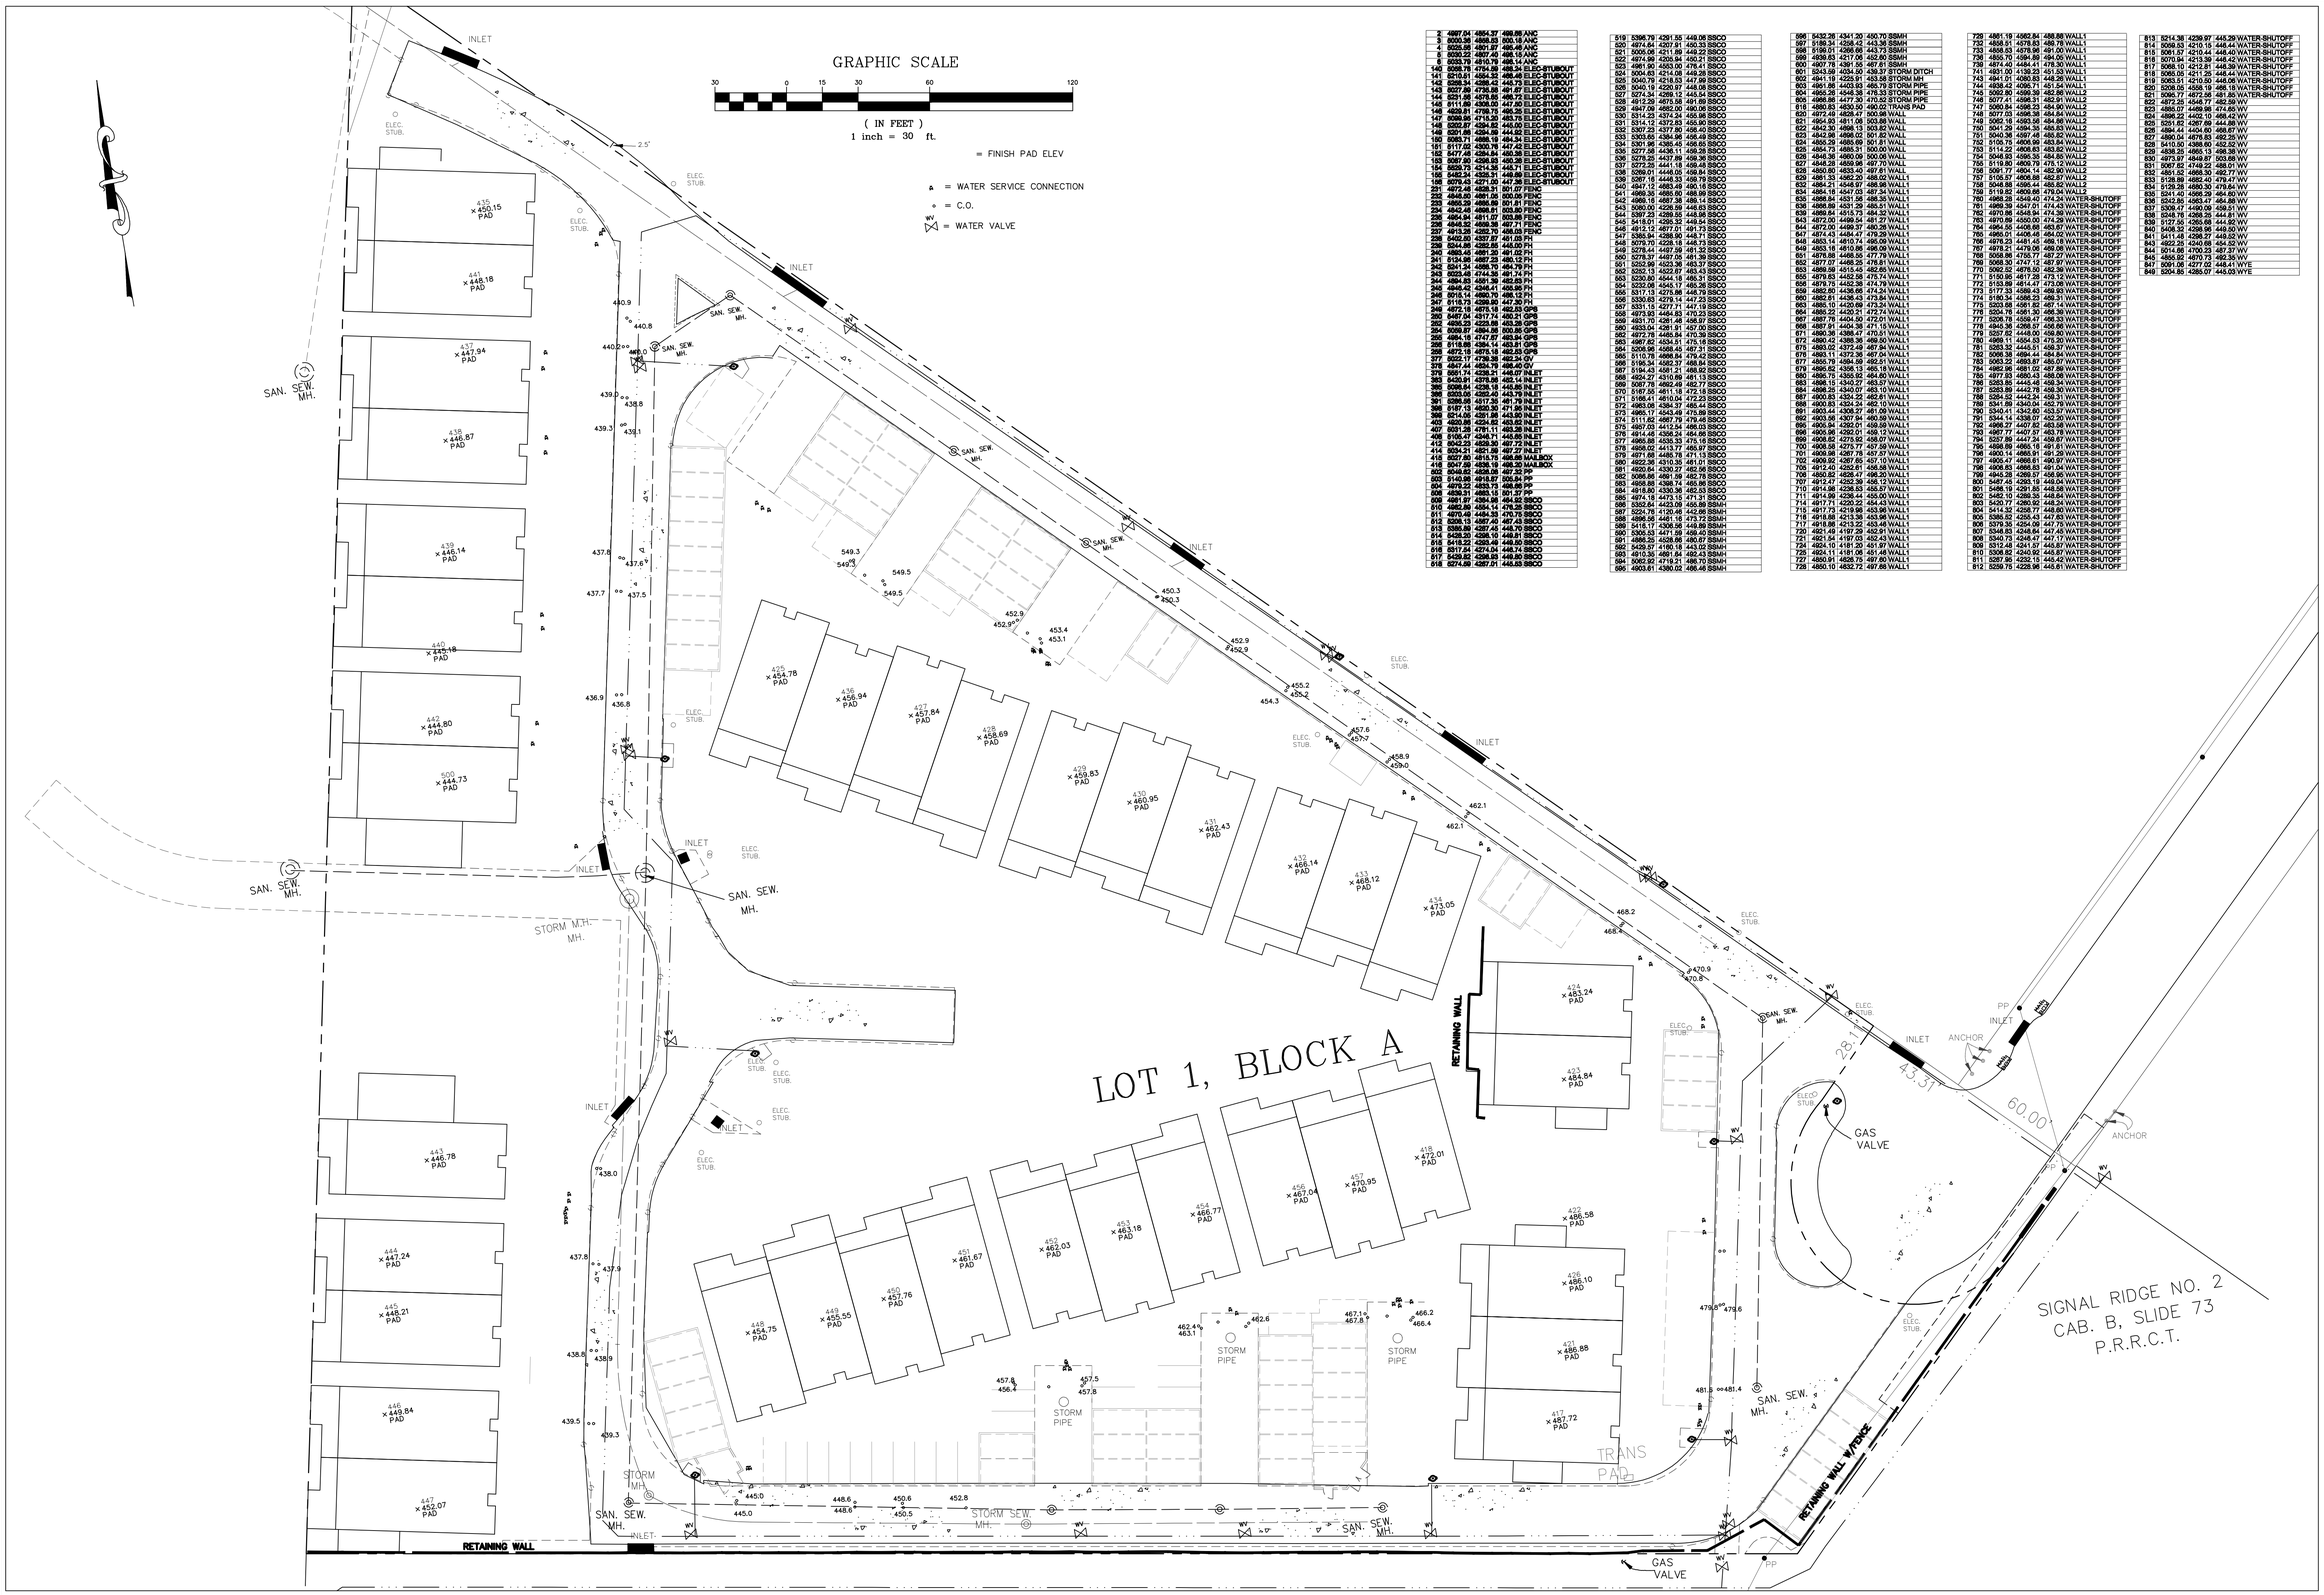

2	4997.04	4854.37	498.88	ANC
3	5000.36	4868.83	500.18	ANC
4	5005.98	4891.07	496.48	ANC
5	5030.22	4887.40	498.18	ANC
6	5033.79	4819.79	498.14	ANC
140	5098.76	4764.88	488.34	ELEC-STUBOUT
141	5210.01	4564.32	486.48	ELEC-STUBOUT
142	5298.34	4398.42	483.73	ELEC-STUBOUT
143	5027.69	4738.06	491.97	ELEC-STUBOUT
144	5291.86	4578.85	488.72	ELEC-STUBOUT
145	5139.29	4675.58	491.60	ELEC-STUBOUT
146	4939.81	4798.75	495.35	ELEC-STUBOUT
147	5314.23	4513.28	485.75	ELEC-STUBOUT
148	5302.87	4384.52	440.00	ELEC-STUBOUT
149	5291.66	4364.99	444.92	ELEC-STUBOUT
150	5083.71	4668.18	484.34	ELEC-STUBOUT
151	5117.02	4639.74	447.42	ELEC-STUBOUT
152	5477.46	4384.34	480.38	ELEC-STUBOUT
153	5287.80	4398.65	480.36	ELEC-STUBOUT
154	5525.73	4314.38	448.71	ELEC-STUBOUT
156	5482.24	4325.11	448.96	ELEC-STUBOUT
188	5079.45	4571.00	447.38	ELEC-STUBOUT
231	4972.46	4838.31	501.07	FENC
232	4846.80	4891.06	500.06	FENC
233	4868.29	4896.69	501.81	FENC
234	4842.46	4868.81	503.80	FENC
235	4864.94	4867.01	503.80	FENC
236	4848.32	4849.38	497.71	FENC
237	4912.12	4877.01	498.03	FENC
238	5402.80	4937.37	491.05	PH
239	5275.21	4937.69	490.38	PH
240	5265.45	4891.20	491.02	PH
241	5278.37	4487.05	491.39	PH
242	5241.24	4868.76	491.79	PH
243	5252.99	4744.86	491.74	PH
244	4864.83	4891.36	492.65	PH
245	4864.47	4844.79	492.21	PH
246	5016.14	4890.70	488.12	PH
247	5012.12	4875.16	488.12	PH
248	5072.12	4875.16	492.53	GPB
250	5497.24	4317.16	493.21	GPB
252	4866.07	4404.36	477.11	GPB
254	5399.11	4317.09	500.66	GPB
256	5494.14	4747.09	493.21	GPB
258	5118.66	4384.14	493.61	GPB
259	4972.18	4875.16	492.53	GPB
377	5022.17	4739.36	492.34	GV
378	4947.47	4854.79	492.34	GV
379	5691.74	4338.31	448.07	INLET
382	5430.37	4376.08	451.14	INLET
385	5098.84	4338.18	445.66	INLET
389	5025.20	4295.40	443.78	INLET
391	5386.95	4917.30	491.76	INLET
392	5187.13	4820.30	491.96	INLET
398	5214.06	4351.86	443.60	INLET
403	4924.20	4324.63	443.62	INLET
407	5531.26	4791.11	493.38	INLET
408	5244.05	4948.13	492.72	INLET
412	5042.23	4828.30	497.72	INLET
414	5034.31	4814.39	497.72	INLET
418	5027.80	4815.75	498.66	MAILBOX
419	5023.84	4806.08	498.66	MAILBOX
502	5546.82	4838.06	497.57	PP
503	5146.88	4838.06	493.84	PP
504	4879.22	4853.73	496.60	PP
508	4838.31	4883.18	501.97	PP
509	4961.97	4894.96	494.62	SSCO
510	4962.07	4894.96	476.35	SSCO
511	4870.46	4484.35	470.75	SSCO
512	5208.13	4487.49	467.43	SSCO
513	5386.80	4287.45	448.70	SSCO
514	5386.80	4287.45	449.81	SSCO
515	5418.22	4288.46	449.82	SSCO
516	5517.24	4274.04	449.74	SSCO
517	5429.82	4298.95	449.85	SSCO
518	5274.89	4297.71	449.58	SSCO
519	5396.79	4291.55	449.08	SSCO
520	4974.54	4207.91	490.33	SSCO
521	5005.06	4211.89	449.22	SSCO
522	4974.99	4205.94	490.21	SSCO
523	4961.90	4553.00	478.41	SSCO
524	5004.83	4214.08	449.28	SSCO
525	5040.79	4218.53	447.99	SSCO
526	5040.19	4220.97	448.08	SSCO
527	5274.34	4289.12	448.54	SSCO
528	4912.39	4875.58	491.66	SSCO
529	4947.08	4882.00	490.06	SSCO
530	5314.23	4374.24	455.88	SSCO
531	5314.12	4372.83	455.80	SSCO
532	5307.23	4377.90	448.88	SSCO
533	5303.65	4384.96	458.49	SSCO
534	5301.96	4386.42	458.65	SSCO
535	5277.58	4436.11	459.28	SSCO
536	5278.25	4437.69	458.36	SSCO
537	5272.25	4441.18	459.48	SSCO
538	5269.01	4446.05	459.84	SSCO
539	5267.16	4446.33	459.79	SSCO
540	4947.12	4883.49	490.18	SSCO
541	4969.35	4885.60	488.99	SSCO
542	4968.18	4887.38	488.14	SSCO
543	5080.00	4226.59	446.63	SSCO
544	5307.23	4298.55	448.88	SSCO
545	5418.01	4295.32	449.54	SSCO
546	4912.12	4877.01	491.73	SSCO
547	5385.94	4288.90	448.71	SSCO
548	5079.70	4228.18	448.73	SSCO
549	5278.41	4487.99	481.32	SSCO
550	5278.37	4487.05	481.39	SSCO
551	5252.99	4523.36	483.37	SSCO
552	5252.13	4522.87	483.43	SSCO
553	5230.80	4544.18	485.31	SSCO
554	5232.08	4545.17	485.28	SSCO
555	5317.13	4275.86	448.79	SSCO
556	5330.63	4279.14	447.23	SSCO
557	5331.15	4277.71	447.19	SSCO
558	4973.93	4484.83	470.23	SSCO
559	4931.70	4281.46	458.97	SSCO
560	4833.04	4281.91	457.00	SSCO
561	4972.78	4485.84	470.39	SSCO
562	4967.62	4534.51	475.19	SSCO
564	5206.96	4668.45	487.31	SSCO
565	5110.78	4668.54	479.43	SSCO
566	5196.34	4682.37	488.84	SSCO
567	5194.45	4681.21	488.82	SSCO
568	4924.27	4310.89	481.13	SSCO
569	5067.78	4862.48	482.77	SSCO
570	5187.55	4611.18	472.18	SSCO
571	5186.41	4610.53	472.20	SSCO
572	4983.08	4384.37	485.44	SSCO
573	4965.17	4343.48	470.88	SSCO
574	5111.82	4687.79	479.48	SSCO
575	4957.03	4412.28	481.02	SSCO
576	4914.46	4356.24	484.66	SSCO
577	4965.88	4335.53	475.18	SSCO
578	4968.02	4413.77	485.97	SSCO
579	4971.68	4421.58	485.97	SSCO
580	4922.36	4310.35	481.01	SSCO
581	4920.84	4330.27	481.02	SSCO
582	5066.86	4691.59	482.78	SSCO
583	4968.68	4398.15	485.84	SSCO
584	4918.80	3330.36	482.53	SSCO
585	4974.14	4473.71	471.31	SSCO
586	5352.84	4423.09	455.88	SSMH
587	5251.11	4120.24	442.66	SSMH
588	4896.59	4481.16	473.72	SSMH
589	5416.81	4308.94	449.88	SSMH
590	5305.53	4411.99	458.49	SSMH
591	4886.52	4328.88	485.84	SSMH
592	5429.57	4160.18	443.02	SSMH
593	4910.36	4861.14	482.42	SSMH
594	5062.57	4716.21	486.70	SSMH
595	4903.61	4380.02	486.48	SSMH
596	5452.36	4341.20	450.70	SSMH
597	5186.34	4238.42	443.36	SSMH
598	5186.01	4238.08	443.70	SSMH
599	4938.37	4317.06	452.80	SSMH
600	4897.78	4361.55	487.67	SSMH
601	5243.99	4304.00	439.37	STORM DITCH
602	4941.19	4225.91	453.58	STORM MH
603	4961.98	4403.88	493.70	STORM PIPE
604	4956.26	4546.38	476.33	STORM PIPE
605	4938.29	4497.91	470.33	STORM PIPE
618	4880.83	4830.50	490.02	THANS PAD
620	4972.46	4838.47	500.96	WALL
621	4964.93	4811.08	503.88	WALL
622	4942.50	4898.13	503.87	WALL
623	4842.98	4898.02	501.82	WALL
624	4856.29	4889.69	501.81	WALL
625	4864.73	4885.31	500.00	WALL
626	4848.28	4859.96	500.00	WALL
627	4848.28	4859.96	497.70	WALL
628	4850.80	4833.40	497.61	WALL
629	4861.33	4862.20	488.02	WALL
630	4864.21	4848.97	488.96	WALL
631	4864.18	4847.03	487.34	WALL
632	4868.54	4831.58	488.33	WALL
633	4866.89	4831.29	485.51	WALL
634	4869.54	4816.73	484.32	WALL
635	4872.00	4499.54	481.27	WALL
636	4872.00	4499.37	480.39	WALL
637	4874.43	4484.47	479.29	WALL
638	4883.14	4810.74	486.09	WALL
639	4883.18	4810.86	496.09	WALL
651	4876.88	4488.55	477.78	WALL
652	4877.07	4488.25	476.81	WALL
653	4868.59	4815.45	482.60	WALL
655	4879.83	4482.58	475.74	WALL
658	4879.79	4482.38	474.78	WALL
659	4882.80	4436.66	474.24	WALL
660	4882.61	4436.43	473.84	WALL
663	4886.10	4420.69	473.24	WALL
664	4886.12	4420.51	472.74	WALL
667	4887.76	4404.50	472.01	WALL
668	4887.91	4404.36	471.10	WALL
671	4890.36	4388.47	470.51	WALL
672	4890.42	4388.36	469.50	WALL
675	4893.02	4372.48	467.94	WALL
676	4893.11	4372.36	467.04	WALL
677	4895.79	4884.59	492.51	WALL
679	4896.02	4358.13	465.18	WALL
680	4896.75	4356.92	464.60	WALL
683	4898.15	4340.07	463.37	WALL
684	4898.35	4340.07	463.10	WALL
687	4900.83	4324.24	462.61	WALL
688	4900.83	4324.24	462.10	WALL
691	4903.44	4308.37	461.00	WALL
692	4903.56	4307.94	460.59	WALL
695	4906.02	4292.07	459.08	WALL
696	4906.96	4292.01	458.12	WALL
699	4908.58	4275.62	458.07	WALL
700	4908.58	4275.77	457.59	WALL
701	4909.81	4267.78	457.57	WALL
702	4909.92	4267.65	457.10	WALL
705	4912.40	4252.81	456.08	WALL
706	4850.82	4828.47	496.38	WALL
707	4912.27	4252.58	455.11	WALL
710	4914.96	4236.83	455.57	WALL
711	4914.99	4236.44	455.00	WALL
714	4917.71	4220.22	454.43	WALL
715	4917.73	4219.98	453.96	WALL
718	4918.88	4213.39	453.98	WALL
719	4918.88	4213.22	453.48	WALL
720	4921.49	4197.26	452.91	WALL
721	4921.49	4197.03	452.43	WALL
724	4924.10	4181.20	451.97	WALL
725	4924.11	4181.08	451.48	WALL
727	4850.91	4828.75	497.80	WALL
728	4880.10	4832.72	497.86	WALL
730	4891.19	4862.84	488.88	WALL
732	4868.91	4879.83	488.78	WALL
733	4868.83	4879.96	491.00	WALL
735	4850.70	4884.89	494.55	WALL
736	4871.40	4484.41	478.30	WALL
741	4891.01	4139.23	451.53	WALL
743	4941.01	4080.83	448.26	WALL
744	4938.42	4086.71	451.54	WALL
745	5002.80	4996.36	482.88	WALL
746	5077.41	4998.31	482.91	WALL
747	5060.84	4998.23	484.90	WALL
748	5077.03	4998.38	484.90	WALL
749	5062.16	4993.56	484.88	WALL
750	5041.26	4994.34	485.83	WALL
751	5040.36	4997.46	488.82	WALL
752	5106.75	4908.96	483.84	WALL
753	5114.22	4908.63	483.82	WALL
754	5048.83	4995.55	484.80	WALL
755	5119.80	4909.78	478.12	WALL
756	5081.77	4904.14	482.90	WALL
757	5105.57	4906.88	482.87	WALL
758	5048.88	4994.44	485.82	WALL
759	5119.82	4909.66	479.04	WALL
760	4989.28	4549.40	474.24	WATER-SHUTOFF
761	4989.39	4547.01	474.43	WATER-SHUTOFF
762	4970.96	4548.94	474.36	WATER-SHUTOFF
763	4970.89	4500.00	474.29	WATER-SHUTOFF
764	4984.56	4499.88	483.67	WATER-SHUTOFF
765	4985.01	4406.48	484.02	WATER-SHUTOFF
766	4978.23	4481.45	480.18	WATER-SHUTOFF
767	4978.21	4479.06	480.08	WATER-SHUTOFF
768	5068.86	4755.77	487.27	WATER-SHUTOFF
769	5068.30	4747.12	487.97	WATER-SHUTOFF
770	5062.52	4878.50	482.36	WATER-SHUTOFF
771	5100.86	4817.28	473.12	WATER-SHUTOFF
772	5153.89	4814.47	473.06	WATER-SHUTOFF
773	5177.33	4589.43	466.93	WATER-SHUTOFF
774	5180.34	4588.23	466.31	WATER-SHUTOFF
775	5203.68	4581.82	467.14	WATER-SHUTOFF
776	5204.76	4581.30	466.38	WATER-SHUTOFF
777	5206.78	4579.47	466.33	WATER-SHUTOFF
778	4943.36	4268.97	456.66	WATER-SHUTOFF
779	5237.82	4448.00	456.80	WATER-SHUTOFF
780	4968.11	4554.53	473.20	WATER-SHUTOFF
781	5283.32	4445.51	458.37	WATER-SHUTOFF
782	5068.38	4884.44	484.84	WATER-SHUTOFF
783	5063.22	4883.87	486.07	WATER-SHUTOFF
784	4962.96	4891.02	487.86	WATER-SHUTOFF
785	4977.93	4880.43	488.08	WATER-SHUTOFF
786	5353.86	4443.48	458.34	WATER-SHUTOFF
787	5283.86	4442.78	458.30	WATER-SHUTOFF
788	5284.52	4442.34	458.31	WATER-SHUTOFF
789	5341.86	4340.04	453.78	WATER-SHUTOFF
790	5340.41	4342.90	453.57	WATER-SHUTOFF
791	5344.14	4338.07	452.20	WATER-SHUTOFF
792	4966.27	4407.83	465.58	WATER-SHUTOFF
793	4967.77	4407.57	463.78	WATER-SHUTOFF
794	5357.86	4417.34	458.87	WATER-SHUTOFF
795	4898.88	4865.18	491.61	WATER-SHUTOFF
796	4900.14	4866.61	491.26	WATER-SHUTOFF
797	4905.47	4868.61	490.97	WATER-SHUTOFF
798	4908.83	4868.83	491.04	WATER-SHUTOFF
799	4944.58	4269.57	456.95	WATER-SHUTOFF
800	5487.48	4293.19	448.58	WATER-SHUTOFF
801	5488.19	4291.88	448.58	WATER-SHUTOFF
802	5482.10	4288.33	448.54	WATER-SHUTOFF
803	5430.77	4280.92	448.24	WATER-SHUTOFF
804	5414.32	4258.77	448.60	WATER-SHUTOFF
805	5385.52	4255.43	447.83	WATER-SHUTOFF
806	5379.39	4254.08	447.75	WATER-SHUTOFF
807	5348.83	4248.84	447.45	WATER-SHUTOFF
808	5340.73	4248.47	447.17	WATER-SHUTOFF
809	5312.48	4241.57	445.87	WATER-SHUTOFF
810	5308.92	4240.92	445.87	WATER-SHUTOFF
811	5306.56	4232.15	445.42	WATER-SHUTOFF
812	5259.76	4228.96	445.91	WATER-SHUTOFF
813	5214.36	4238.97	445.29	WATER-SHUTOFF
814	5099.53	4210.15	448.44	WATER-SHUTOFF
815	5081.57	4210.44	448.40	WATER-SHUTOFF
816	5070.84	4213.39	448.42	WATER-SHUTOFF
817	5068.10	4212.81	448.39	WATER-SHUTOFF
818	5060.05	4211.25	448.44	WATER-SHUTOFF
819	5063.61	4210.50	448.06	WATER-SHUTOFF
820	5098.06	4208.19	485.18	WATER-SHUTOFF
821	5096.77	4872.56	481.85	WATER-SHUTOFF
822	4872.25	4548.77	482.59	WV
823	4866.07	4469.96	474.65	WV
824	4896.22	4402.10	469.67	WV
825	5251.82	4267.89	444.88	WV
826	4884.44	4404.60	468.67	WV
827	4890.04	4878.83	492.25	WV
828	5410.02	4388.60	452.52	WV
829	4838.25	4865.13	498.38	WV
830	4973.07	4849.87	503.68	WV
831	5067.62	4748.22	488.01	WV
832	4891.02	4868.50	492.71	WV
833	5128.88	4882.40	479.47	WV
834	5129.28	4890.30	479.64	WV
835	5241.40	4868.29	464.60	WV
836	5242.95	4883.47	464.86	WV
837	5308.47	4490.09	459.51	WV
838	5248.79	4288.25	444.61	WV
839	5127.35	4269.68	444.92	WV
840	5408.32	4298.96	449.92	WV
841	5411.48	4298.27	449.62	WV
842	4922.25	4340.68	454.52	WV
844	5014.86	4700.23	487.37	WV
845	4866.02	4870.73	492.39	WV
847	5091.06	4277.02	448.41	WVE
848	5204.85	4285.07	445.03	WVE

DOUPHRATE & ASSOCIATES, INC.
ENGINEERING • PROJECT MANAGEMENT • SURVEYING
2235 RIDGE RD., # 200 ROCKWALL, TEXAS 75087
PHONE: (972)771-9004 FAX: (972)771-9005

UTILITIES & MISIC.
ASBUILT
VILLAS DE PORTOFINO
CITY OF ROCKWALL, ROCKWALL COUNTY, TEXAS

REVISION	
W.L.D.	CHECKED
4/17/03	DATE
9853 AB 4-17-03	PROJECT
1	OF