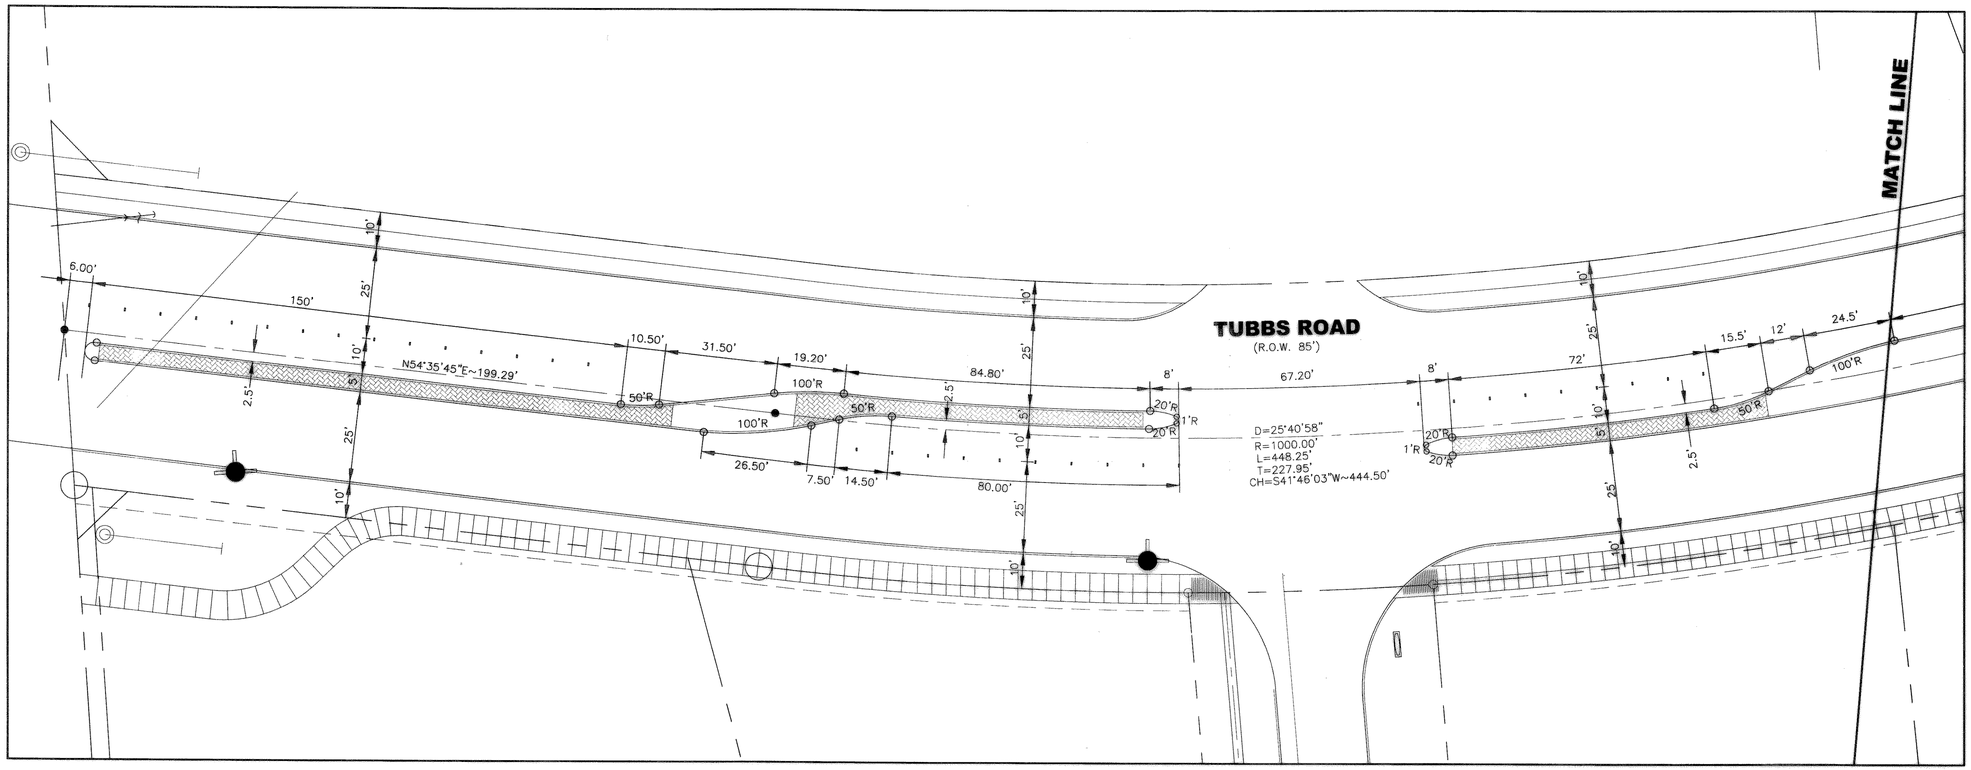

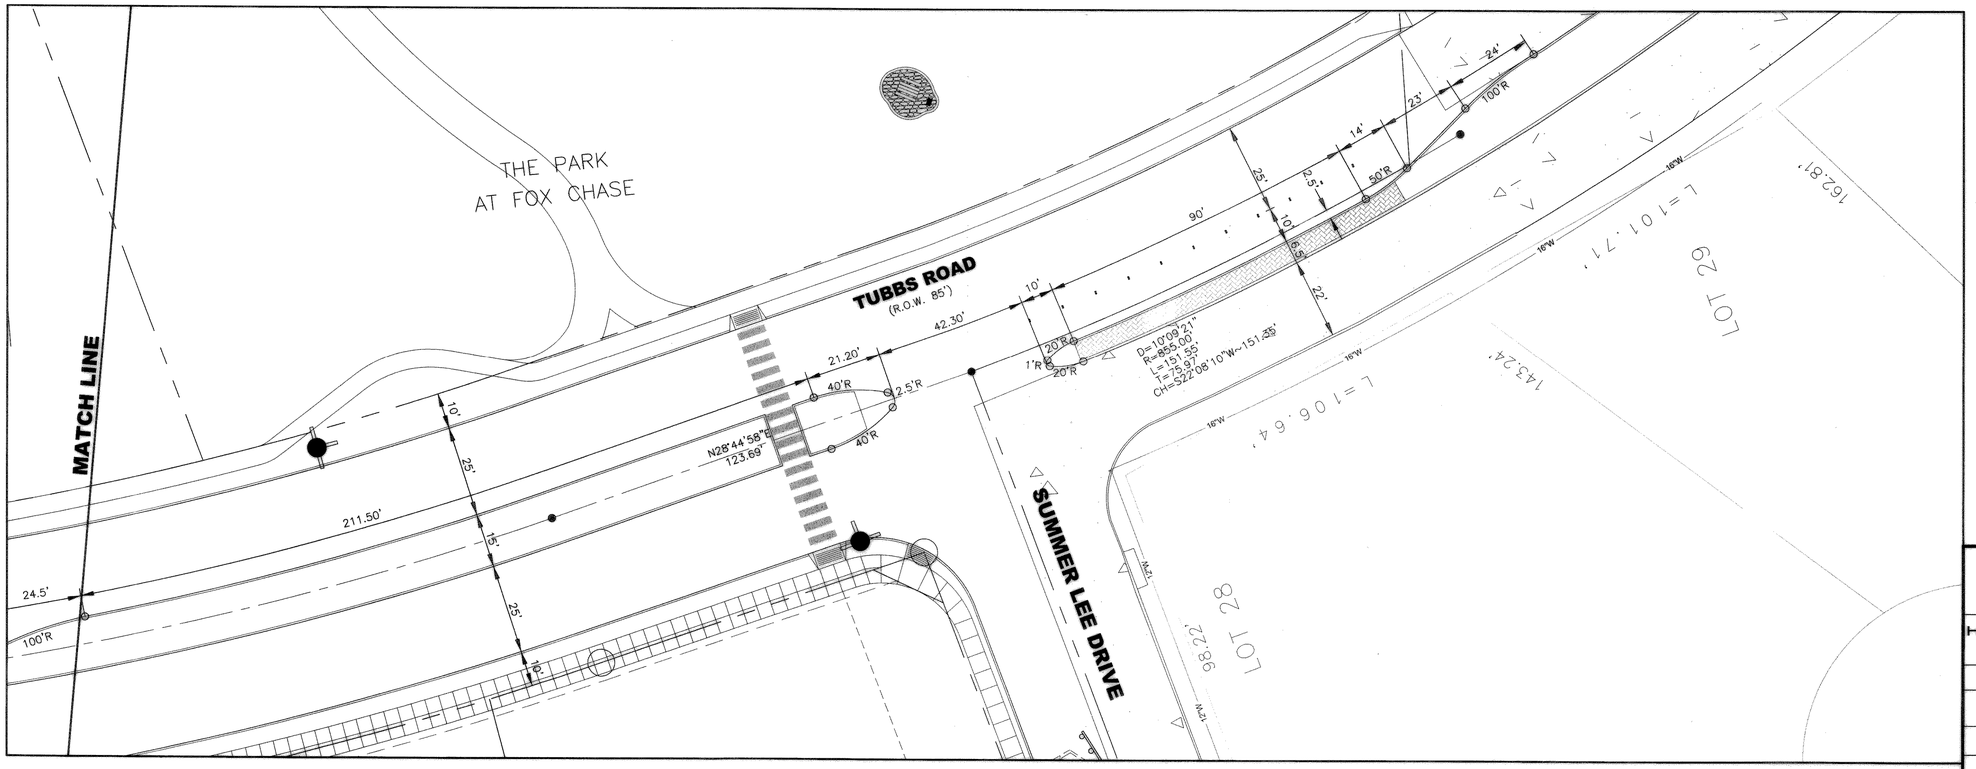

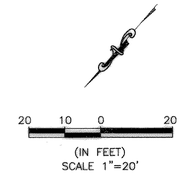

NOTE

DIMENSIONS ARE FACE OF CURB TO FACE OF CURB

AS BUILT

THIS IS TO CERIFY THAT CHANGES AND CORRECTIONS HAVE BEEN MADE TO CONFORM TO THE CONTRACTOR'S RECORD OF THIS PROJECT.

STATE OF TEXAS
NARONGRIT BUTRIENG
97461
06.27.08

TUBBS ROAD PAVING DETAILS

HORIZON ROAD (FM 3097), SUMMER LEE DRIVE, AND TUBBS ROAD IMPROVEMENTS

CITY OF ROCKWALL, TEXAS

PSA ENGINEERING
17819 DAVENPORT ROAD, SUITE 215 DALLAS, TX 75252 (972) 248-9651

DESIGN	DRAWN	DATE	SCALE	CHECK	FILE	NO.
RNB	PSA	06/27/08	AS SHOWN	PSS	2607.PHR	P-2

AS BUILT

Y:\2006\2607.PHR\AS-BUILT\P-2.dwg