STORM SEWER PROFILE - LINE "ST-1"

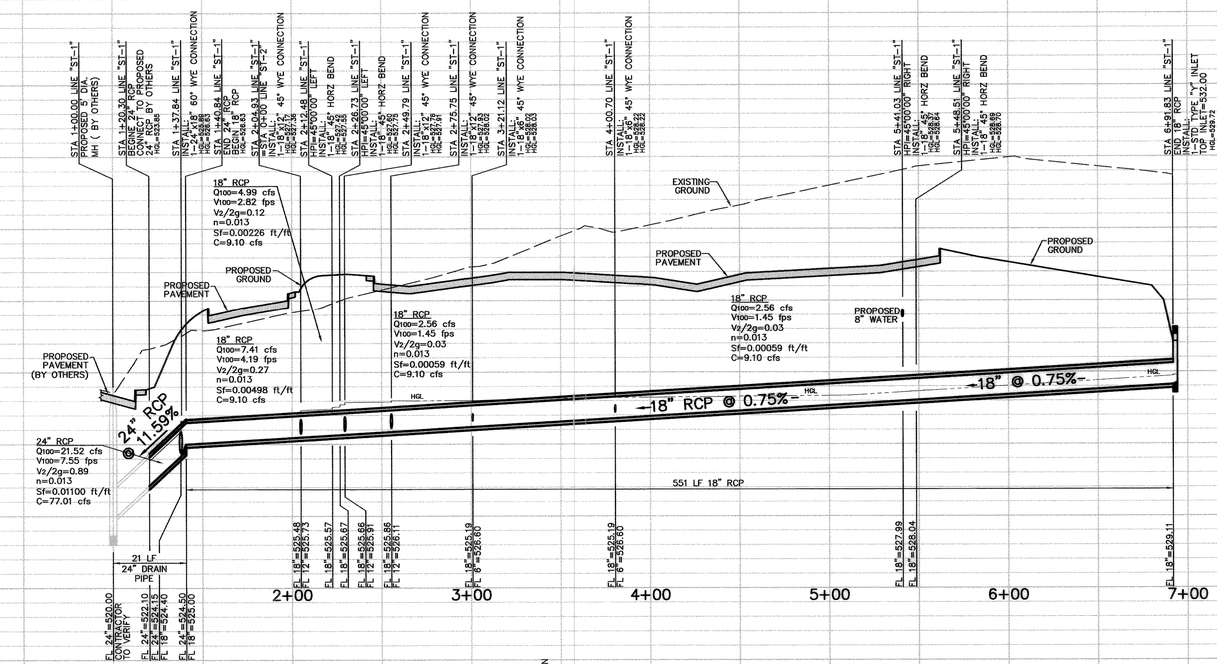

STORM SEWER PROFILE - LINE "ST-3"

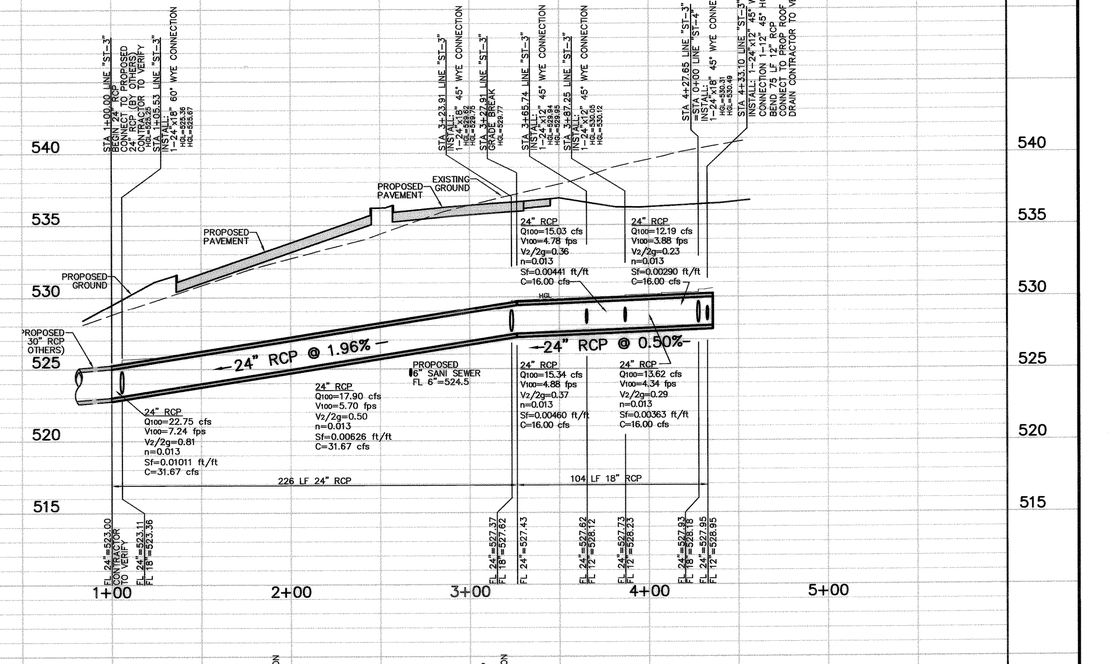

STORM SEWER PROFILE - LINE "ST-4"

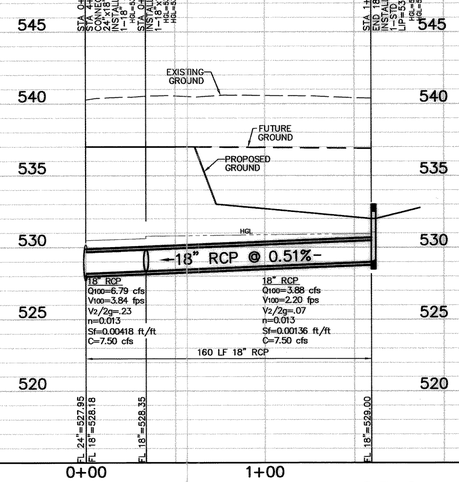

STORM SEWER PROFILE - LINE "ST-5"

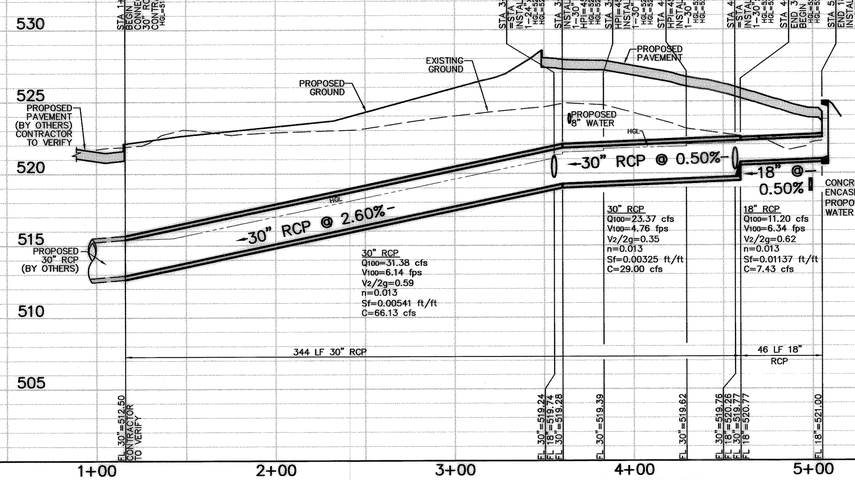

BENCH MARK LIST

BM# 1 CITY OF ROCKWALL MONUMENT "RESET 1"; 3" BRASS DISK FOUND AT RIDGE ROAD (F.M. 740) AND SUMMER LEE DRIVE NEAR THE NORTH WEST CORNER OF THE A PARKING LOT FOR COMMUNITY BANK.
ELEV=567.70

BM# 2 " □ " CUT FOUND ON THE BACK OF CURB ON THE POINT ON CURVATURE OF THE SOUTHWEST CORNER OF THE INTERSECTION OF SUMMER LEE DRIVE AND OAK DRIVE.
ELEV=563.21

BM# 3 " □ " CUT SET ON THE BACK OF CURB AT THE POINT OF CURVE OF ROCKWALL PARKWAY AT THE NORTHEAST CORNER OF THE INTERSECTION OF SUMMER LEE DRIVE AND ROCKWALL PARKWAY.
ELEV=552.82

RECORD DRAWING

THIS DRAWING HAS BEEN REVISED TO REFLECT CONSTRUCTION RECORDS MAINTAINED AND PROVIDED BY THE CONTRACTOR FOR THIS PROJECT. A VISUAL REVIEW OF THE COMPLETED SITE CONSTRUCTION BY PACHECO KOCH, AND FIELD SURVEY VERIFICATION AT MANHOLES AND INLETS BY PACHECO KOCH.

CONTRACTOR: ROGERS-O'BRIEN CONSTRUCTION CO.

DATE REVISED: 11/14/2007

STATE OF TEXAS
ERIK M. HAUGLIE
94736
LICENSED
PROFESSIONAL ENGINEER

THE SEAL APPEARING ON THIS DOCUMENT WAS AUTHORIZED BY ERIK M. HAUGLIE, P.E. 94736 ON 07/17/2006. ALTERATION OF A SEALED DOCUMENT WITHOUT PROPER NOTIFICATION TO THE RESPONSIBLE ENGINEER IS AN OFFENSE UNDER THE TEXAS ENGINEERING PRACTICE ACT.

NO.	DATE	REVISION
2	8/25/2006	REVISED ROOF DRAINS FOR "ST-1" AND "ST-3"

Pacheco Koch Consulting Engineers
8350 N. CENTRAL EXPWY. SUITE 1000 DALLAS, TX. 75206 972.235.3031

STORM SEWER PROFILE

ROCKWALL COMMUNITY HOSPITAL
HORIZON ROAD @ ROCKWALL PARKWAY
EDWARD TEAL SURVEY, ABST. NO. 207
CITY OF ROCKWALL, TEXAS

DESIGN	DRAWN	DATE	SCALE	NOTES	FILE	NO.
EMH	RRL	JULY 2006	1"=40': H 1"=05': V			C4.5

ROCKWALL COMMUNITY HOSPITAL

RLEWIS
OCT 04, 2006 - 9:21AM
M:\DWG-15\1567-05.270\DWG\1567-05-270CV.DWG

DWG FILE: 1567-05-270CV.DWG