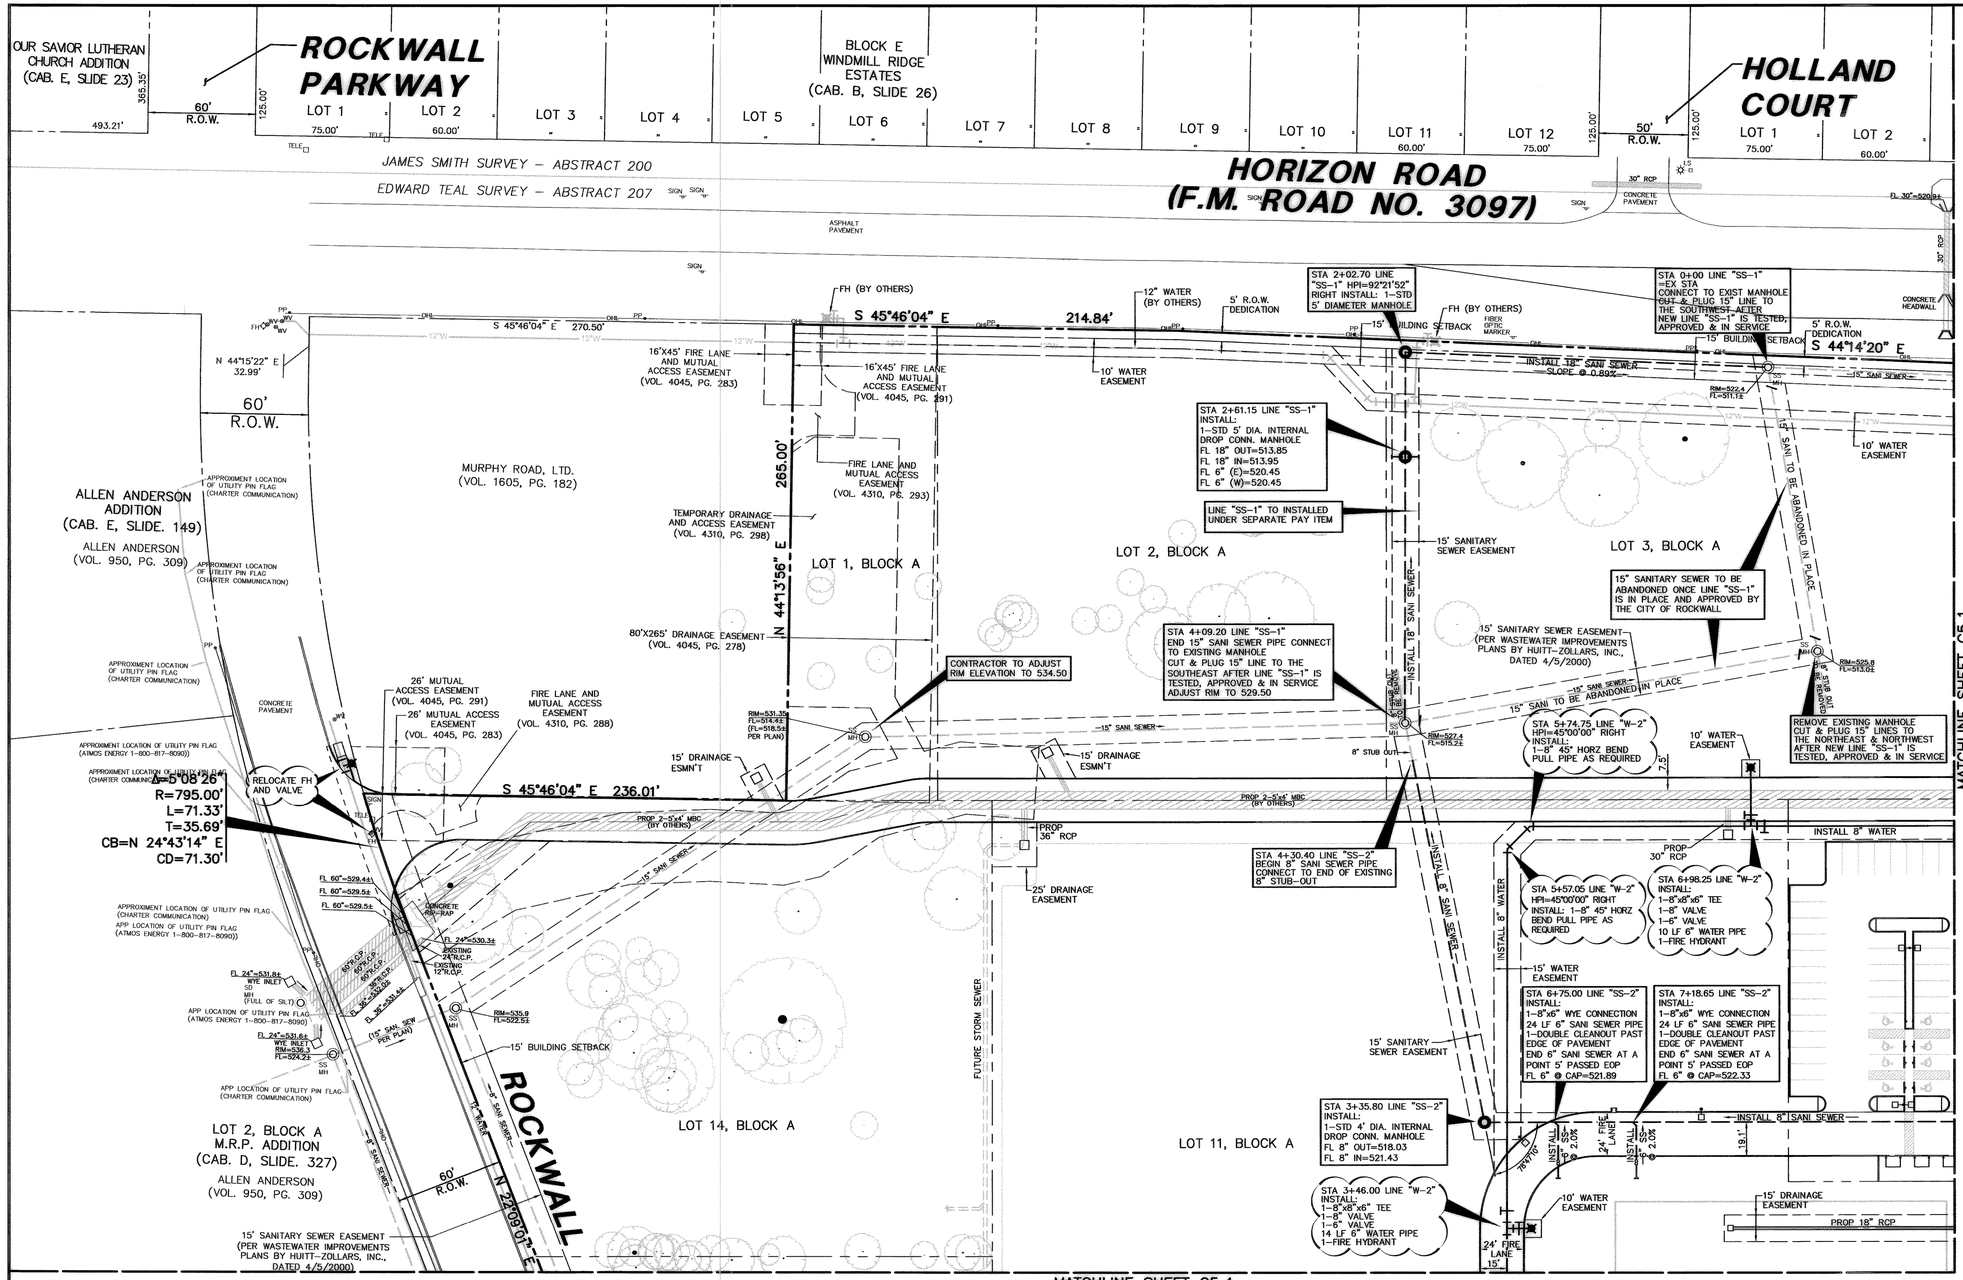

0 20 40 80 120
GRAPHIC SCALE IN FEET

LEGEND

FH	FIRE HYDRANT
PP	POWER POLE
LS	LIGHT STANDARD
WM	WATER METER
WV	WATER VALVE
CO	CLEANOUT
MH	MANHOLE
GM	GAS METER
	PROPERTY LINE

BENCH MARK LIST

BM# 1 CITY OF ROCKWALL MONUMENT "RESET 1"; 3" BRASS DISK FOUND AT RIDGE ROAD (F.M. 740) AND SUMMER LEE DRIVE NEAR THE NORTH WEST CORNER OF THE A PARKING LOT FOR COMMUNITY BANK.
ELEV=567.70

BM# 2 " □ " CUT FOUND ON THE BACK OF CURB ON THE POINT ON CURVATURE OF THE SOUTHWEST CORNER OF THE INTERSECTION OF SUMMER LEE DRIVE AND OAK DRIVE.
ELEV=563.21

BM# 3 " □ " CUT SET ON THE BACK OF CURB AT THE POINT OF CURVE OF ROCKWALL PARKWAY AT THE NORTHEAST CORNER OF THE INTERSECTION OF SUMMER LEE DRIVE AND ROCKWALL PARKWAY.
ELEV=552.82

SEE SHEET C5.2 FOR WATER AND SANITARY SEWER NOTES

RECORD DRAWING

THIS DRAWING HAS BEEN REVISED TO REFLECT CONSTRUCTION RECORDS MAINTAINED AND PROVIDED BY THE CONTRACTOR FOR THIS PROJECT, A VISUAL REVIEW OF THE COMPLETED SITE CONSTRUCTION BY PACHECO KOCH, AND FIELD SURVEY VERIFICATION AT MANHOLES AND INLETS BY PACHECO KOCH.

CONTRACTOR: ROGERS-O'BRIEN CONSTRUCTION CO.

DATE REVISED: 11/14/2007

STATE OF TEXAS
ERIK M. HAUGLIE
94736
LICENSED PROFESSIONAL ENGINEER

THE SEAL APPEARING ON THIS DOCUMENT WAS AUTHORIZED BY ERIK M. HAUGLIE, P.E. 94736 ON 07/17/2006. ALTERATION OF A SEALED DOCUMENT WITHOUT PROPER NOTIFICATION TO THE RESPONSIBLE ENGINEER IS AN OFFENSE UNDER THE TEXAS ENGINEERING PRACTICE ACT.

NO.	DATE	REVISION
1	07/17/2006	REVISED LINE "SS-1" TO 18"
2	08/25/2006	REMOVED EMBEDMENT DETAILS
3	09/25/2006	ADDED INTERNAL DROP CONNECTION MH @ STA 6+35.80 "SS-2"

Pacheco Koch Consulting Engineers
8350 N. CENTRAL EXPWY. SUITE 1000 DALLAS, TX. 75206 972.235.3031

WATER & SANITARY SEWER PLAN

ROCKWALL COMMUNITY HOSPITAL

HORIZON ROAD @ ROCKWALL PARKWAY

EDWARD TEAL SURVEY, ABST. NO. 207

CITY OF ROCKWALL, TEXAS

DESIGN	DRAWN	DATE	SCALE	NOTES	FILE	NO.
EMH	RRL	AUG 2006	1"=40'			C5.1

ROCKWALL COMMUNITY HOSPITAL

DWG FILE: 1567-05-270CV.DWG

PLOTTED: 03/25/2008 - 9:49AM
M:\DWG-15\1567-05.270\DWG\1567-05-270CV.DWG