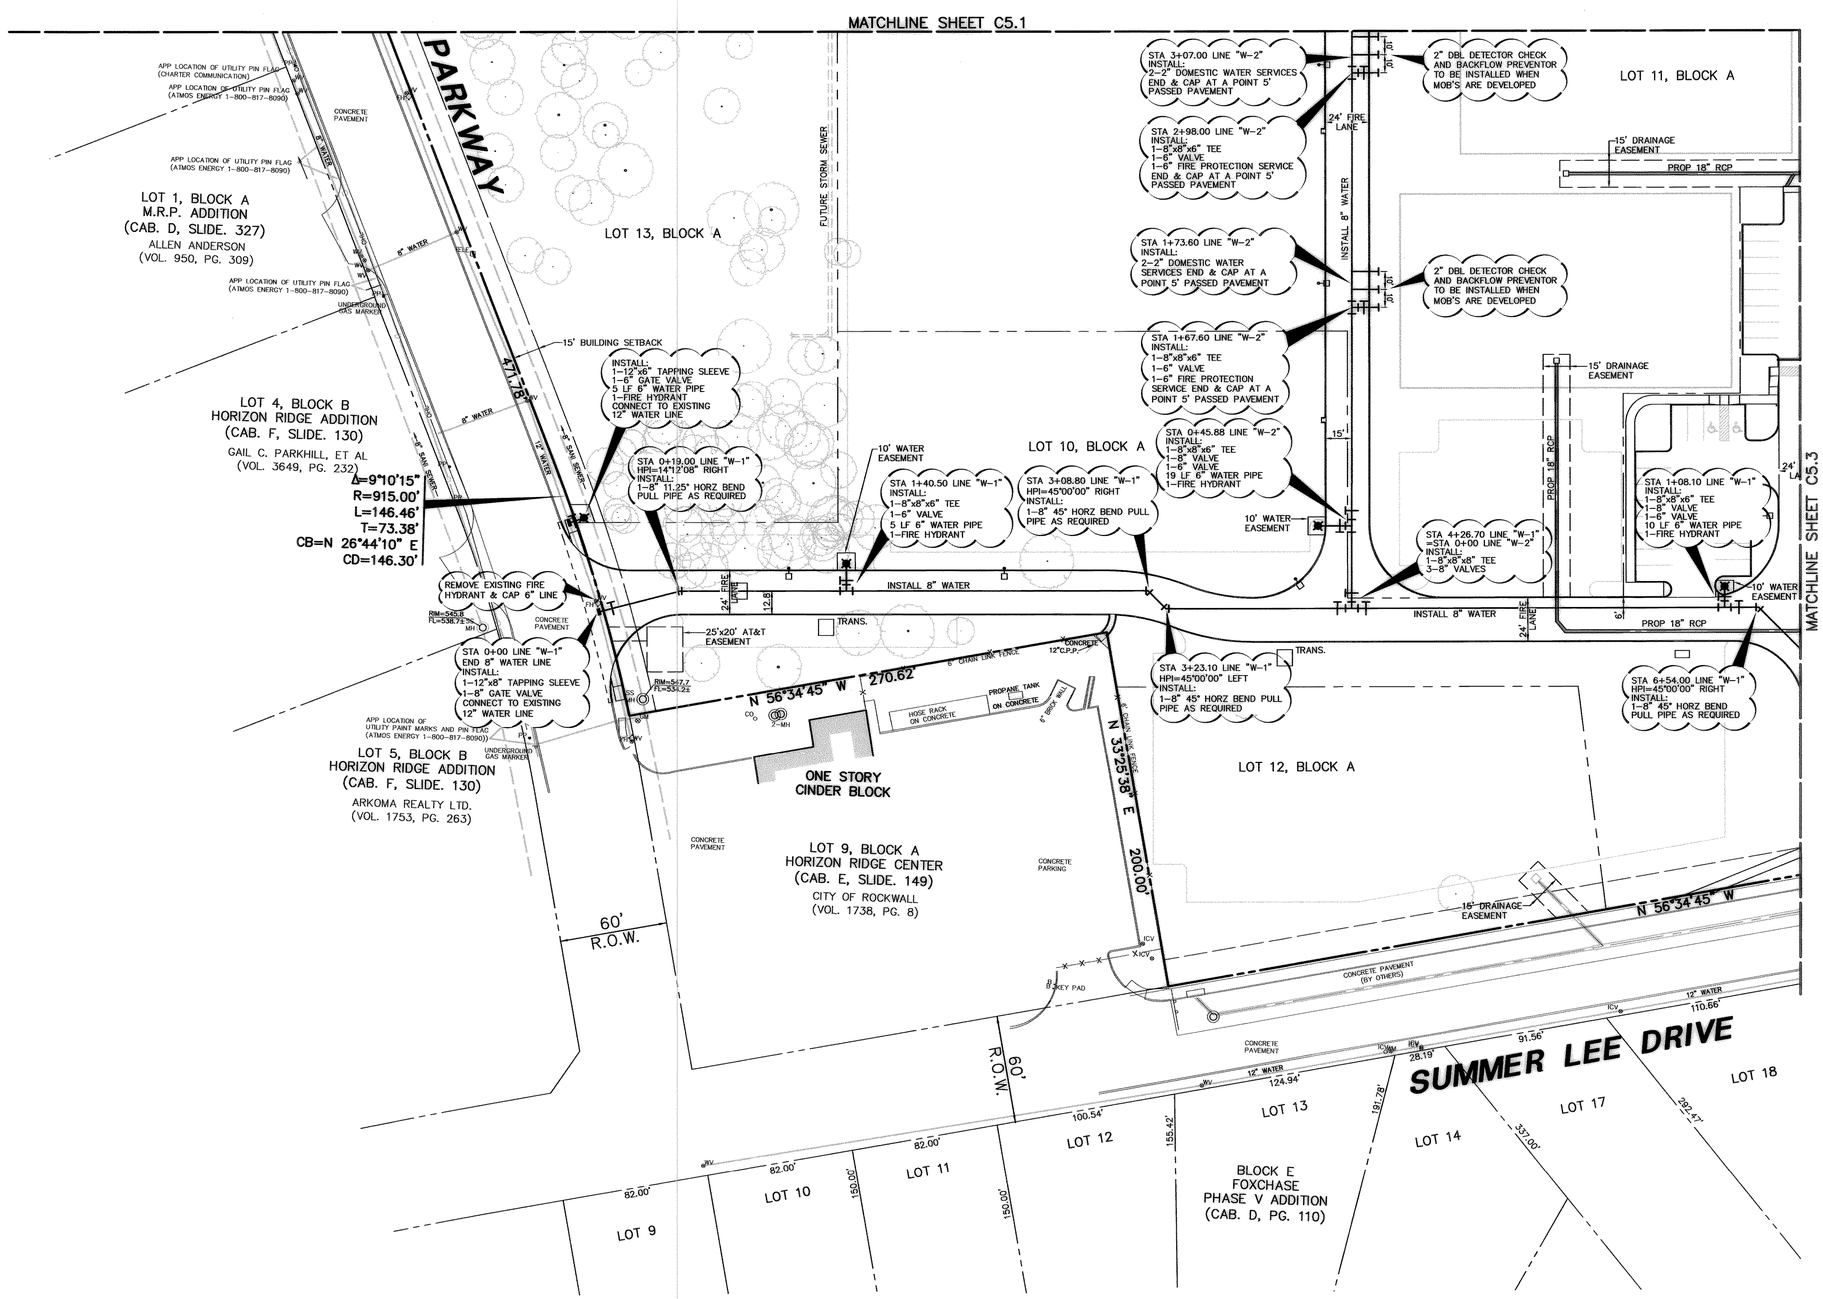

0 20 40 80 120

GRAPHIC SCALE IN FEET

LEGEND

- FH — FIRE HYDRANT
- PP — POWER POLE
- LS — LIGHT STANDARD
- WM — WATER METER
- WV — WATER VALVE
- CO — CLEANOUT
- MH — MANHOLE
- GM — GAS METER
- PROPERTY LINE

BENCH MARK LIST

BM# 1 CITY OF ROCKWALL MONUMENT "RESET 1"; 3" BRASS DISK FOUND AT RIDGE ROAD (F.M. 740) AND SUMMER LEE DRIVE NEAR THE NORTH WEST CORNER OF THE A PARKING LOT FOR COMMUNITY BANK.
ELEV=567.70

BM# 2 " □ " CUT FOUND ON THE BACK OF CURB ON THE POINT ON CURVATURE OF THE SOUTHWEST CORNER OF THE INTERSECTION OF SUMMER LEE DRIVE AND OAK DRIVE.
ELEV=563.21

BM# 3 " □ " CUT SET ON THE BACK OF CURB AT THE POINT OF CURVE OF ROCKWALL PARKWAY AT THE NORTHEAST CORNER OF THE INTERSECTION OF SUMMER LEE DRIVE AND ROCKWALL PARKWAY.
ELEV=552.82

RECORD DRAWING

THIS DRAWING HAS BEEN REVISED TO REFLECT CONSTRUCTION RECORDS MAINTAINED AND PROVIDED BY THE CONTRACTOR FOR THIS PROJECT, A VISUAL REVIEW OF THE COMPLETED SITE CONSTRUCTION BY PACHECO KOCH, AND FIELD SURVEY VERIFICATION AT MANHOLES AND INLETS BY PACHECO KOCH.

CONTRACTOR: ROGERS-O'BRIEN CONSTRUCTION CO.

DATE REVISED: 11/14/2007

STATE OF TEXAS — ERIK M. HAUGLIE — 94736 — LICENSED PROFESSIONAL ENGINEER

THE SEAL APPEARING ON THIS DOCUMENT WAS AUTHORIZED BY ERIK M. HAUGLIE, P.E. 94736 ON 07/17/2006. ALTERATION OF A SEALED DOCUMENT WITHOUT PROPER NOTIFICATION TO THE RESPONSIBLE ENGINEER IS AN OFFENSE UNDER THE TEXAS ENGINEERING PRACTICE ACT.

SEE SHEET C5.2 FOR WATER AND SANITARY SEWER NOTES

NO.	DATE	REVISION
3	09/25/2006	MOVED CONNECTION POINT 6 FEET AT LINE "W-1" STA 0+00

Pacheco Koch Consulting Engineers
8350 N. CENTRAL EXPWY. SUITE 1000 DALLAS, TX. 75206 972.235.3031

WATER & SANITARY SEWER PLAN

ROCKWALL COMMUNITY HOSPITAL

HORIZON ROAD @ ROCKWALL PARKWAY

EDWARD TEAL SURVEY, ABST. NO. 207

CITY OF ROCKWALL, TEXAS

DESIGN	DRAWN	DATE	SCALE	NOTES	FILE	NO.
EMH	RRL	JULY 2006	1"=40'			C5.4

ROCKWALL COMMUNITY HOSPITAL

DWG FILE: 1567-05-270CV.DWG

PLOTTED: 07/17/2008 - 9:52AM
M:\DWG-15\1567-05.270\DWG\1567-05-270CV.DWG