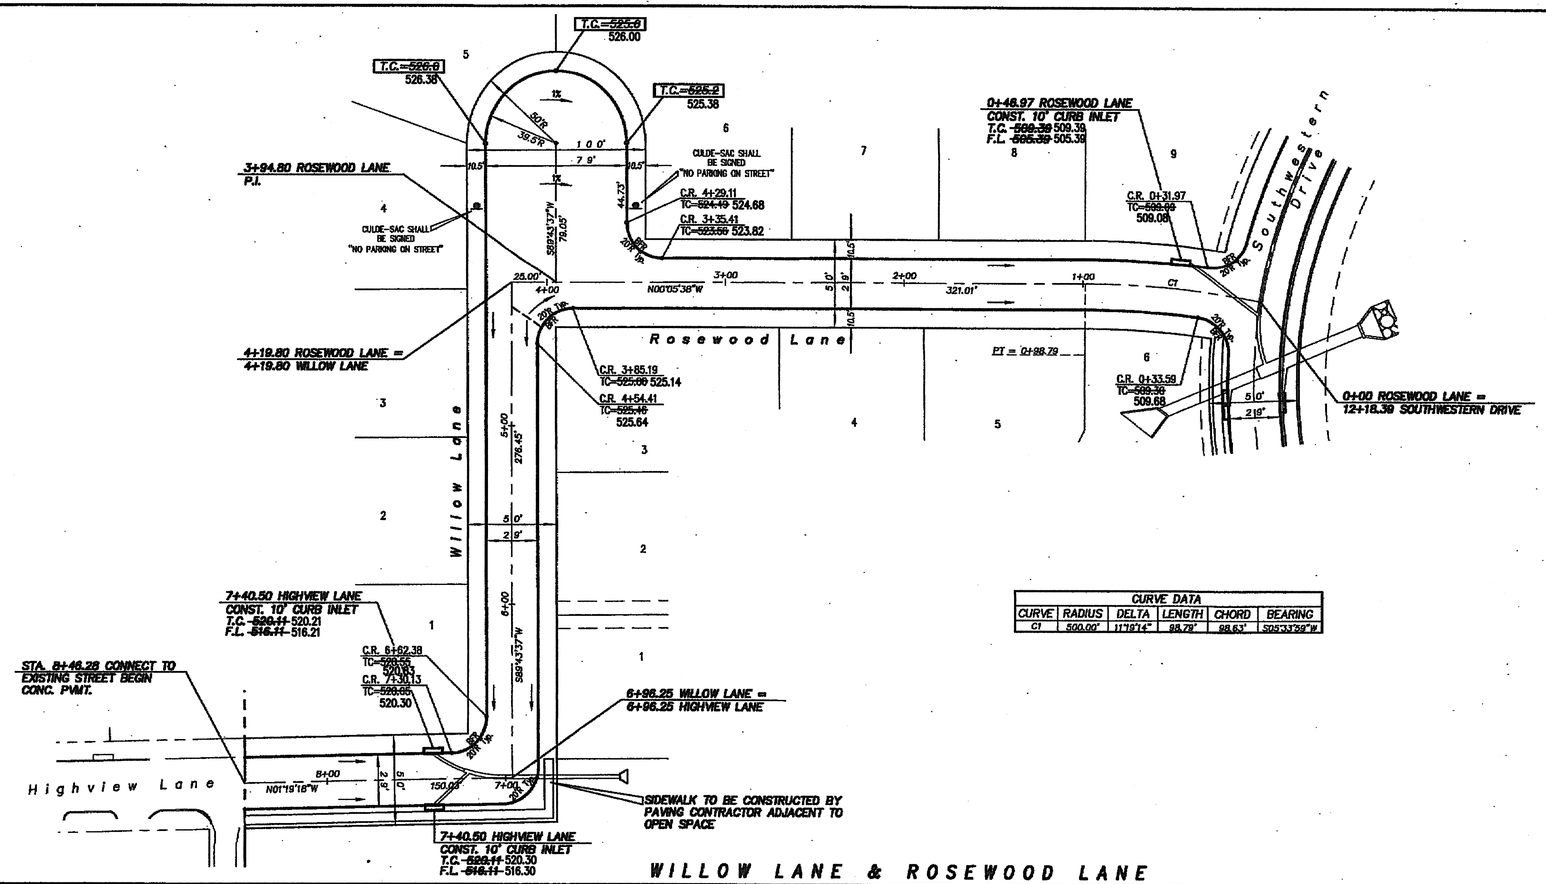

WILLOW LANE & ROSEWOOD LANE

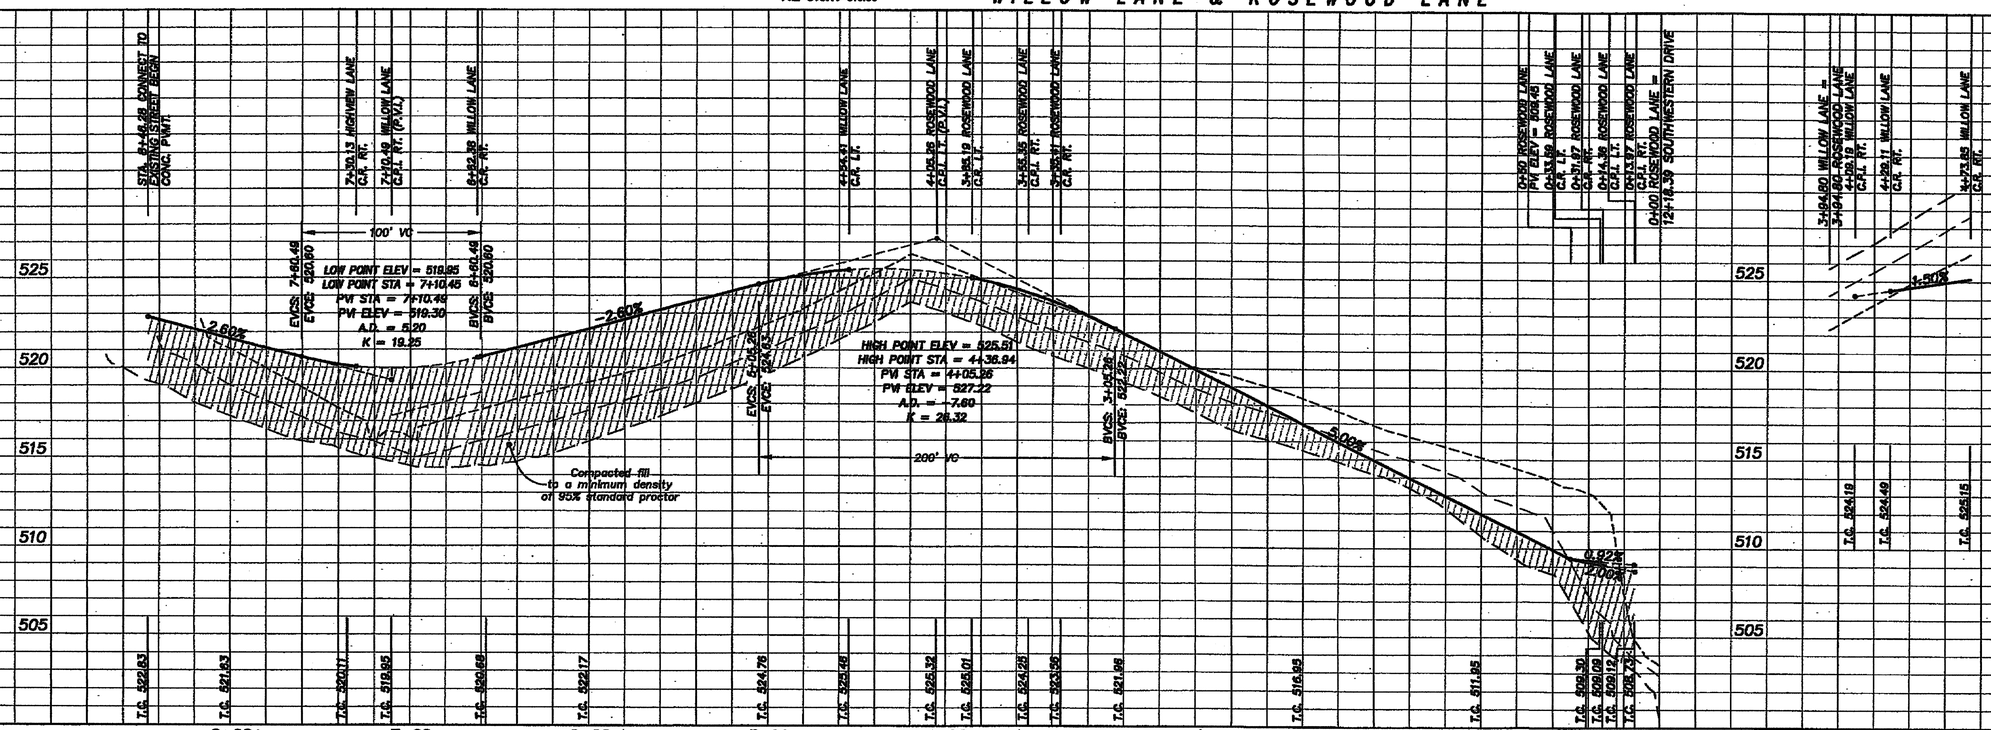

STATE OF TEXAS
TIM C. SPIARS
84077
LICENSED PROFESSIONAL ENGINEER
11/12/09

RECORD DRAWINGS

NOTE:
THESE PLANS HAVE BEEN REVISED TO CONFORM WITH CONSTRUCTION RECORDS PROVIDED TO SPIARS ENGINEERING, INC. BY CONTRACTOR AND CITY STAFF AFTER AS-BUILTS WERE ORIGINALLY SUBMITTED TO THE CITY OF ROCKWALL BY OTHERS. MODIFICATIONS TO PAVING, PAD AND UTILITY ELEVATIONS, AS REFLECTED ON THESE PLANS, WERE VERIFIED BY FIELD SURVEY PERFORMED IN DECEMBER, 2008.

BENCH MARK: #1
BRASS CAP IN CL. OF MEDIAN NORTH ON LAKESHORE DRIVE NORTH OF THE INTERSECTION OF NORTH ALAMO AND LAKESHORE DRIVE.

ELEV. 524.78

BENCH MARK: #2
BRASS CAP IN CL. OF MEDIAN ON LAKESHORE DRIVE BETWEEN TO STREETS, STONEBROOK AND AMESBURY BEING NORTH OF HAVEN HILL

ELEV. 518.83

"AS BUILTS"
Information shown on these plans was furnished by the Contractor. All responsibility for the accuracy belongs to the Contractor.

STATE OF TEXAS
GRANT M. WOODFIN
90381
LICENSED PROFESSIONAL ENGINEER

The Seal Appearing On This Document Was Authorized By
90381, on
2-9-10

PAVING PLAN & PROFILE
WILLOW LANE & ROSEWOOD LANE
THE PRESERVE - PHASE 2
CITY OF ROCKWALL, TEXAS

C&P Engineering, LTD.
Engineering • Planning • Surveying
1801 GATEWAY BLVD. – SUITE 101
RICHARDSON, TEXAS 75080
email: info@c-pengineering.com
(972) 644-2800 OFC (972) 644-2817 FAX

DRAWN BY:	DATE:	SCALE:	JOB NUMBER:	SHEET: 05110-Pav8
C&P	2/06	1"=40'-H 1"=4'-V	05109	13 OF