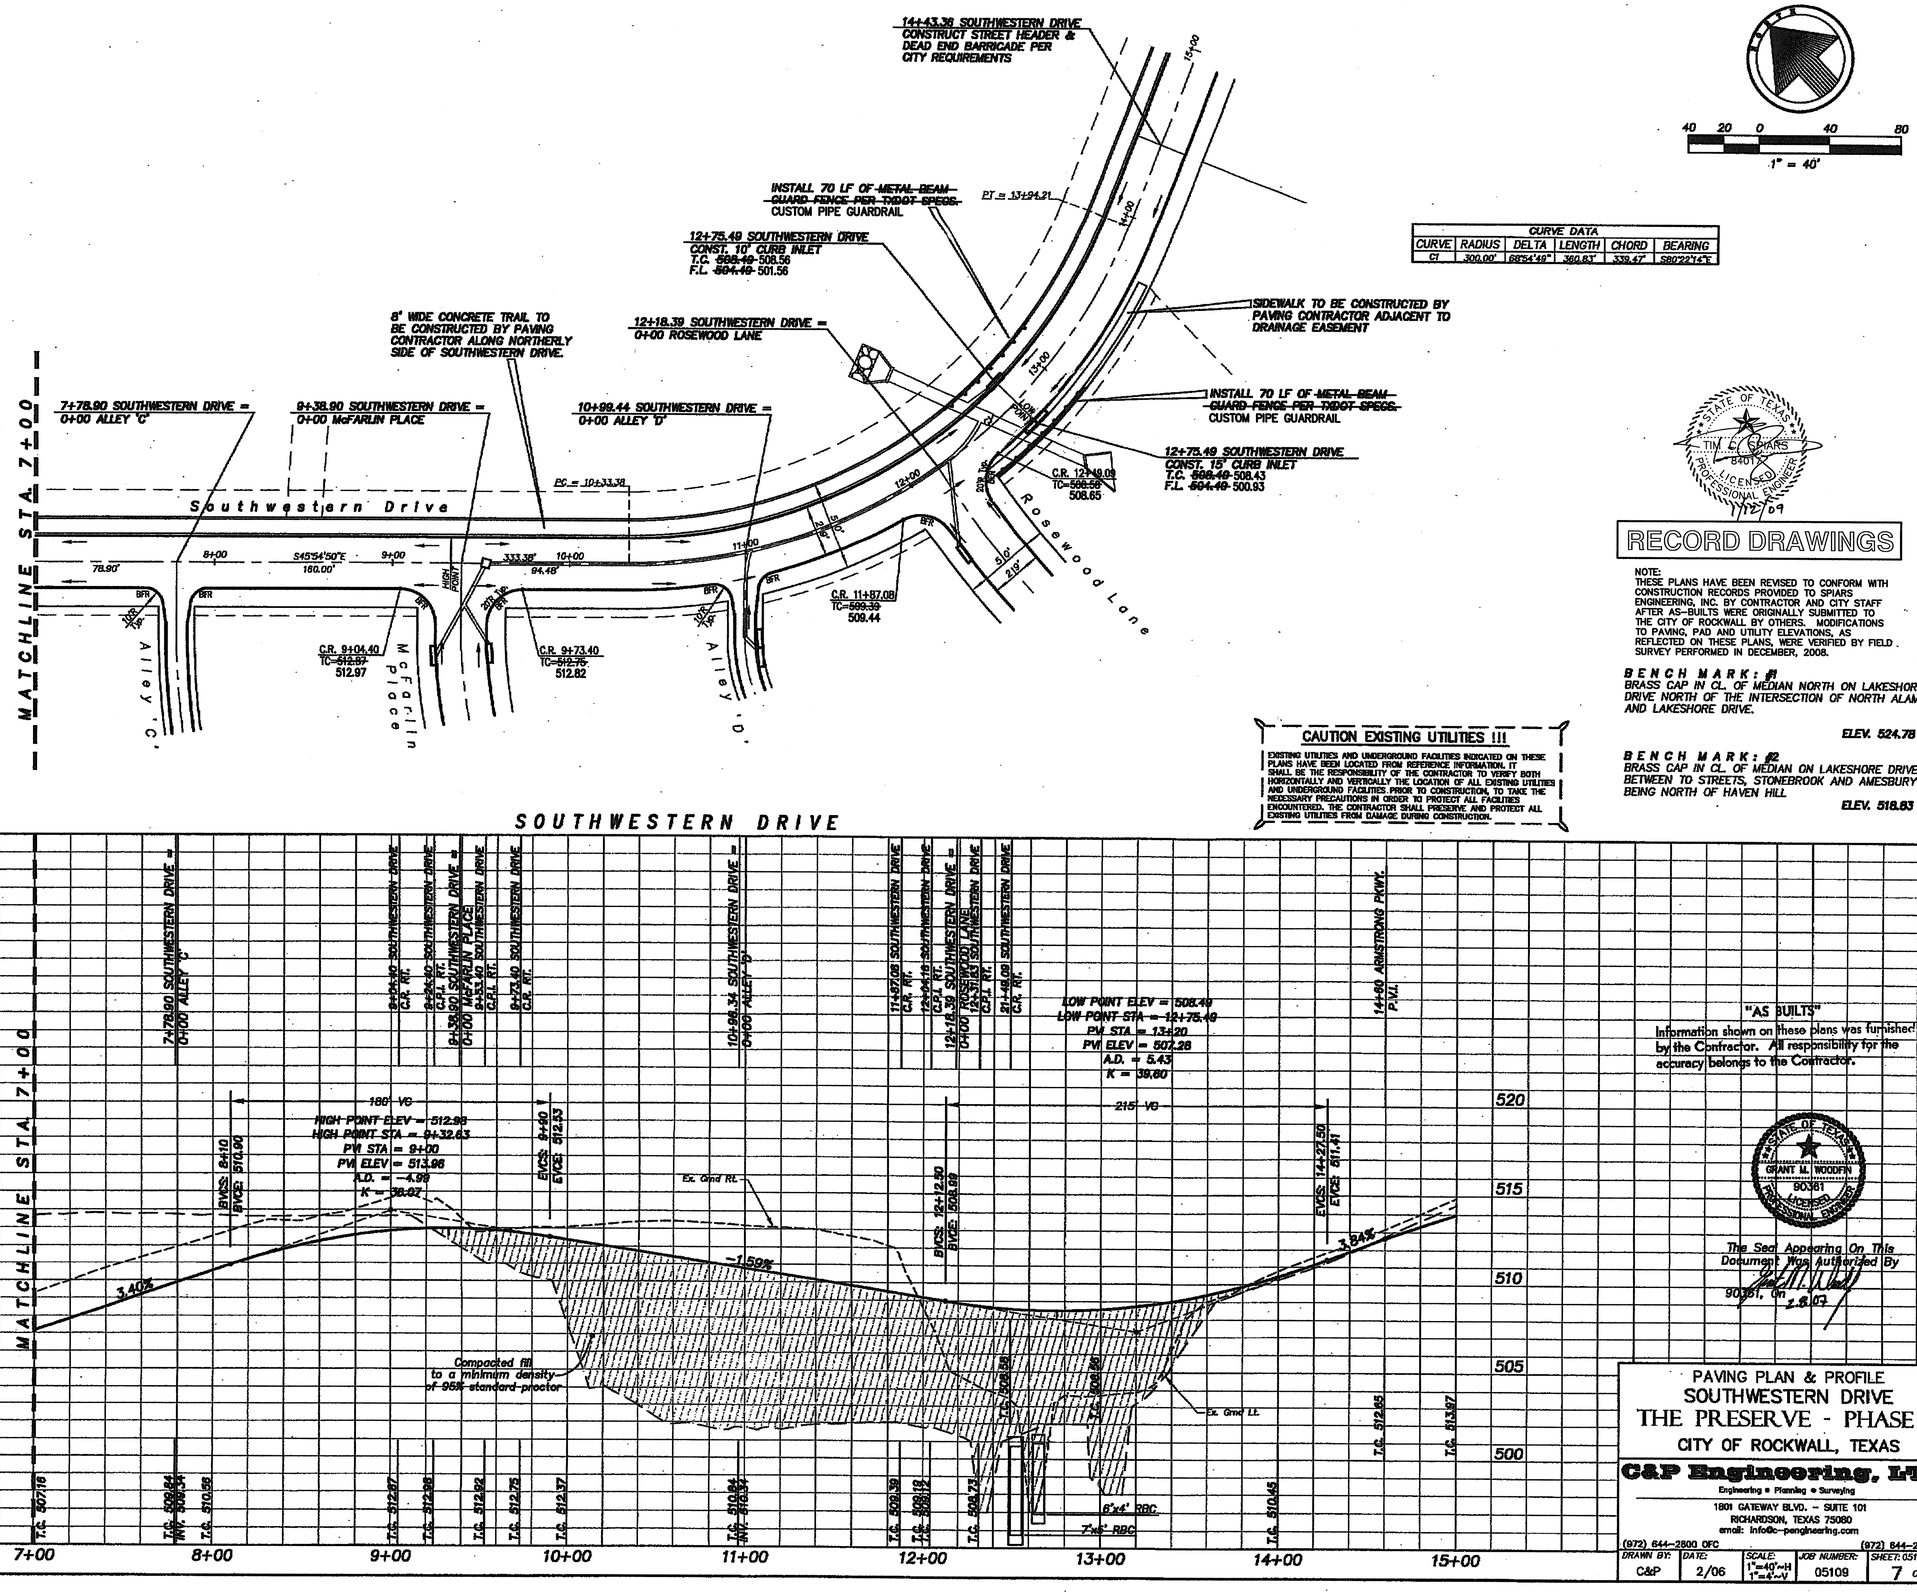

PAVING PLAN & PROFILE
SOUTHWESTERN DRIVE
THE PRESERVE - PHASE 2
CITY OF ROCKWALL, TEXAS

C&P Engineering, LTD.
Engineering • Planning • Surveying
1801 GATEWAY BLVD. - SUITE 101
RICHARDSON, TEXAS 75080
email: info@c-pengineering.com
(972) 644-2800 OFC (972) 644-2817 FAX

DRAWN BY:	DATE:	SCALE:	JOB NUMBER:	SHEET: 0511D-Pav2
C&P	2/06	1"=40'-H 1"=4'-V	05109	7 OF