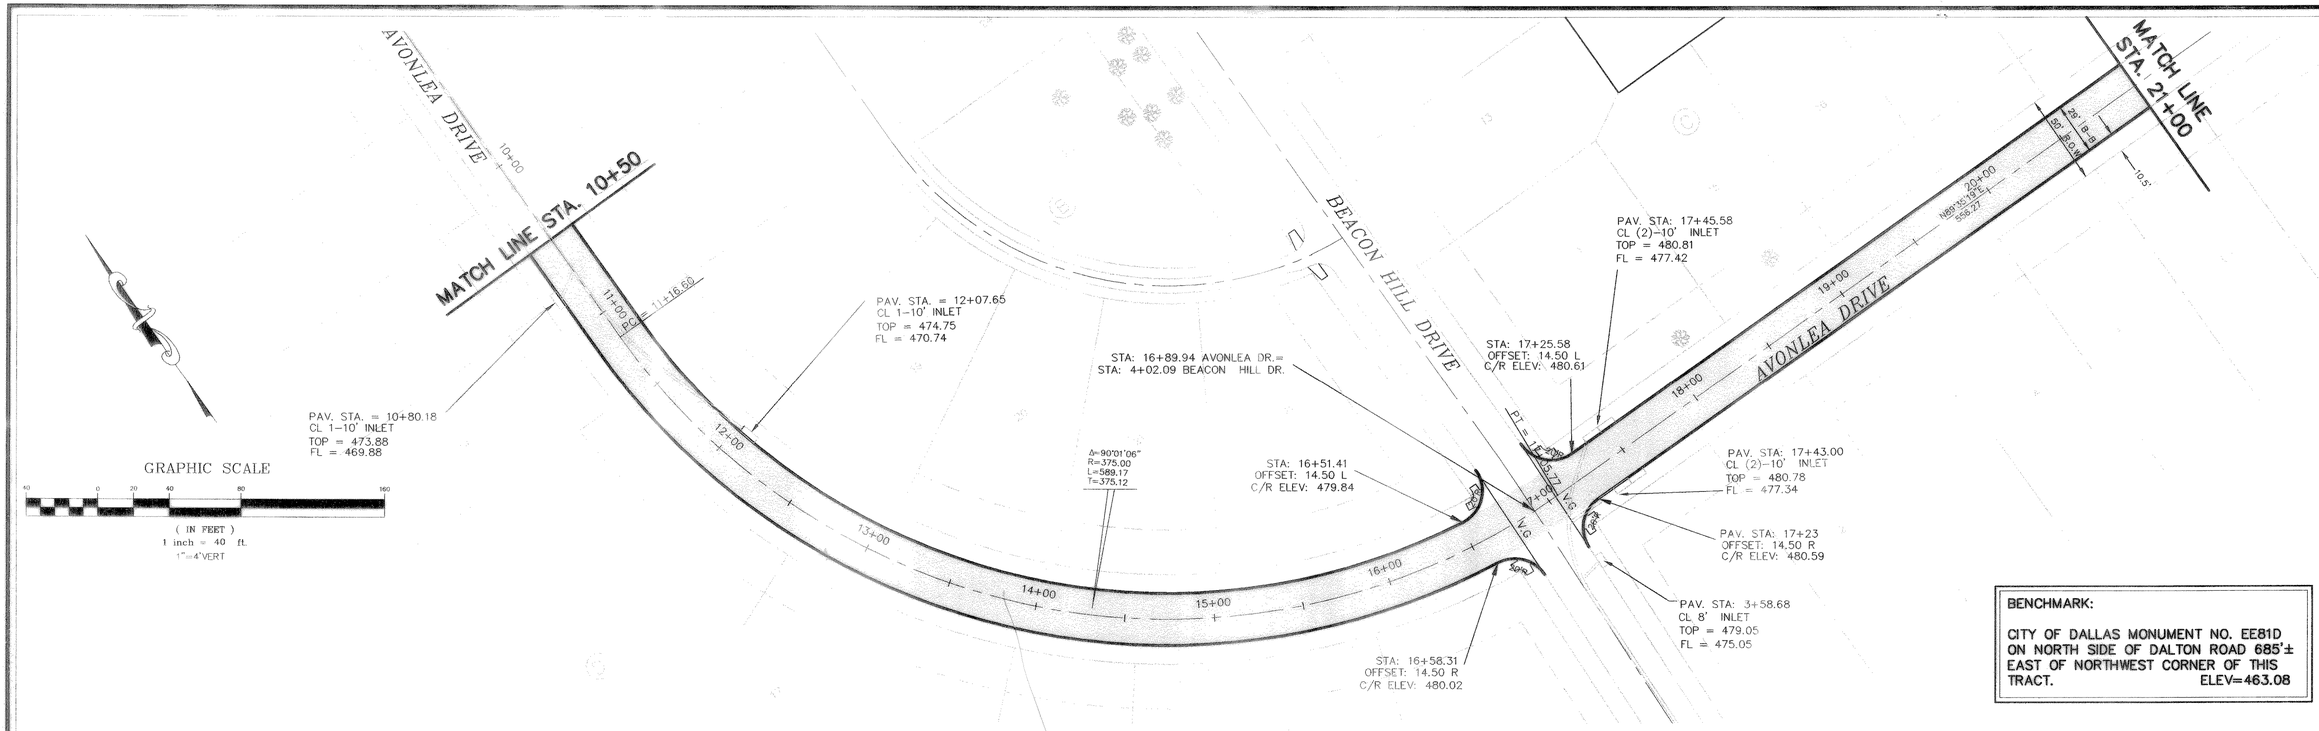

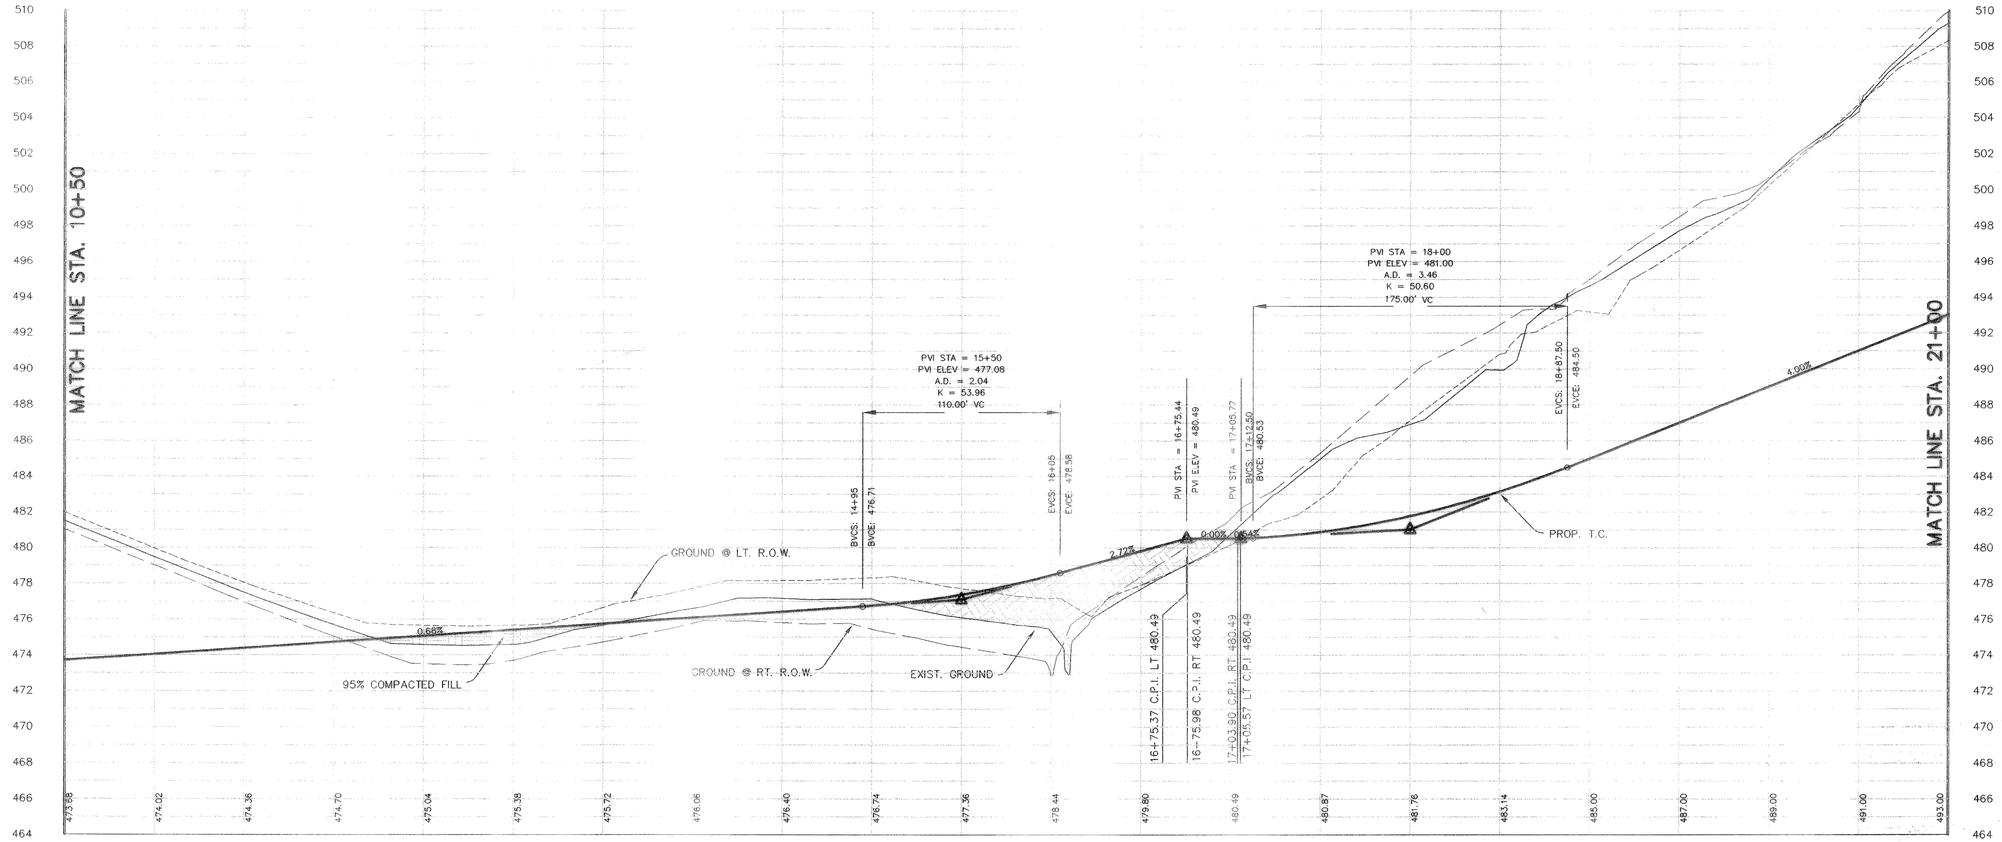

BENCHMARK:

CITY OF DALLAS MONUMENT NO. EE81D ON NORTH SIDE OF DALTON ROAD 685'± EAST OF NORTHWEST CORNER OF THIS TRACT. ELEV=463.08

THE SEAL APPEARING ON THIS DOCUMENT WAS AUTHORIZED BY W.L. DOUPHRATE II TEXAS P.E. NO. 60102 ON 11/25/02

DOUPHRATE & ASSOCIATES, INC.
ENGINEERING • PROJECT MANAGEMENT • SURVEYING
2235 RIDGE RD., # 200 ROCKWALL, TEXAS 75087
PHONE: (972)771-9004 FAX: (972)771-9005

PAVING PLAN & PROFILE
AVONLEA DR. STA: 10+50 TO 21+00
PROMENADE HARBOR
CITY OF ROCKWALL, ROCKWALL COUNTY, TEXAS

REVISION	
CHECKED	W.L.D.
DRAWN	K.E.B.
DATE	9/01
PROJECT	0050PV5
	13 OF

REVISED TO CONFORM TO CONSTRUCTION RECORDS.
DATE: 11/25/02