PHASE 2A

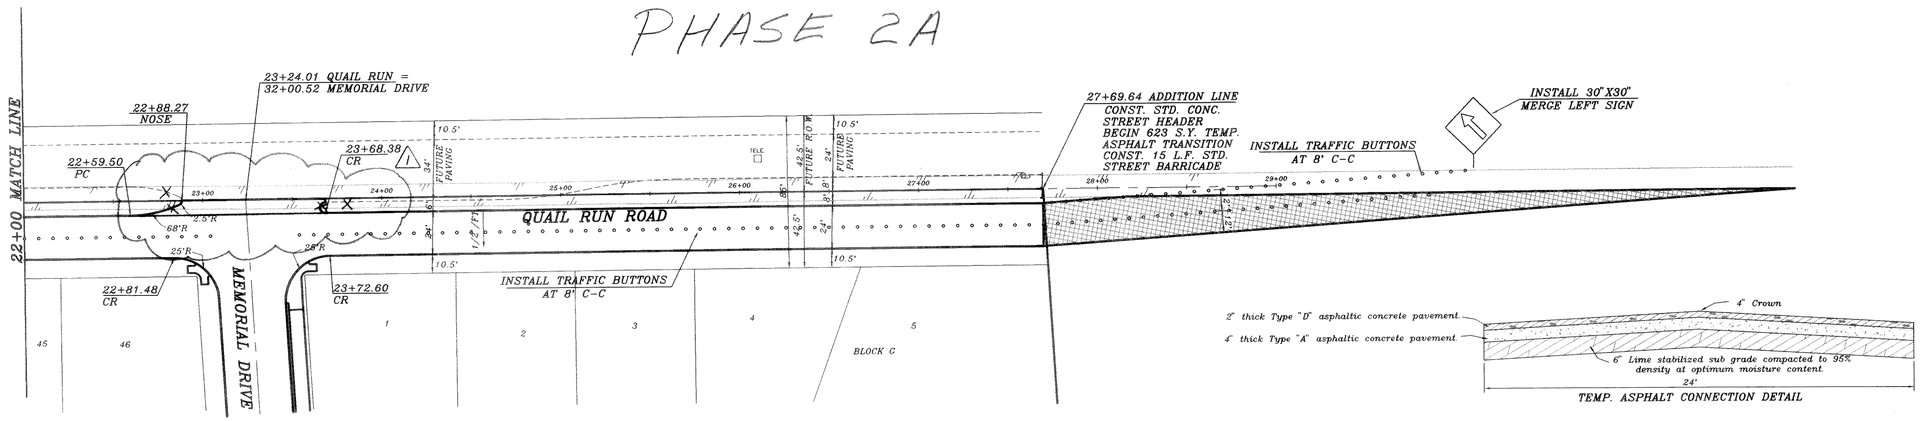

TEMP. ASPHALT CONNECTION DETAIL

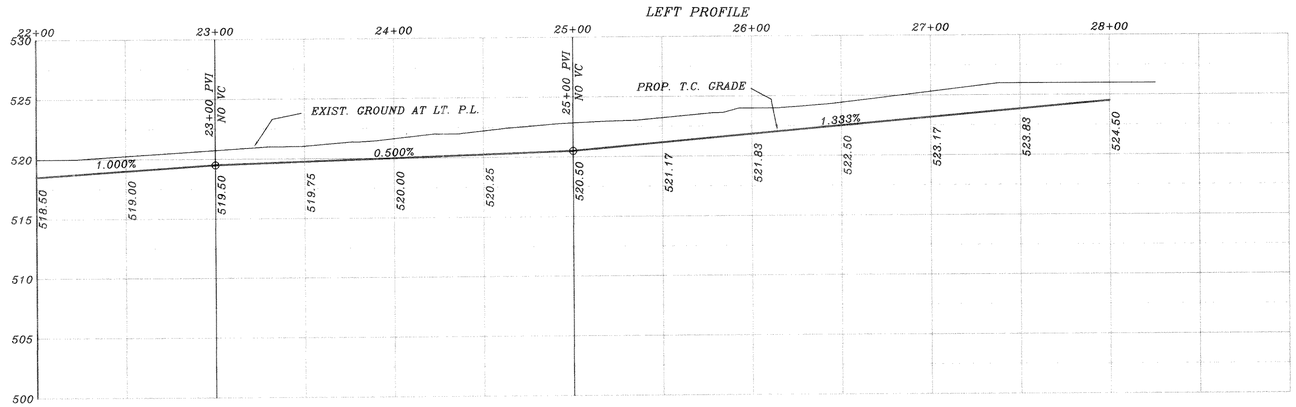

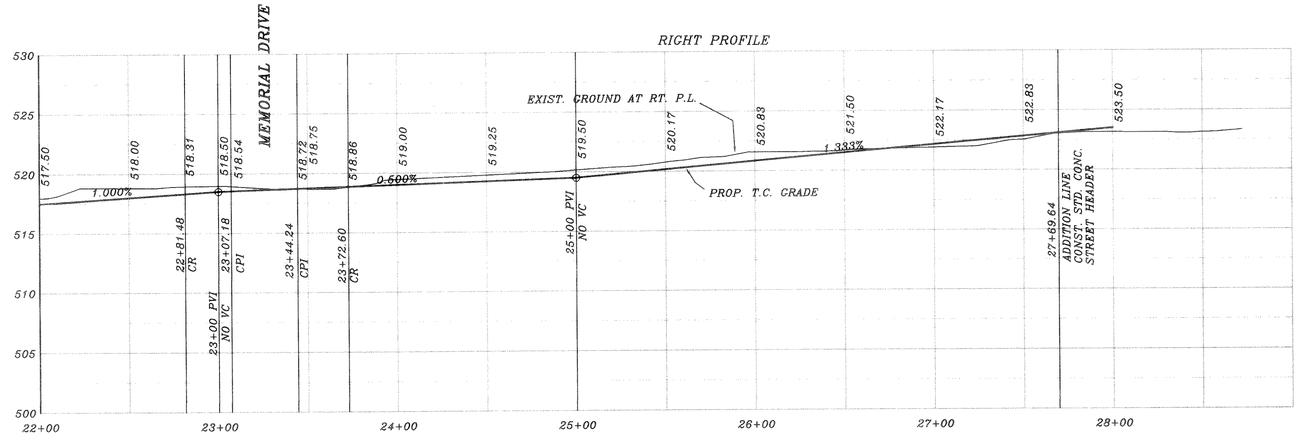

AS BUILT

Winkelmann & Associates, Inc. hereby states that this plan, to the best of our knowledge is "As Built." Modifications from the originally approved construction documents have been made as per information provided by the contractor. Winkelmann & Associates, Inc. does not warranty as to the correctness or quality of construction or its conformance with plans.

WINKELMANN & ASSOCIATES, INC. 9-27-02

PH2A

BENCH MARK
SQUARE CUT IN CONCRETE AT BASE OF CONCRETE WALL AT S.W. CORNER OF SOUTH APPROACH TO BRIDGE OVER SQUABBLE CREEK ON HWY. 205
ELEV.: 472.41

BENCH MARK
60D NAIL IN 36" PECAN TREE (TREE NO. 2302)
PAV. STA. 8+30, 71' RT., MEMORIAL DRIVE
ELEV.: 466.79

BENCH MARK
60D NAIL IN 34" PECAN TREE (TREE NO. 2314)
PAV. STA. 7+83, 138' RT., AUDOBON LANE
ELEV.: 480.88

BENCH MARK
60D NAIL IN 18" PECAN TREE (TREE NO. 2114)
PAV. STA. 10+97 63.5' RT., AUDOBON LANE
ELEV.: 501.54

1-30-02

HAROLD L. EVANS
23155
REGISTERED
PROFESSIONAL
ENGINEER

7/01

REVISION DESCRIPTION	DATE
1 MEDIAN OPENING IN QUAIL RUN ROAD NOT IN THIS CONTRACT	1/3/02
REV. PER 4th REVIEW	7/12/01
REV. PER 3rd REVIEW	6/13/01
REV. PER 2nd REVIEW	6/10/01

0020\PHASE2\0020P212

HAROLD L. EVANS
CONSULTING ENGINEER
P.O. BOX 28355
2331 GUS THOMASSON ROAD, SUITE 102
DALLAS, TEXAS 75228, (214) 328-8133

DATE	SCALE	DESIGN	DRAWN
	1" = 40' / 1" = 6'	H.L.E.	

PROPOSED PAVING
QUAIL RUN ROAD
QUAIL RUN VALLEY NO. 2
CITY OF ROCKWALL

SHEET NO. 13 / 24

JOB NO. 0020