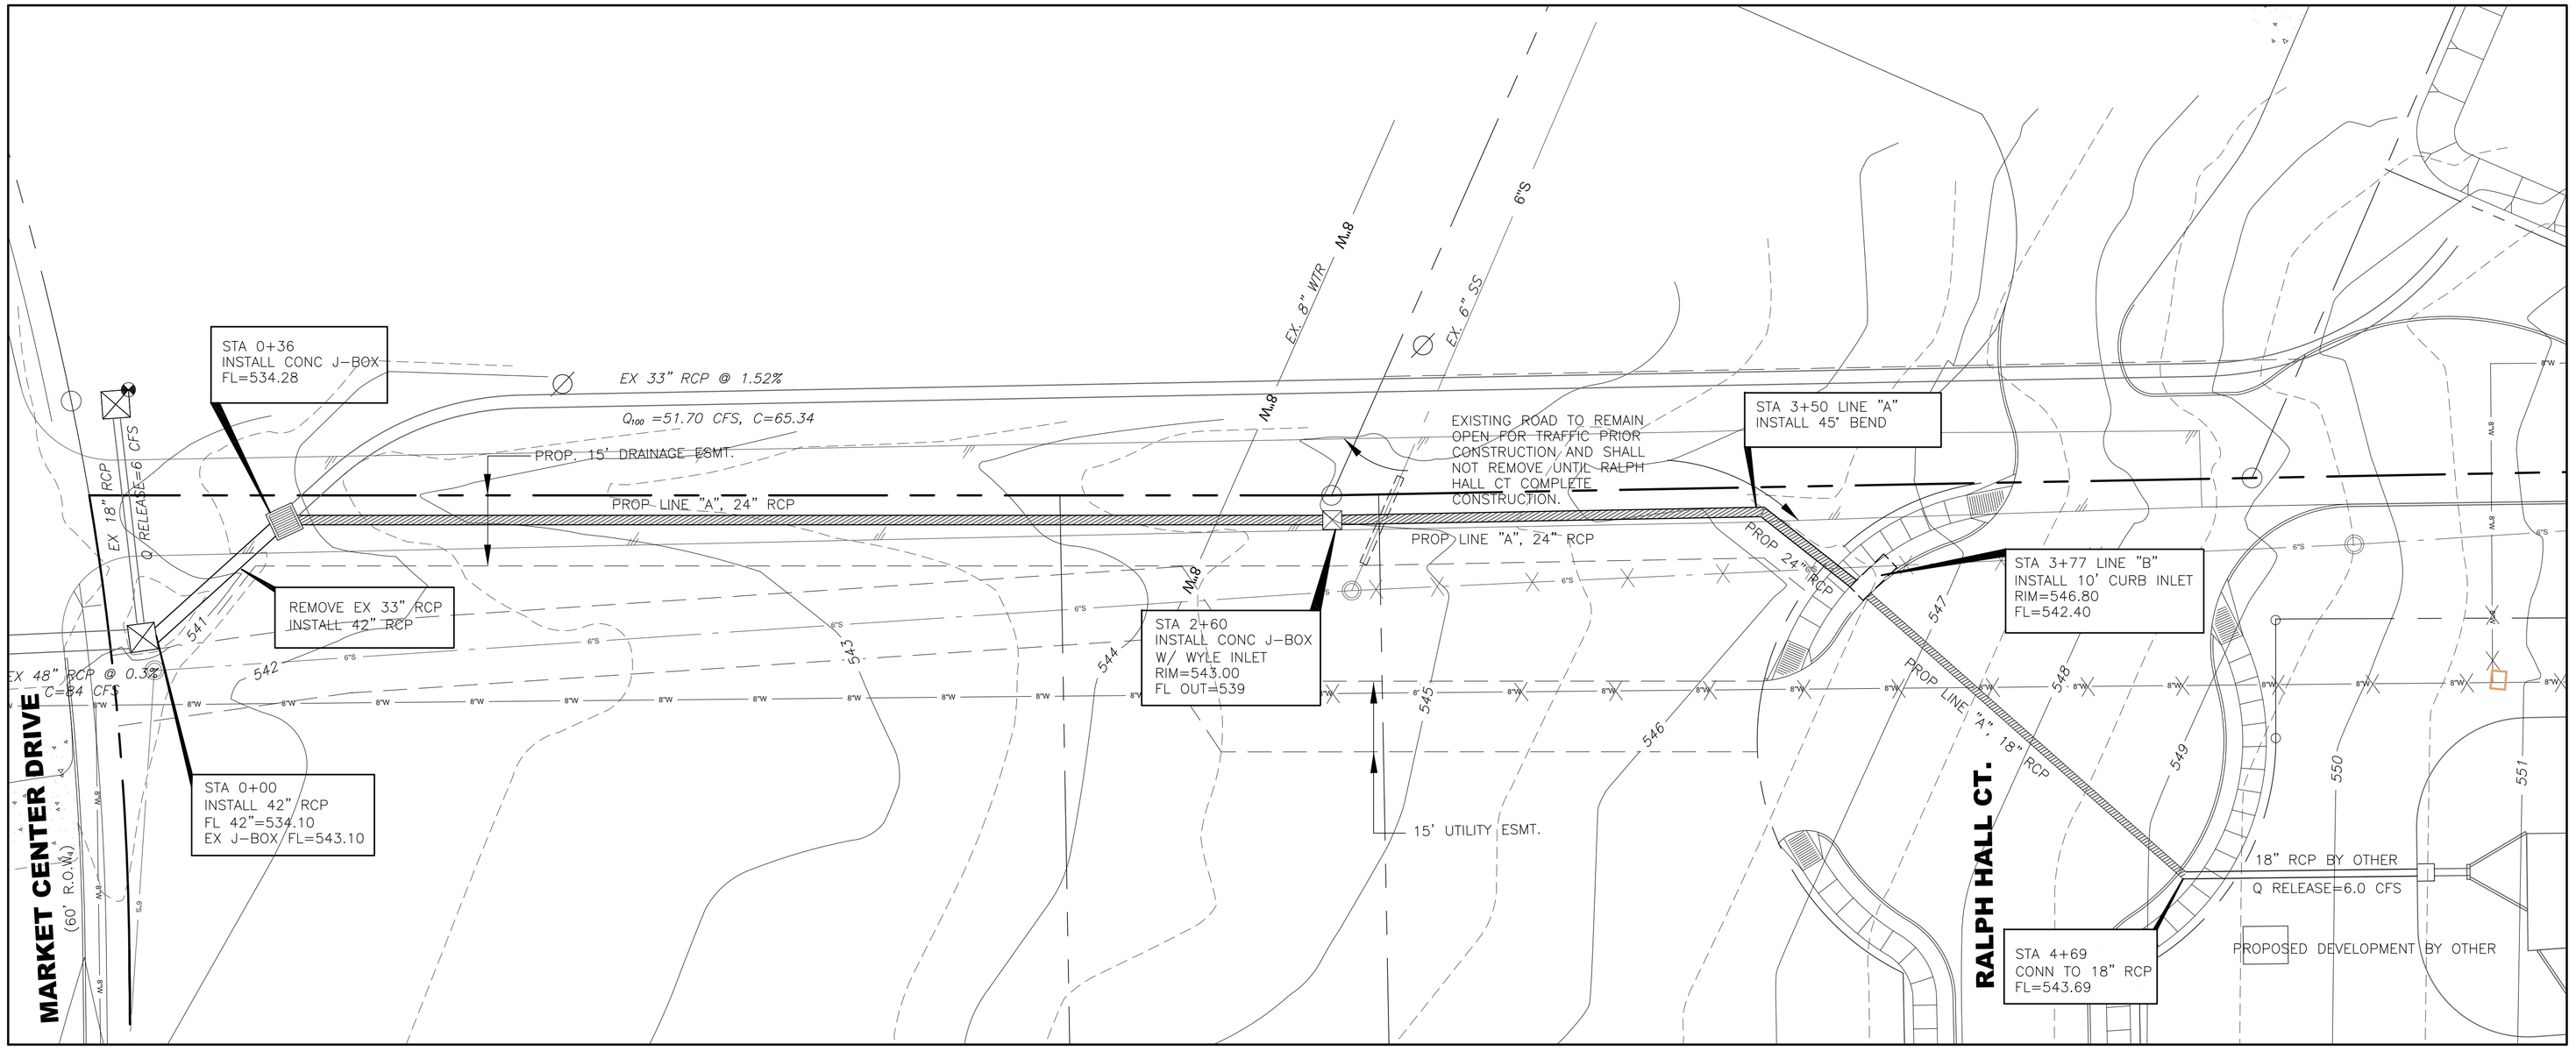

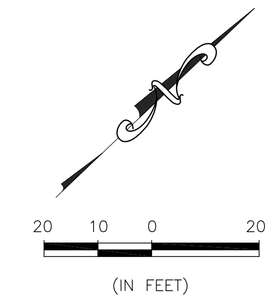

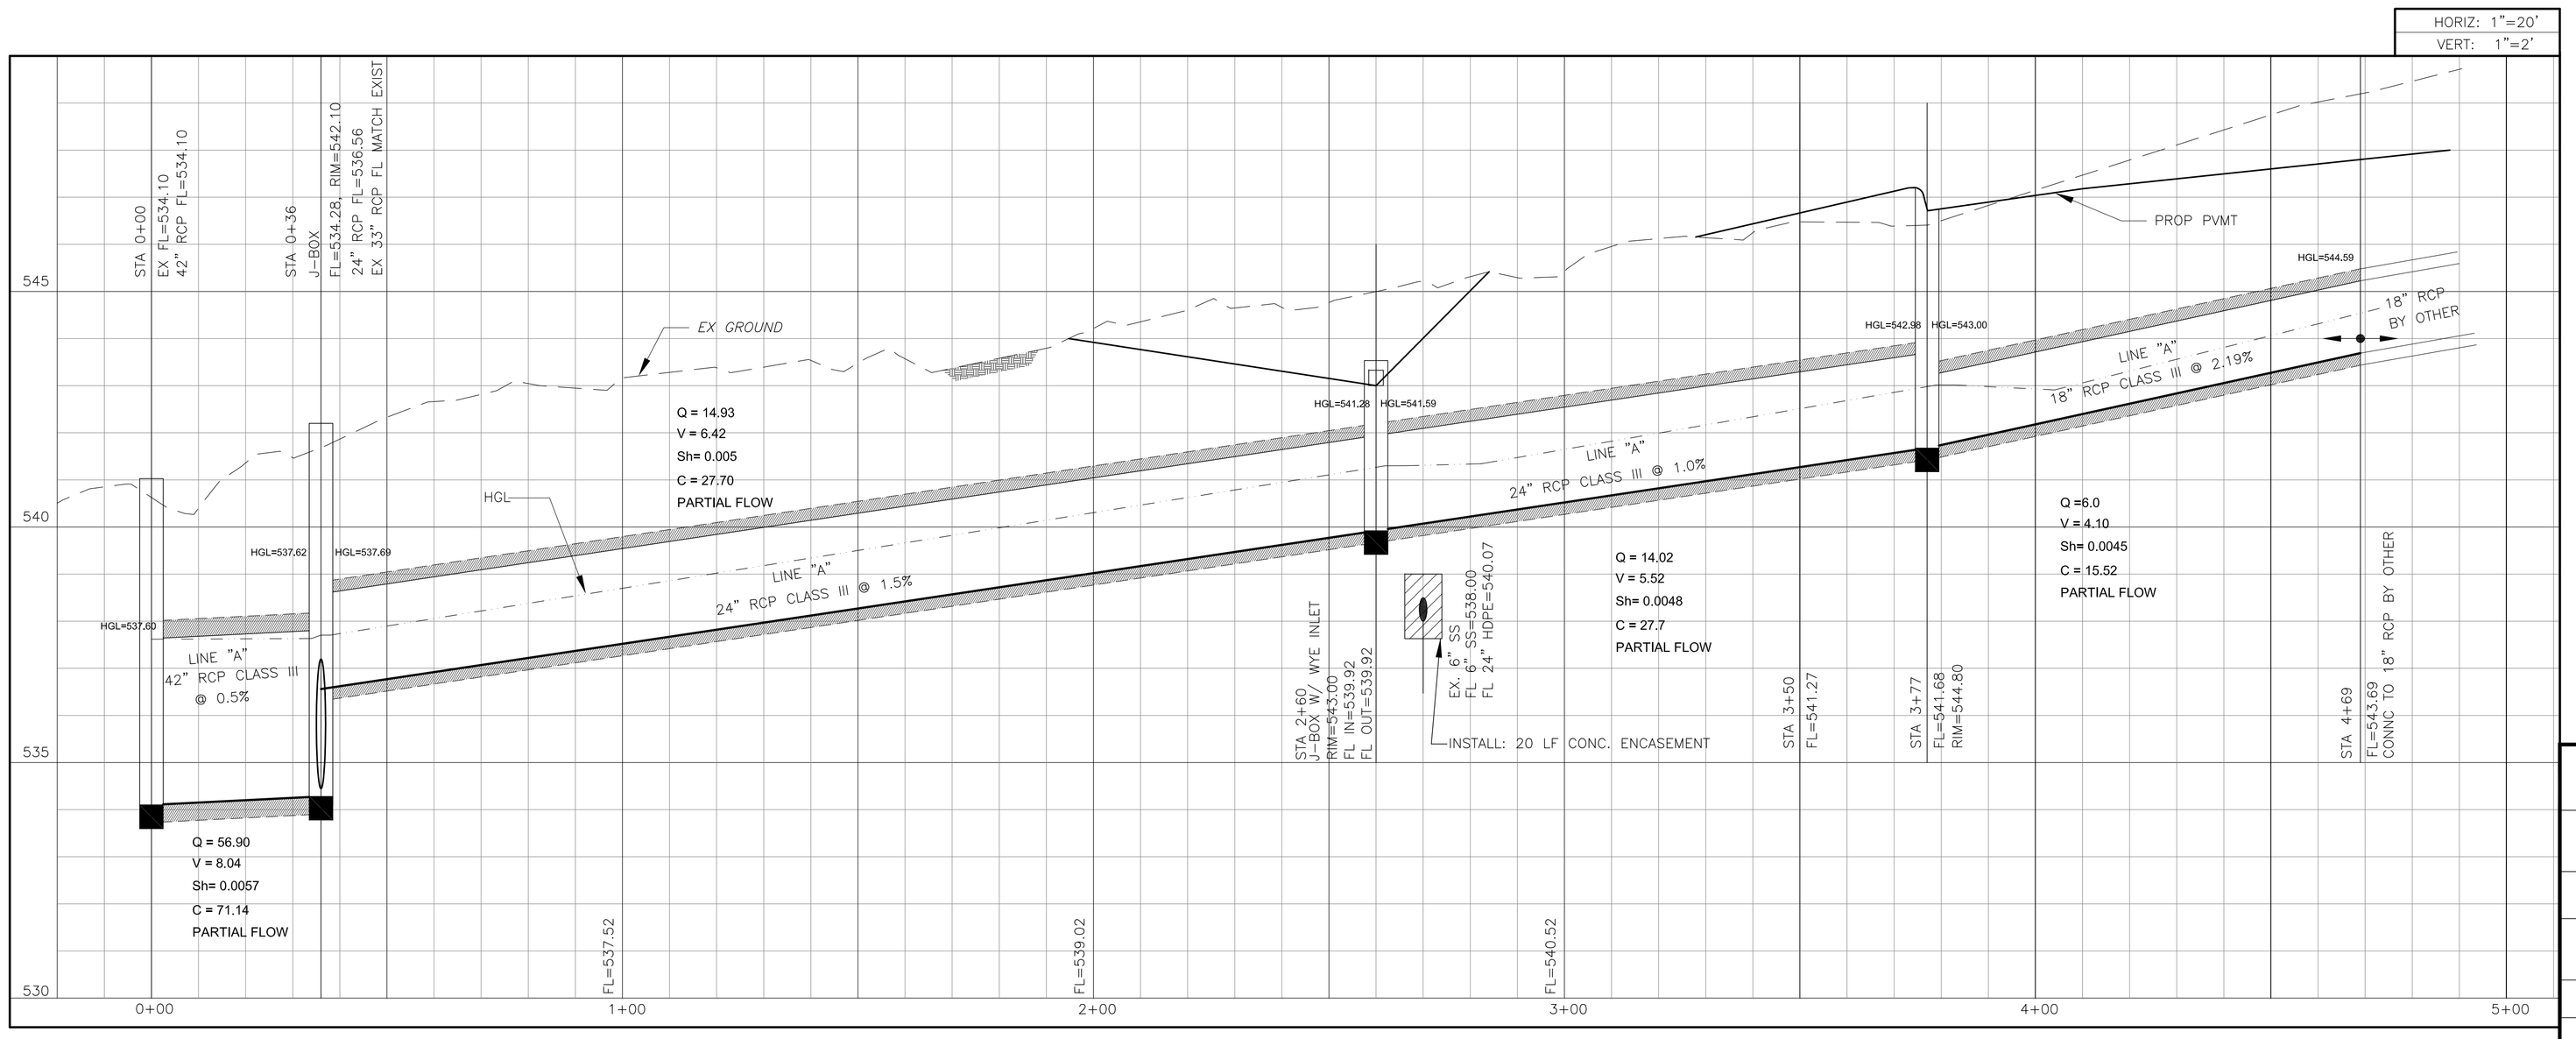

BENCHMARK

TOP NORTHEAST CORNER OF CONCRETE WYE INLET LOCATED IN SOUTHWEST CORNER OF HOME DEPOT

ELEV = 540.69

AS BUILT

THIS IS TO CERIFY THAT CHANGES AND CORRECTIONS HAVE BEEN MADE TO CONFORM TO THE CONTRACTOR'S RECORD OF THIS PROJECT.

STATE OF TEXAS
PRAWIN DISKULNETIVITYA
104609
LICENSED
PROFESSIONAL ENGINEER
7.5.11

PSA ENGINEERING
F-6974

NOTE:
ALL RESPONSIBILITY FOR ADEQUACY OF DESIGN REMAINS WITH THE DESIGN ENGINEER. THE CITY OF ROCKWALL, IN REVIEWING AND RELEASING PLANS FOR CONSTRUCTION, ASSUMES NO RESPONSIBILITY FOR ADEQUACY OR ACCURACY OF DESIGN.

DRAINAGE IMPROVEMENT PLAN

ROCKWALL MARKET CENTER SOUTH
ROCKWALL, TEXAS

GJ DEVELOPMENT, LP.
1500 E. INDUSTRIAL BOULEVARD, McKINNEY, TEXAS 75069, (972) 562-5555

PSA ENGINEERING
17819 DAVENPORT ROAD, SUITE 215 DALLAS, TX 75252 PH (972) 248-9651, FAX (972) 248-9681
T.B.P.E. REGISTRATION # F-6974, T.B.P.L.S. FIRM REGISTERED NO. 100433

DESIGN	DRAWN	DATE	SCALE	CHECK	FILE	NO.
PSA	PSA	06/22/11	AS SHOWN	PSS	21009.RMS	C-6

Y:\2010\21009.RMS\AS BUILT\C-6 DRAINAGE PLAN.dwg