SAN SEWER
SCALE H: 4
SCALE V:10.00

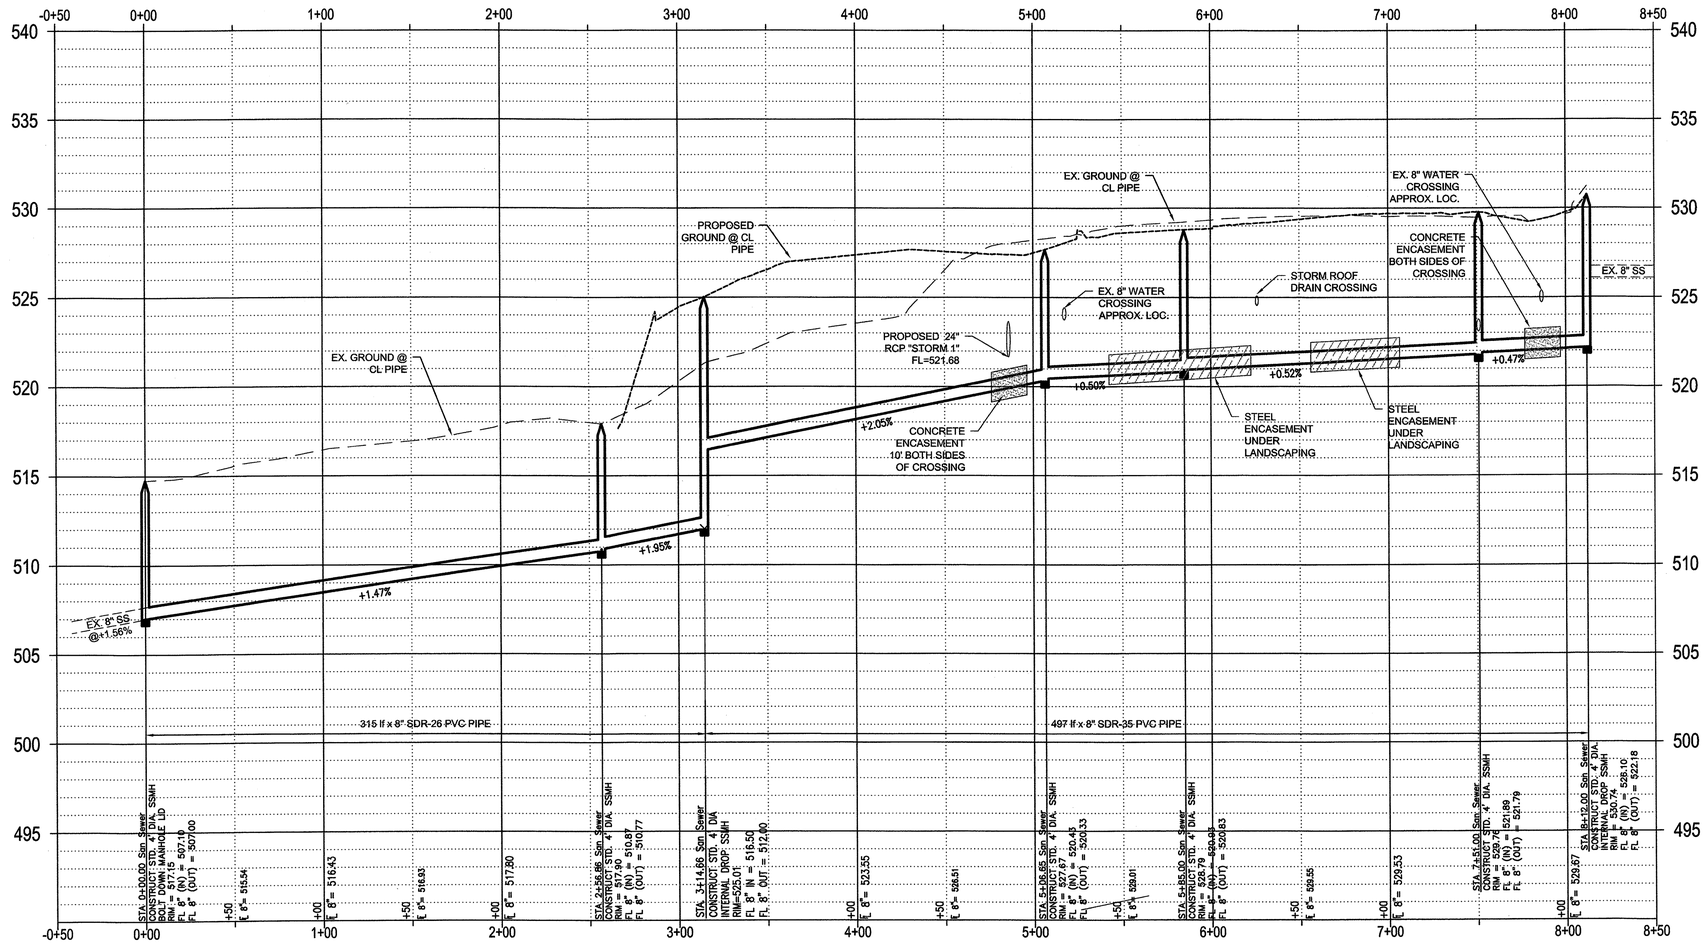

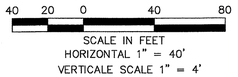

RECORD DRAWINGS

To the best of our knowledge Engineering Concepts & Design, L.P., hereby states that this plan is As-Built. This information provided is based on surveying at the site and information provided by the contractor.

Todd Wintters 6-13-19
TODD WINTTERS DATE

"Case No. SP2017-041"

BENCHMARK:
"X" CUT IN CURB 23'± SOUTH OF EAST DRIVE APPROACH OF EXISTING RAYBURN COUNTRY ELECTRIC BUILDING.

ENGINEERINGCONCEPTS & DESIGN, L.P.

ENGINEERING / PROJECT MANAGEMENT / CONSTRUCTION SERVICES - FIRM REG. #F-001145
201 WINDCO CIR, STE 200, WYLIE, TX 75098
972-941-8400 FAX: 972-941-8401 WWW.ECDLP.COM

REVISIONS:

DRAWN:	BILL	DATE:	APRIL 13, 2018
CHECKED:	TW	DATE:	APRIL 13, 2018
PROJECT NO.:	3560		
DWG FILE NAME:			

THIS DOCUMENT IS RELEASED FOR THE PURPOSE OF CONSTRUCTION.

STATE OF TEXAS
TODD WINTTERS
87085
REGISTERED PROFESSIONAL ENGINEER
4-13-18

SANITARY SEWER PROFILE
RAYBURN ELECTRIC COOP. PHASE 2
LOT 5, BLK 1 RAYBURN COUNTRY ADDITION
CITY OF ROCKWALL, ROCKWALL COUNTY, TEXAS

SHEET 14 OF 20