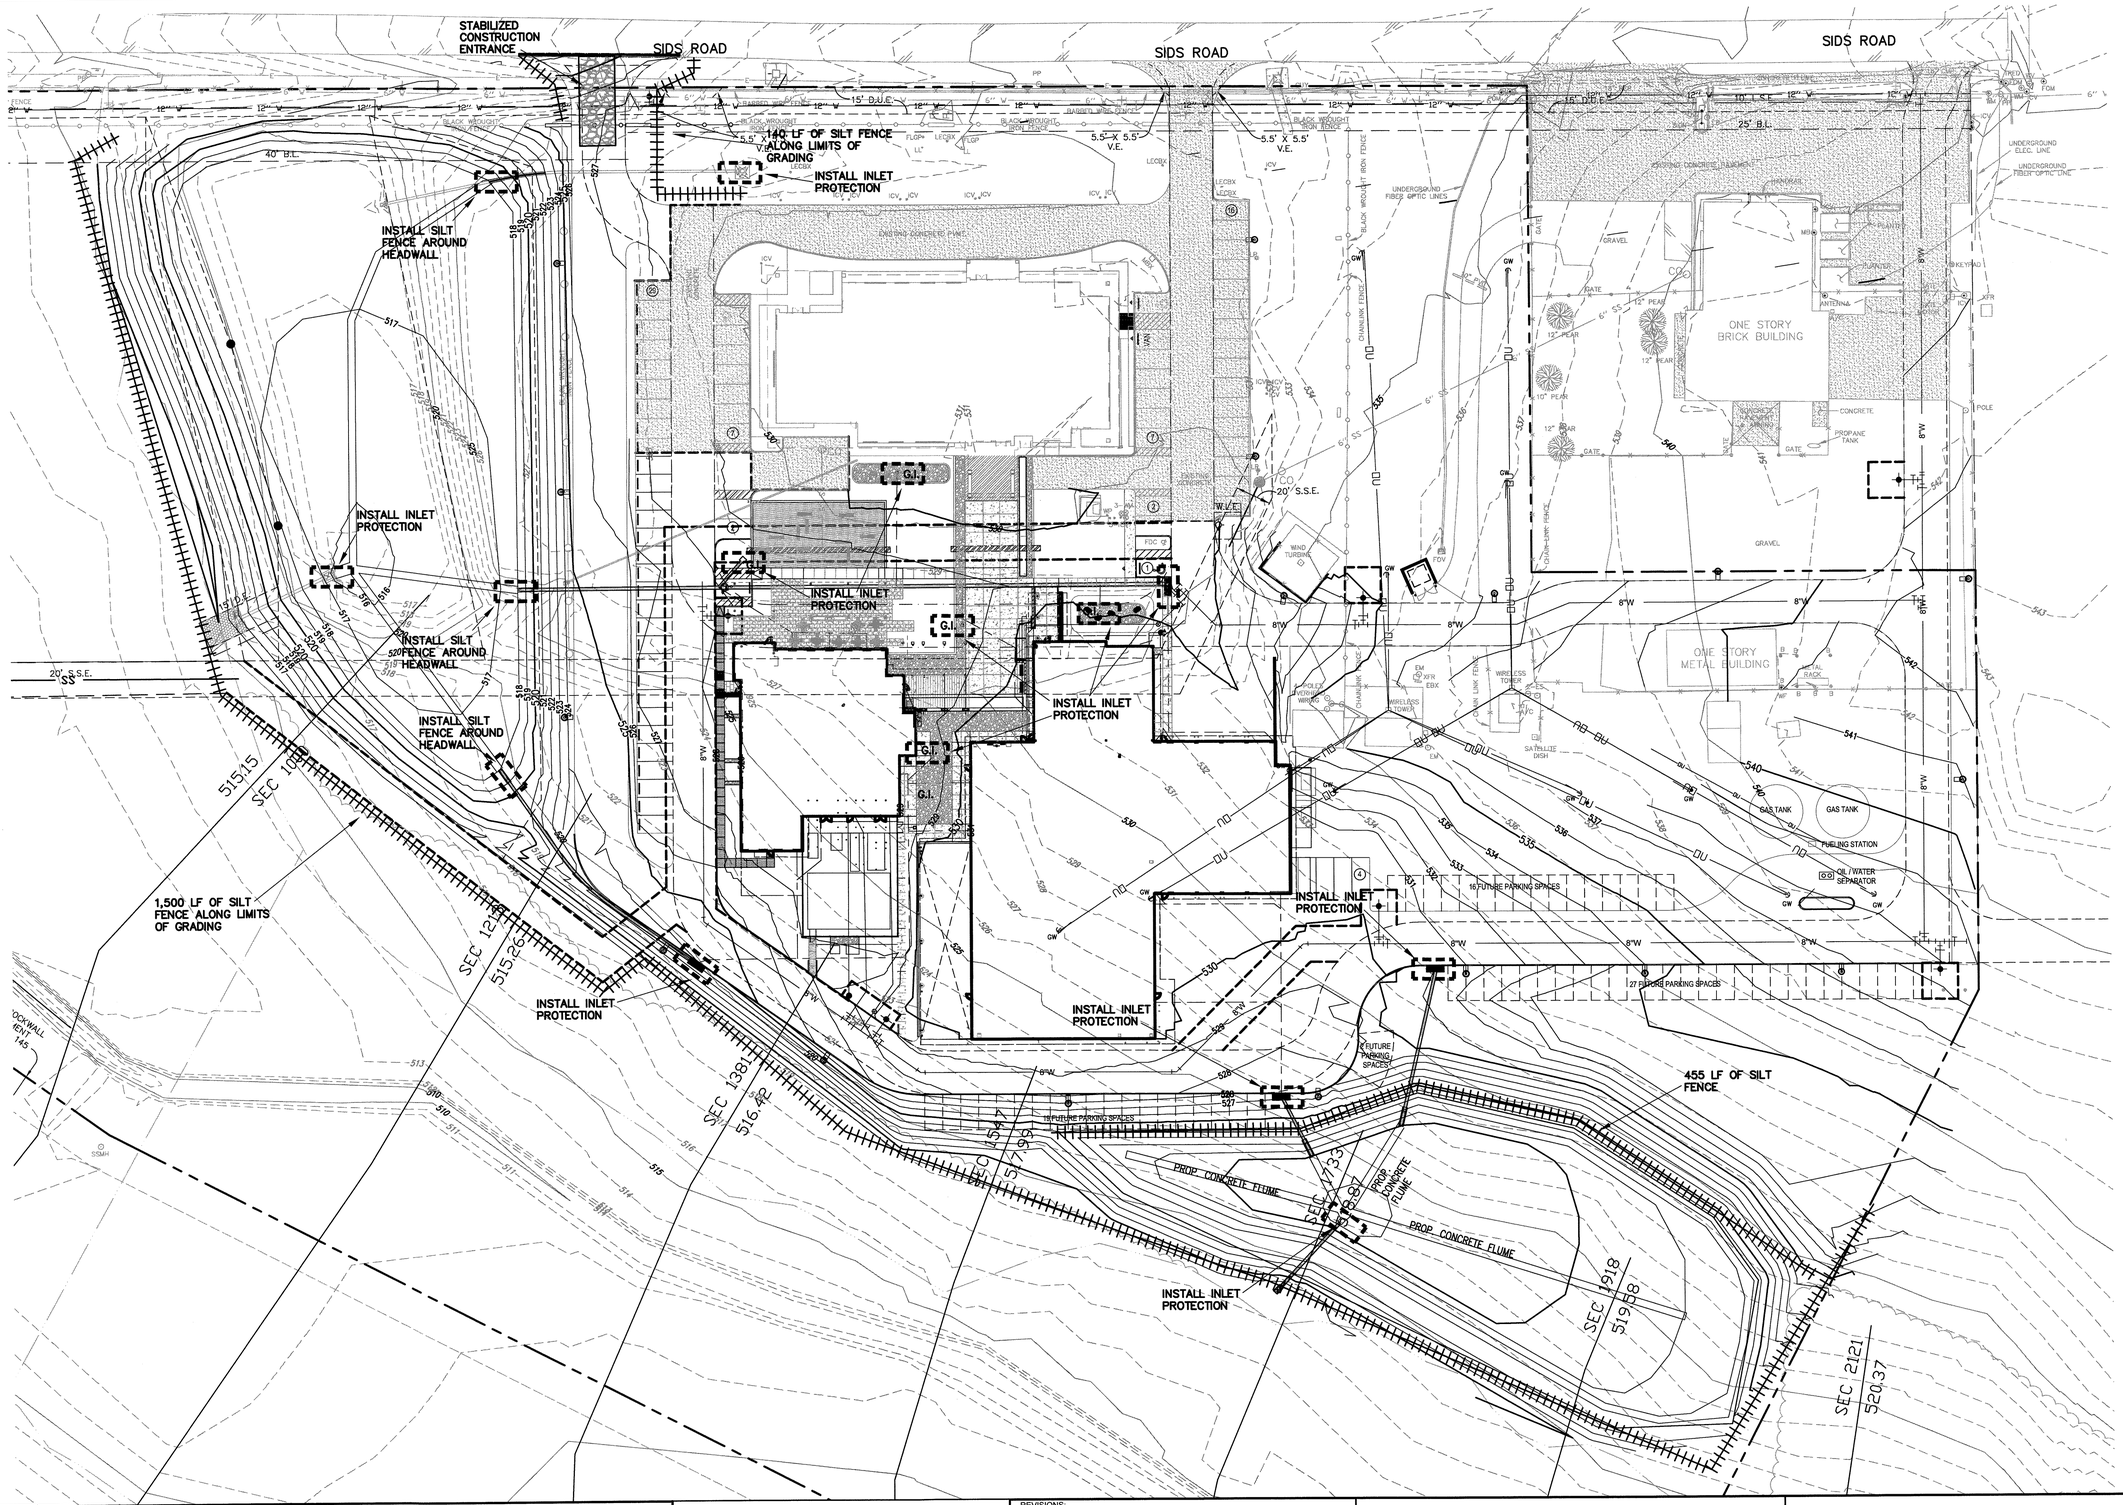

SCALE IN FEET
1" = 40'

NOTE:

ALL DISTURBED AREAS TO HAVE GRASS ESTABLISHED AT A HEIGHT OF 1" AND 80% COVERAGE PRIOR TO FINAL ENGINEERING ACCEPTANCE.

LEGEND:

- SILT FENCE
- INLET PROTECTION
- CONSTRUCTION ENTRANCE

REFER TO SHEET 20 FOR EROSION CONTROL DETAILS

RECORD DRAWINGS

To the best of our knowledge Engineering Concepts & Design, L.P., hereby states that this plan is As-Built. This information provided is based on surveying at the site and information provided by the contractor.

TODD WINTTERS 6-13-19
TODD WINTTERS DATE

"Case No. SP2017-041"

BENCHMARK:
"X" CUT IN CURB 23'± SOUTH OF EAST DRIVE APPROACH OF EXISTING RAYBURN COUNTRY ELECTRIC BUILDING.

ENGINEERINGCONCEPTS & DESIGN, L.P.
ENGINEERING / PROJECT MANAGEMENT / CONSTRUCTION SERVICES - FIRM REG. #F-001145
201 WINDCO CIR, STE 200, WYLIE, TX 75098
972-941-8400 FAX: 972-941-8401 WWW.ECDLP.COM

REVISIONS:

DRAWN: BILL	DATE: APRIL 13, 2018
CHECKED: TW	DATE: APRIL 13, 2018
PROJECT NO.: 3560	
DWG FILE NAME:	

THIS DOCUMENT IS RELEASED FOR THE PURPOSE OF CONSTRUCTION.

STATE OF TEXAS
TODD D. WINTTERS
87085
REGISTERED PROFESSIONAL ENGINEER

EROSION CONTROL PLAN
RAYBURN ELECTRIC COOP. PHASE 2
LOT 5, BLK 1 RAYBURN COUNTRY ADDITION
CITY OF ROCKWALL, ROCKWALL COUNTY, TEXAS