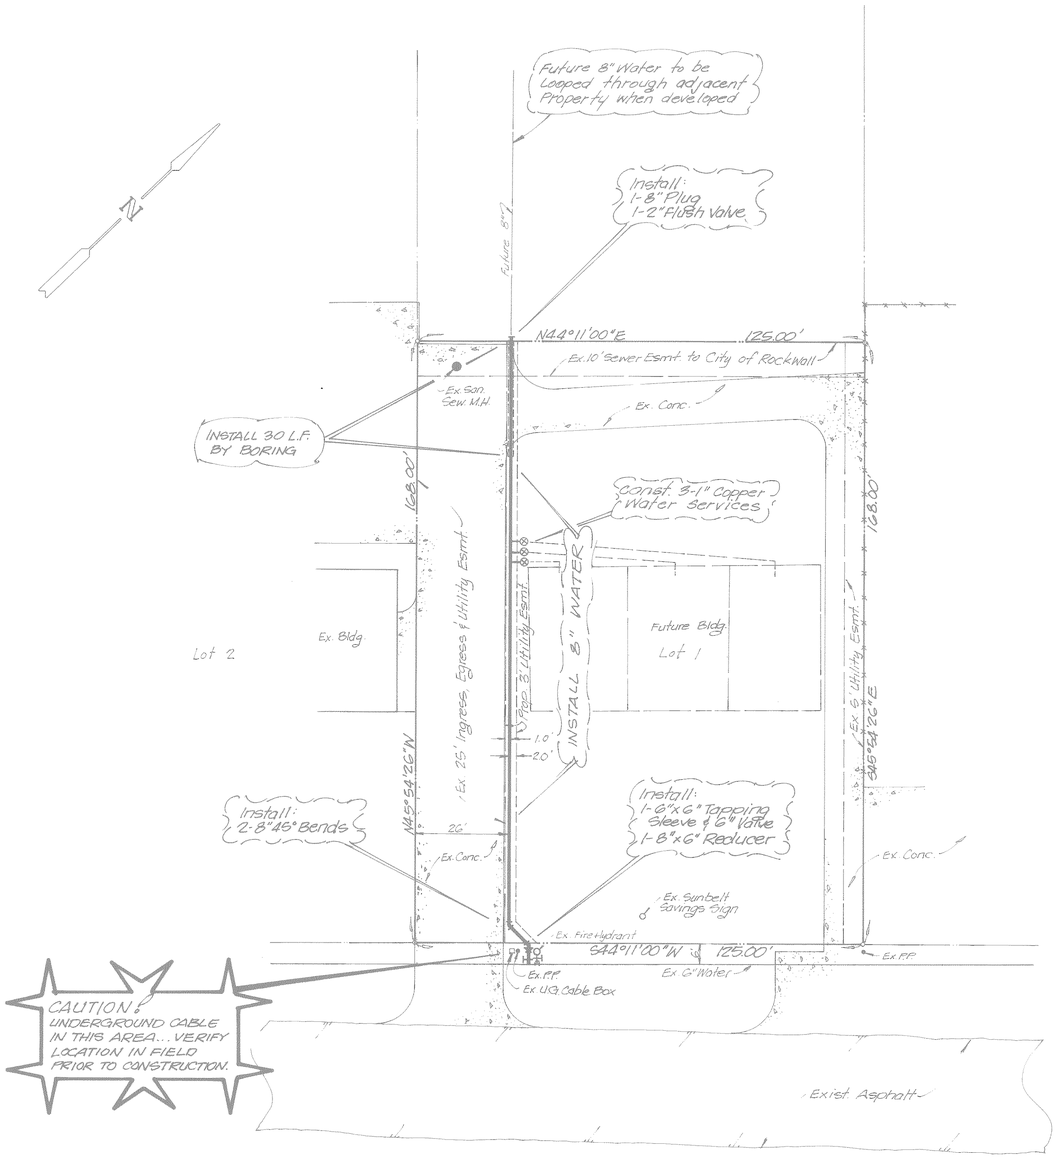

AS BUILT

HAROLD L. EVANS CONSULTING ENGINEER 2331 GUS THOMASSON RD. SUITE 102 DALLAS, TEXAS 75228 PHONE (214) 328-8133		
SCALE	DATE	JOB NO.
1"=20'	9-5-86	86158

WATER PLAN

HAYWOOD EASON~DEVELOPER

REPLAT RIDGE ROAD OFFICE PARK

ROCKWALL, ROCKWALL COUNTY, TEXAS