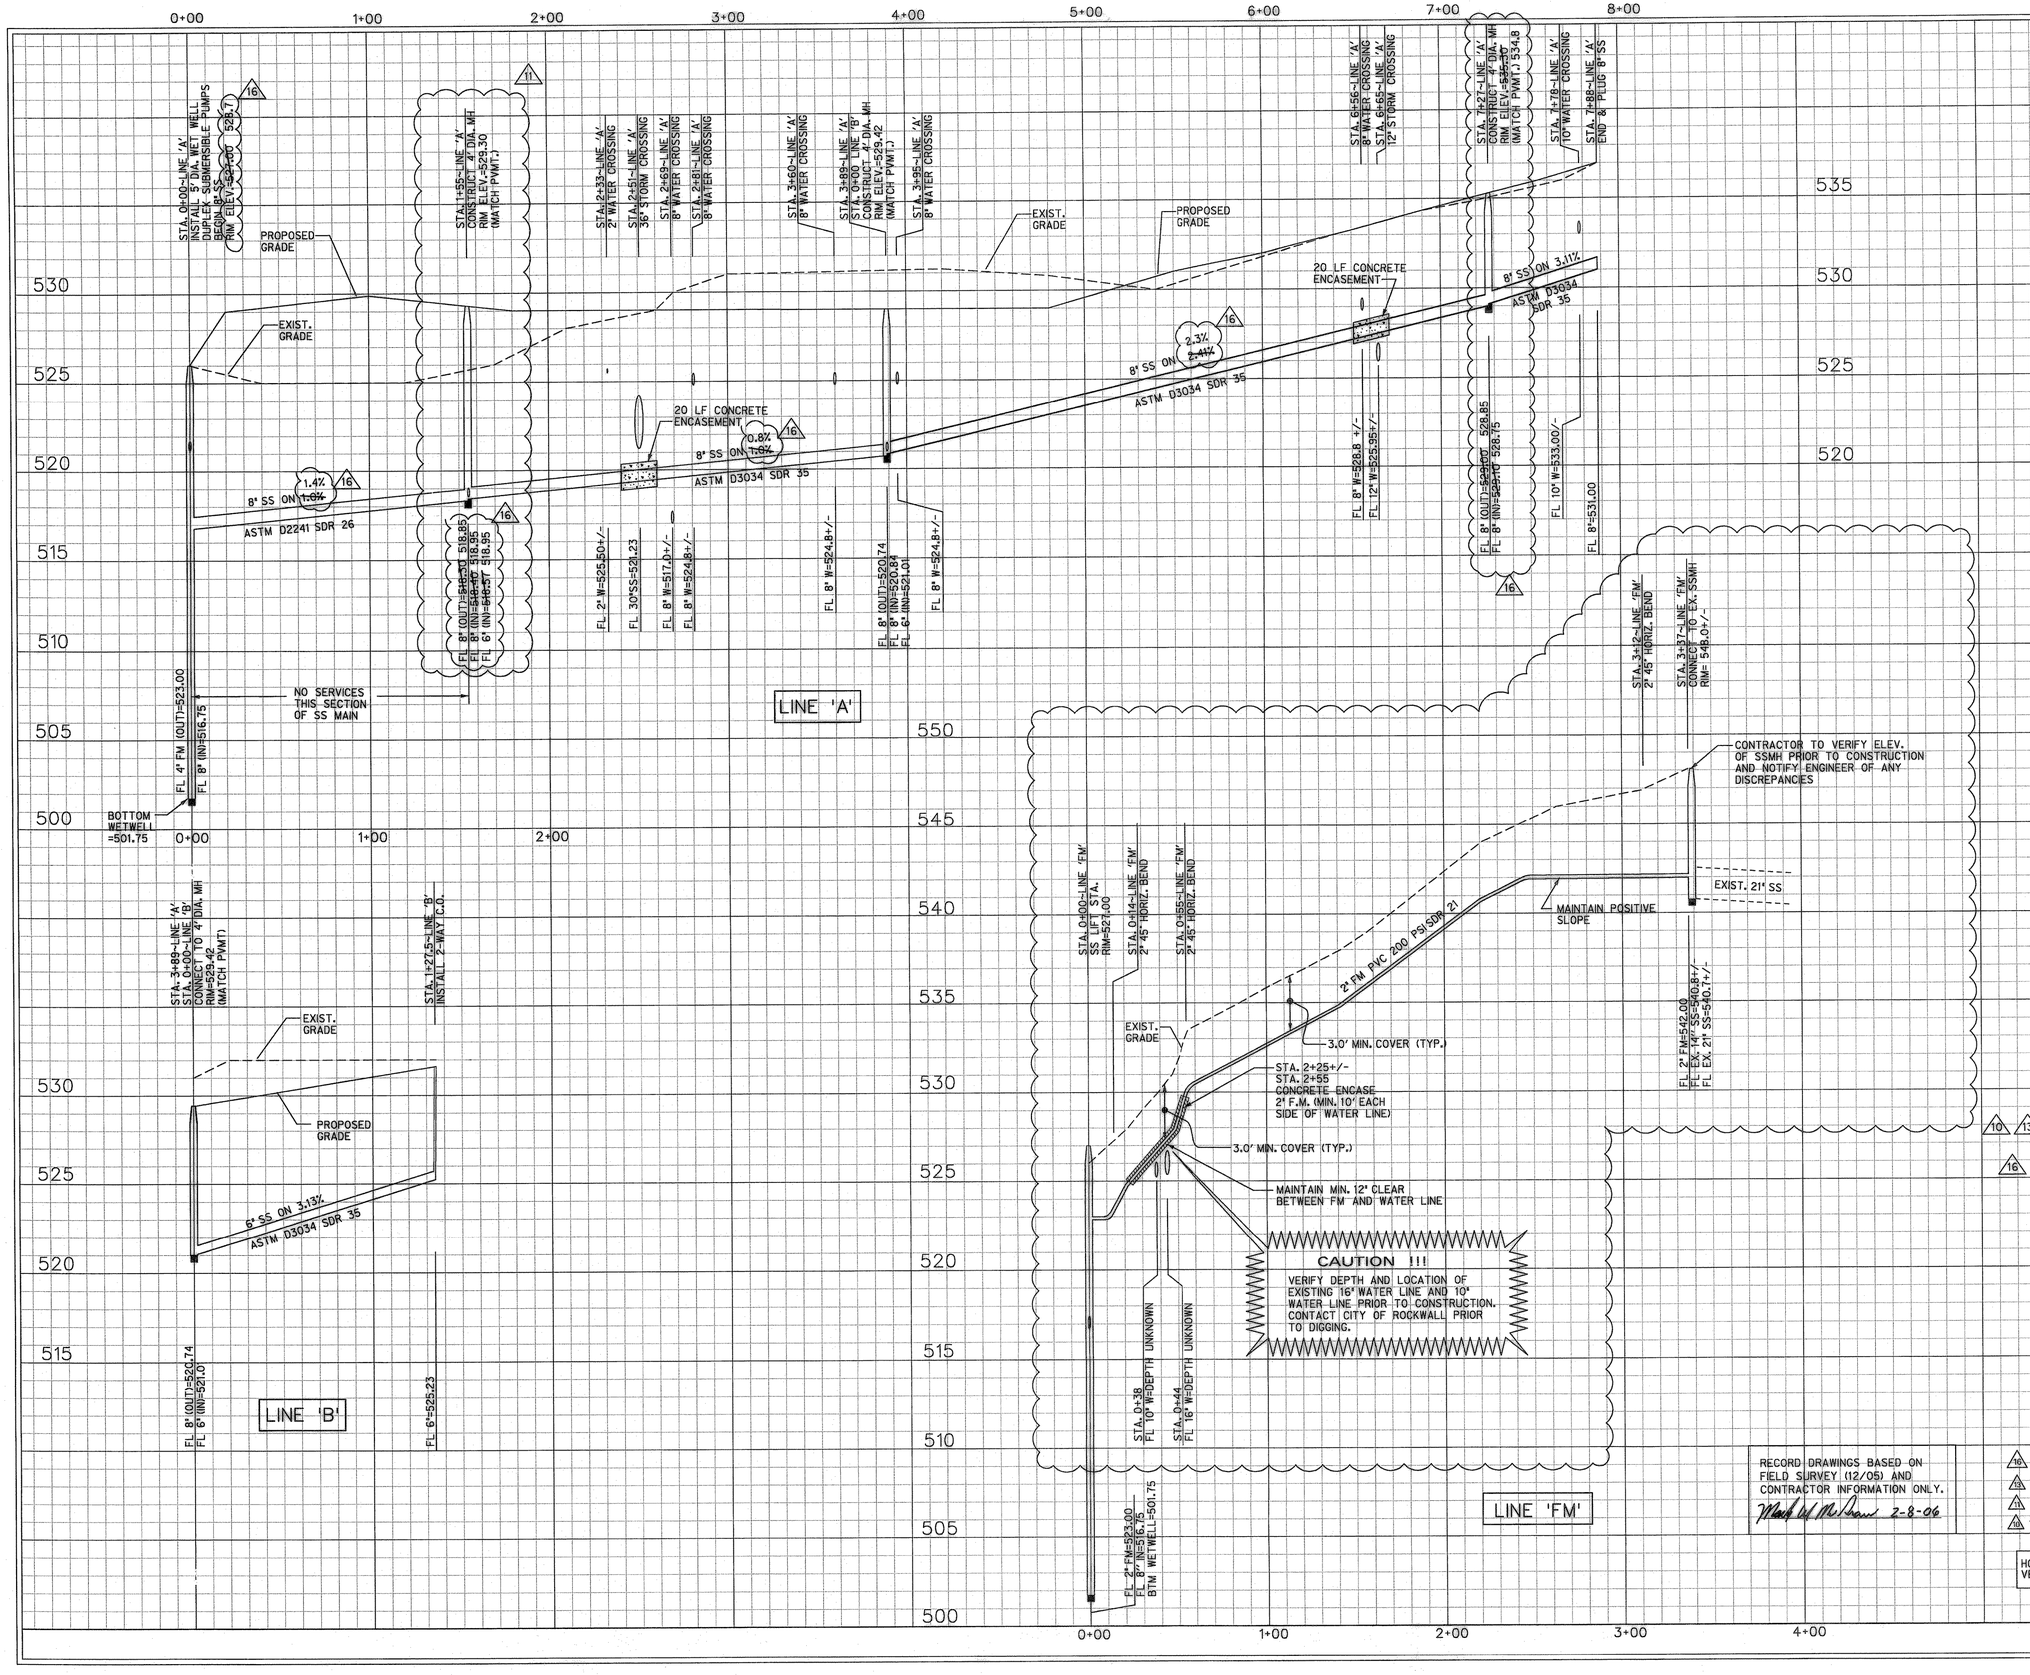

RIDGE ROAD TOWN CENTRE
ROCKWALL, TEXAS

Ridge Road Town Centre Partners, L.P.
by its General Partners:
RIDGE ROAD PARTNERS L.L.C.

Vigor PROPERTIES INC.

MARK W. McGRAW
83967
LICENSED PROFESSIONAL ENGINEER
10-26-04

Halff Associates, Inc.
ENGINEERS · ARCHITECTS · SCIENTISTS · PLANNERS · SURVEYORS
8616 NORTHWEST PLAZA DRIVE
DALLAS, TEXAS 75225
TEL (214) 346-6200
FAX (214) 739-0095

Project No:	AVO # 20817
Issued:	

Revisions:		
No.	Date	Description
1	110402	FIRST SUBMITTAL
2	40803	SECOND SUBMITTAL
3	50903	THIRD SUBMITTAL
4	60903	FOURTH SUBMITTAL
5	30204	FIFTH SUBMITTAL
7	102604	SEVENTH SUBMITTAL

Drawn by:
Checked by:

Sheet Title
SANITARY SEWER PROFILES

C6.2
Sheet Number

16 02-08-06 RECORD DRAWINGS
15 12-29-04 REV. LIFT STA. & F.M. PER COMMENTS
11 12-13-04 ELIM. DROP MH
10 12-13-04 REV. F.M. DISCH. LOC.