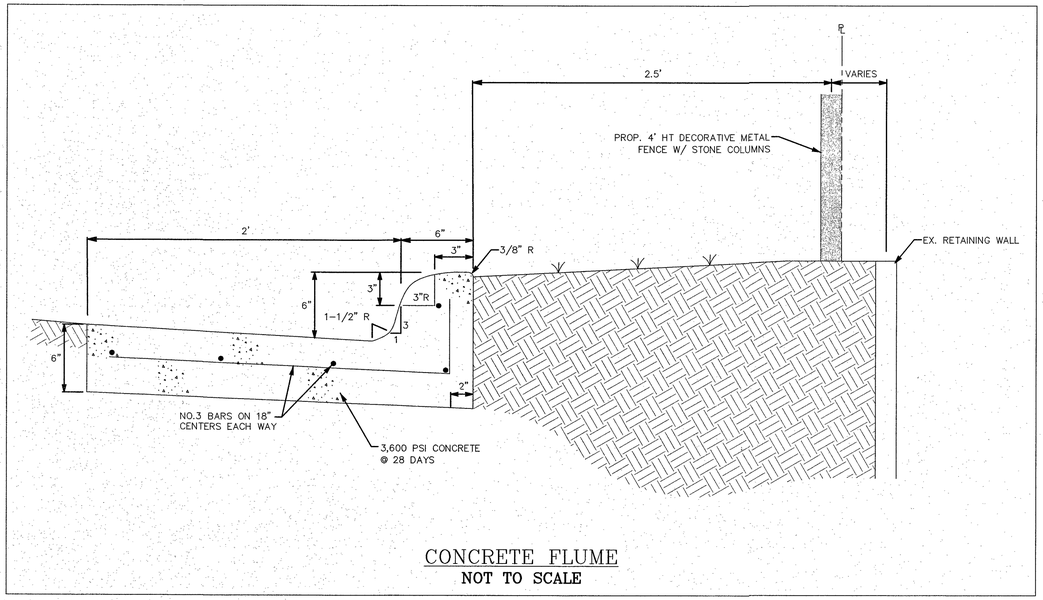

CONCRETE FLUME
NOT TO SCALE

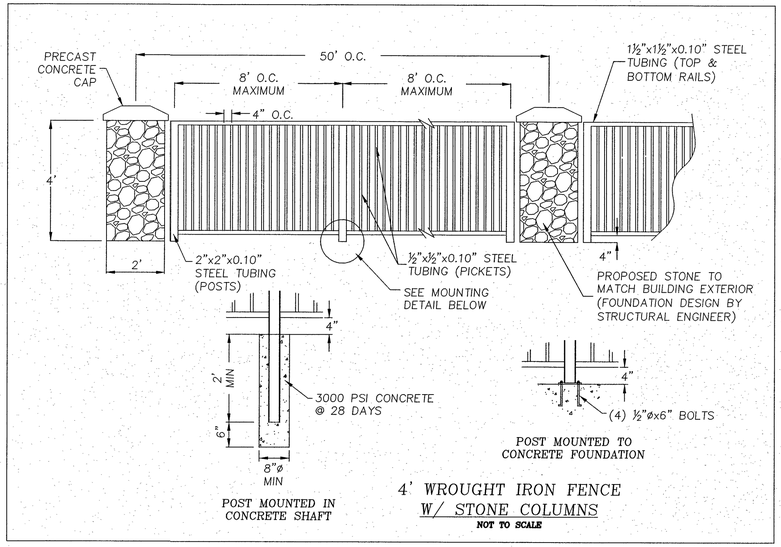

4' WROUGHT IRON FENCE
W/ STONE COLUMNS
NOT TO SCALE

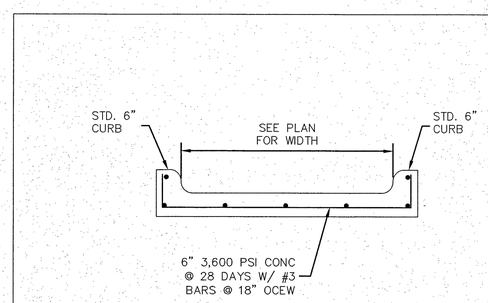

CURB OPENING DETAIL
NOT TO SCALE

ADS INLET INFORMATION	
DESCRIPTION	PRODUCT #
12" SQUARE BASIN	1212SD2
12" SQUARE RISER	1206SD
12" ATRIUM GRATE	1203SDG
18" SQUARE BASIN	1818SD2
18" SQUARE RISER	1806SD
18" ATRIUM GRATE	1803SDG
24" SQUARE BASIN	2424SD2
24" SQUARE RISER	2406SD
24" SQUARE GRATE	2402SDG

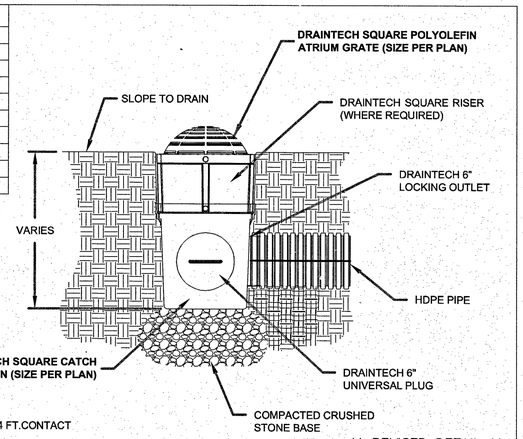

NOTES:
1. MAX COVER OVER TOP OF PIPE IS 4 FT.CONTACT ADS IF OTHERWISE GREATER.
2. GRATE OR LID MUST BE INSTALLED PRIOR TO BACKFILLING

** REVISED DETAIL **

© 2007 ADS, INC.

REV.	DESCRIPTION	BY	MM/DD/YY	CHK'D
1	UPDATED DRAWING	TJR	09/13/07	CKS

ADVANCED DRAINAGE SYSTEMS, INC. ("ADS") HAS PREPARED THIS DETAIL BASED ON INFORMATION PROVIDED TO ADS. THIS DRAWING IS INTENDED TO DEPICT THE COMPONENTS AS REQUESTED. ADS HAS NOT PERFORMED ANY ENGINEERING OR DESIGN SERVICES FOR THIS PROJECT, NOR HAS ADS INDEPENDENTLY VERIFIED THE INFORMATION SUPPLIED. THE INSTALLATION DETAILS PROVIDED HEREIN ARE GENERAL RECOMMENDATIONS AND ARE NOT SPECIFIC FOR THIS PROJECT. THE DESIGN ENGINEER SHALL REVIEW THESE DETAILS PRIOR TO CONSTRUCTION. IT IS THE DESIGN ENGINEERS RESPONSIBILITY TO ENSURE THE DETAILS PROVIDED HEREIN MEETS OR EXCEEDS THE APPLICABLE NATIONAL, STATE, OR LOCAL REQUIREMENTS AND TO ENSURE THAT THE DETAILS PROVIDED HEREIN ARE ACCEPTABLE FOR THIS PROJECT.

DRAINTECH SQ.CB W/CORR. PIPE & SQUARE GR. (LANDSCAPE APP.)
DRAWING NUMBER: STD-1103B (REVISED)

ADS
ADVANCED DRAINAGE SYSTEMS, INC.
4640 TRUEMAN BLVD
HILLIARD, OHIO 43026

DRAWN BY:	JCB
DATE:	09.22.05
SCALE:	NTS
SHEET	OF

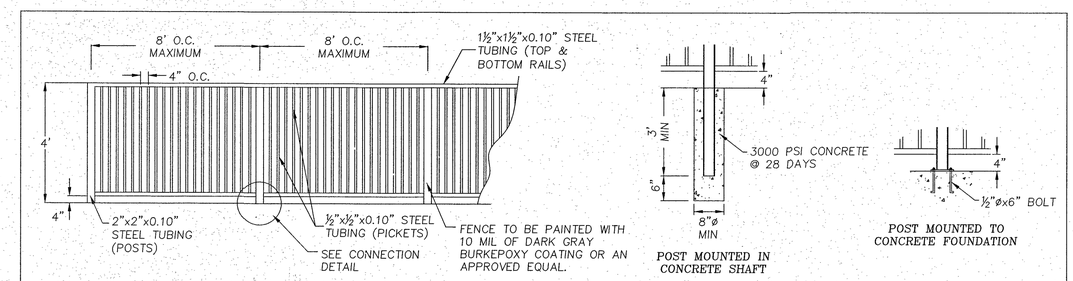

3.5' ORNAMENTAL METAL FENCE
NOT TO SCALE

NOTE:
THE CITY OF ROCKWALL CONSTRUCTION STANDARDS & NCTCOG 3RD EDITION APPLY, WHETHER INDICATED ON THESE PLANS OR NOT.

RECORD DRAWING
TO THE BEST OF OUR KNOWLEDGE, HOMEYER ENGINEERING, INC., HEREBY STATES THAT THIS PLAN IS A RECORD DRAWING. THE INFORMATION PROVIDED IS BASED ON ON-SITE SURVEYING, SITE OBSERVATIONS AND INFORMATION PROVIDED BY THE CONTRACTOR.

STEVEN R. HOMEYER, P.E. #86942
DATE: 12-2-13

STATE OF TEXAS
STEVEN R. HOMEYER
86942
LICENSED
PROFESSIONAL ENGINEER
11-27-12

HOMEYER ENGINEERING, INC.
TBPE FIRM REGISTRATION NO. F-8440
P.O.BOX 294527 ♦ LEWISVILLE, TEXAS ♦ 75029
972-906-9985 PHONE ♦ 972-906-9987 FAX
WWW.HEI.US.COM

ROCK RIDGE ASSISTED LIVING AND MEMORY CARE
LOT 1R, BLOCK A,
FLAGSTONE CORNERS
CITY OF ROCKWALL
ROCKWALL COUNTY, TEXAS

MISCELLANEOUS DETAILS

DRAWN: SRH
DATE: 11/27/12
HEI #: 12-112

SHEET NO:
C24

K:\cad drawings\engineering projects\submittals\construction\3rd submittal\SP-10 details 2 - miscellaneous.dwg Friday, November 30, 2012 4:28:44 PM