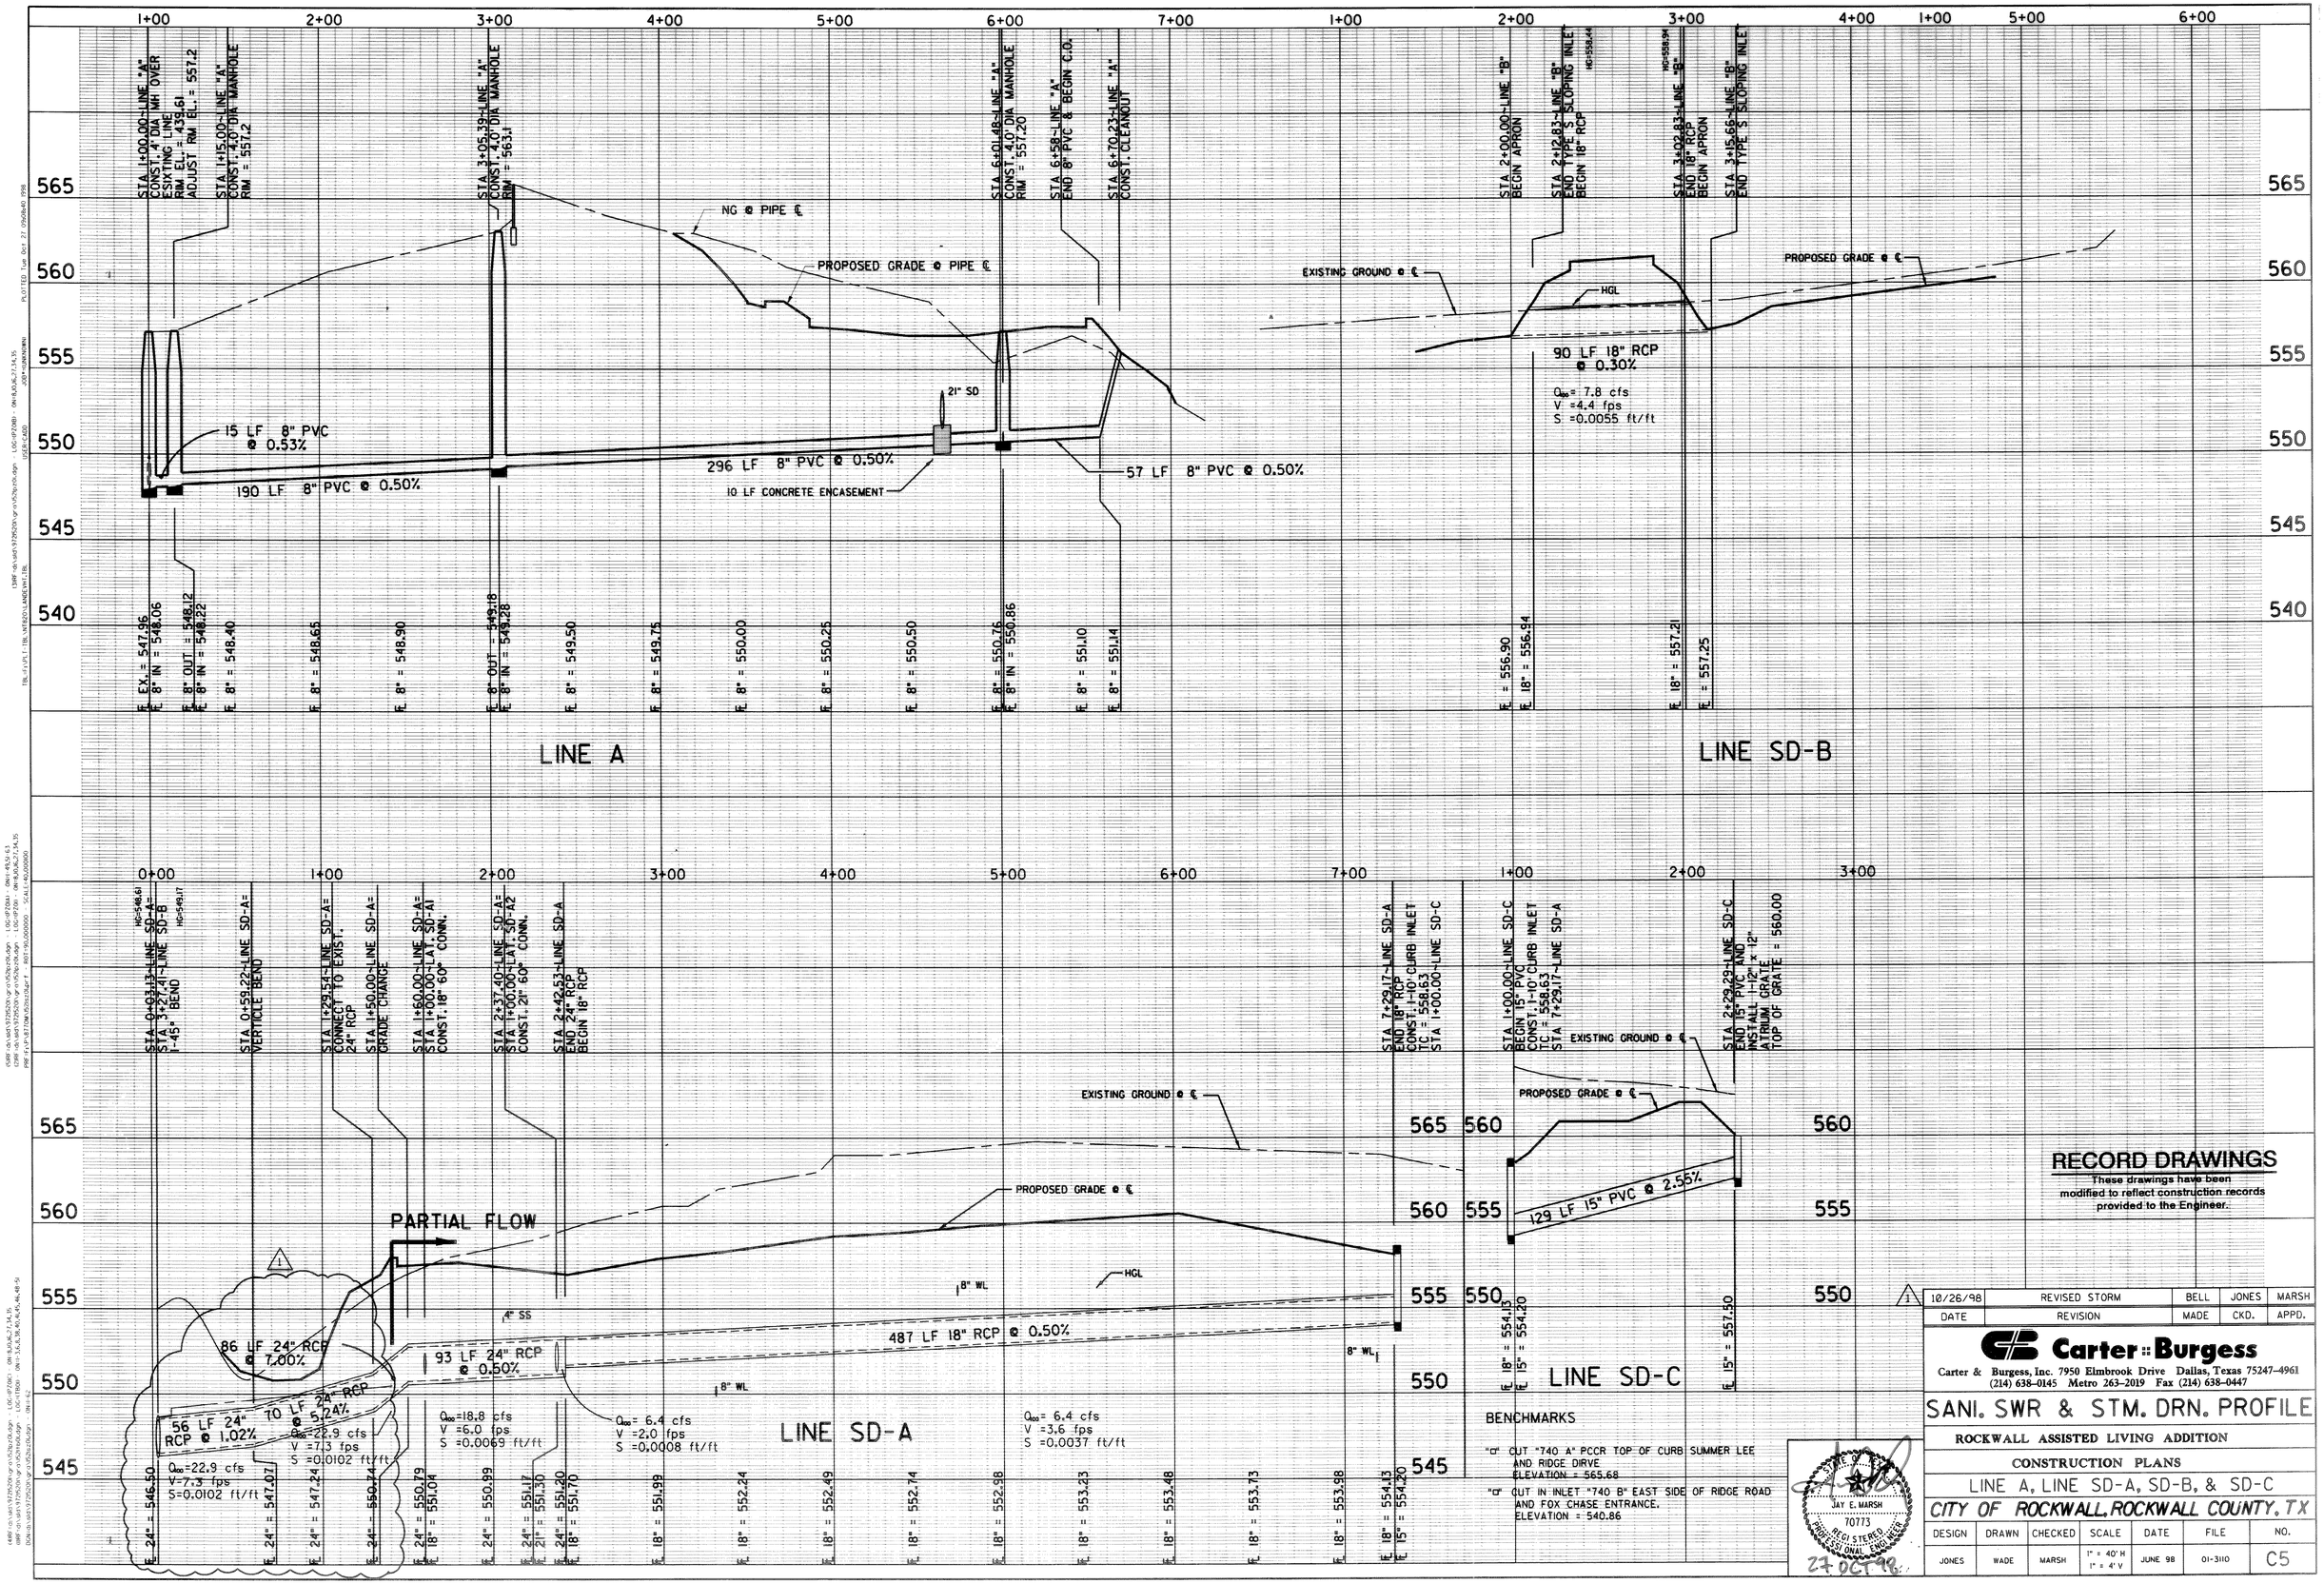

RECORD DRAWINGS

These drawings have been modified to reflect construction records provided to the Engineer.

DATE	REVISION	MADE	CKD.	APPD.
10/26/98	REVISED STORM	BELL	JONES	MARSH

JAY E. MARSH 70773 REGISTERED PROFESSIONAL ENGINEER 27 OCT 98

Carter :: Burgess

Carter & Burgess, Inc. 7950 Elmbrook Drive Dallas, Texas 75247-4961
(214) 638-0145 Metro 263-2019 Fax (214) 638-0447

SANI. SWR & STM. DRN. PROFILE

ROCKWALL ASSISTED LIVING ADDITION

CONSTRUCTION PLANS

LINE A, LINE SD-A, SD-B, & SD-C

CITY OF ROCKWALL, ROCKWALL COUNTY, TX

DESIGN	DRAWN	CHECKED	SCALE	DATE	FILE	NO.
JONES	WADE	MARSH	1" = 40' H 1" = 4' V	JUNE 98	01-3110	C5

PROJECT No. 97-2152-010

The seal appearing on this document was authorized by JAY E. MARSH, P.E. 70773 on JUNE 2, 1998. Alteration of a sealed document without proper notification to the responsible engineer is an offense under the Texas Engineering Practice Act.