CENTERLINE CURVE DATA		
CURVE #1	Δ = 19° 58'30"	
	R = 140.00'	
	L = 48.81'	
	CHORD = S36° 28'18"W	48.56'

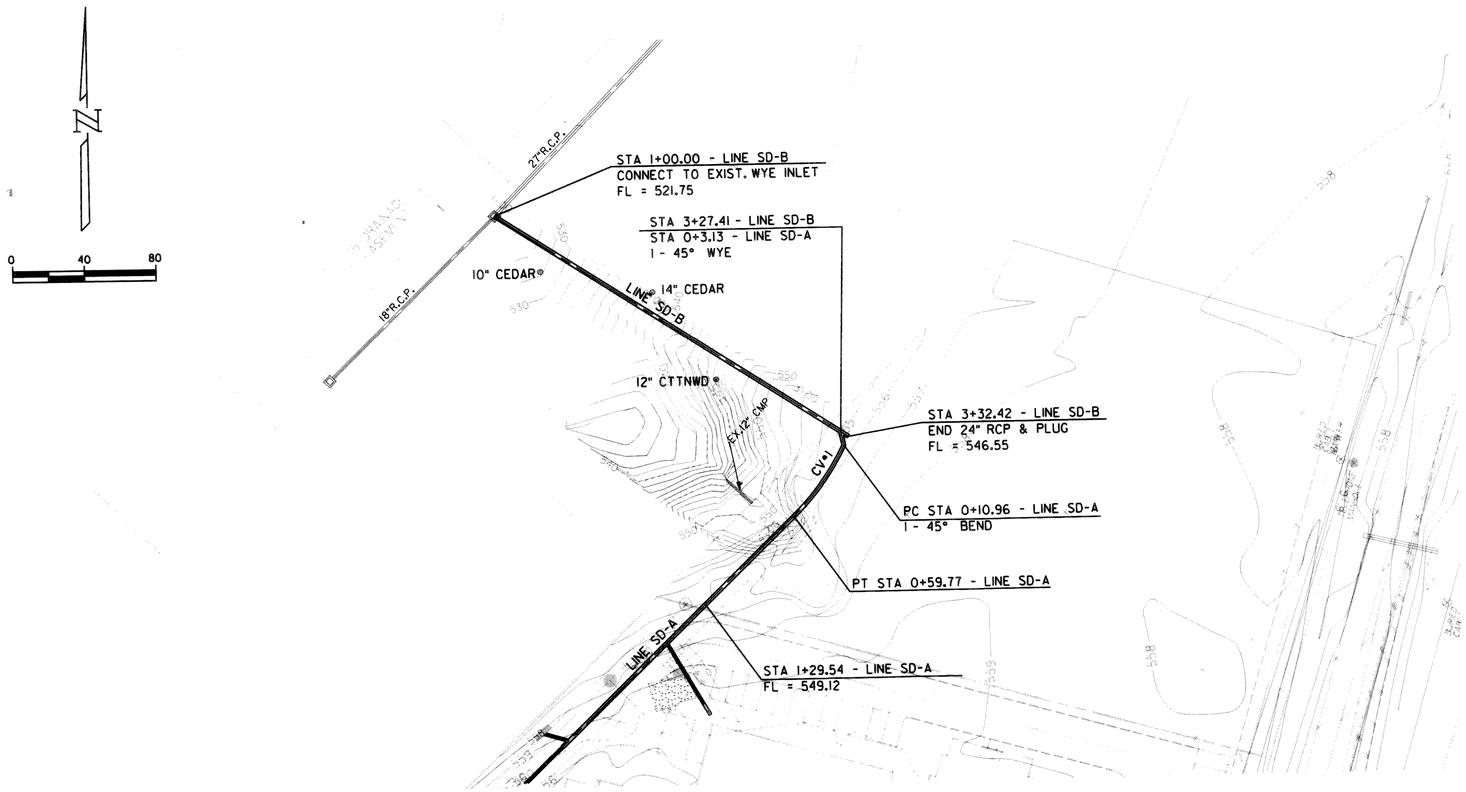

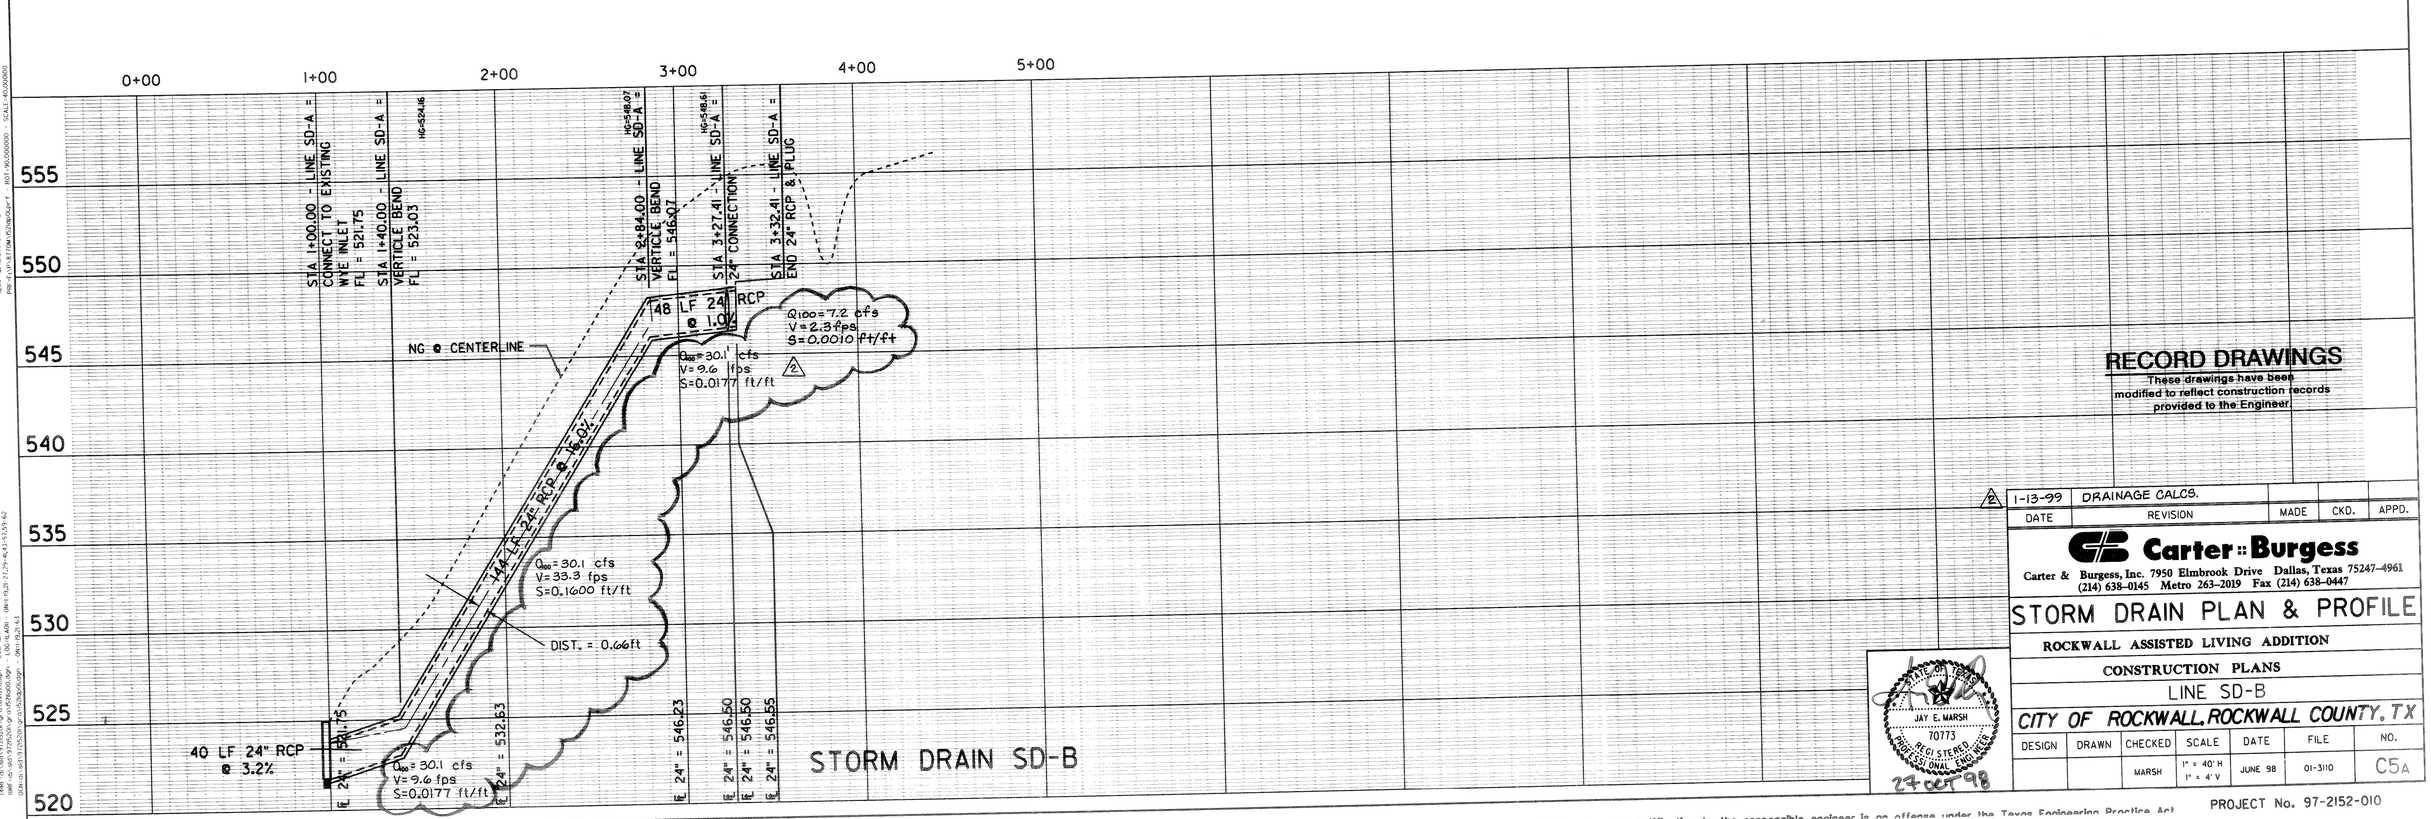

RECORD DRAWINGS

These drawings have been modified to reflect construction records provided to the Engineer.

DATE	REVISION	MADE	CKD.	APPD.
2 1-13-99	DRAINAGE CALCS.			

Carter :: Burgess

Carter & Burgess, Inc. 7950 Elmbrook Drive Dallas, Texas 75247-4961
(214) 638-0145 Metro 263-2019 Fax (214) 638-0447

STORM DRAIN PLAN & PROFILE

ROCKWALL ASSISTED LIVING ADDITION

CONSTRUCTION PLANS

LINE SD-B

CITY OF ROCKWALL, ROCKWALL COUNTY, TX

DESIGN	DRAWN	CHECKED	SCALE	DATE	FILE	NO.
		MARSH	1" = 40' H 1" = 4' V	JUNE 98	01-3110	C5A

PROJECT No. 97-2152-010

STATE OF TEXAS
JAY E. MARSH
70773
REGISTERED
PROFESSIONAL ENGINEER
27 OCT 98

Use of this sheet by JAY E. MARSH P.E. 70773 on JUNE 3 1998. Alteration of a sealed document without proper notification to the responsible engineer is an offense under the Texas Engineering Practice Act.