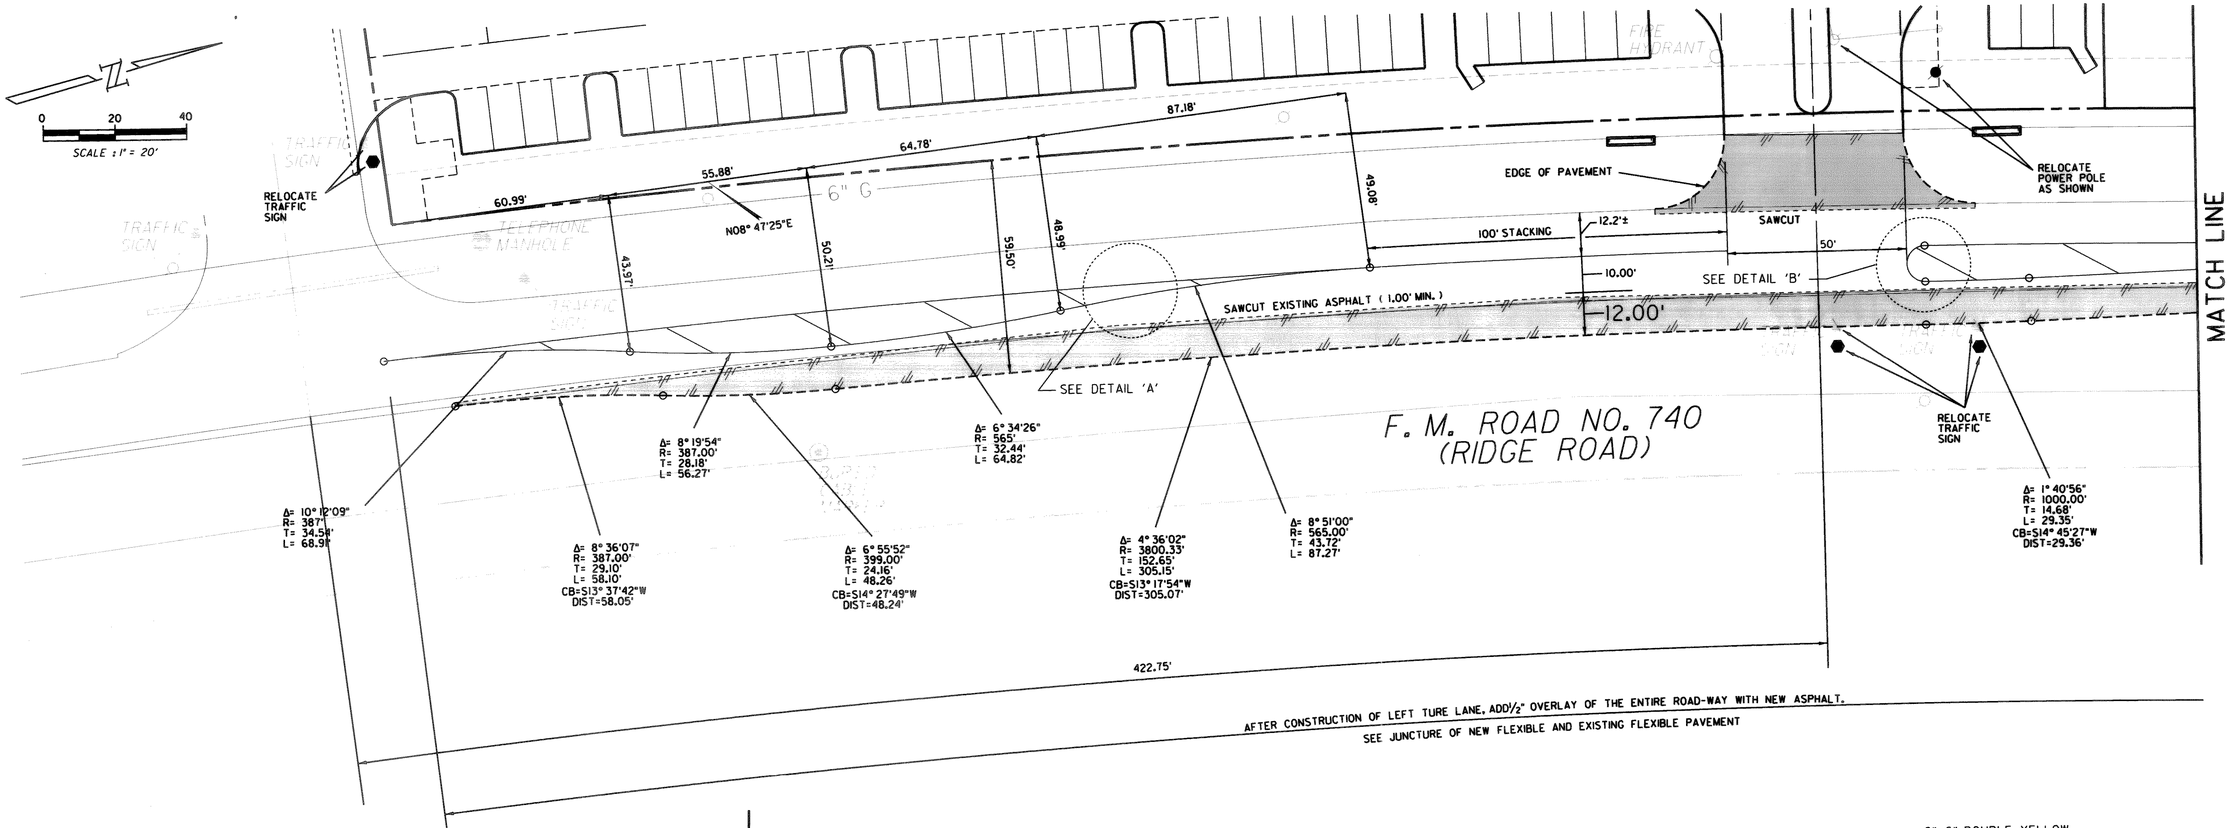

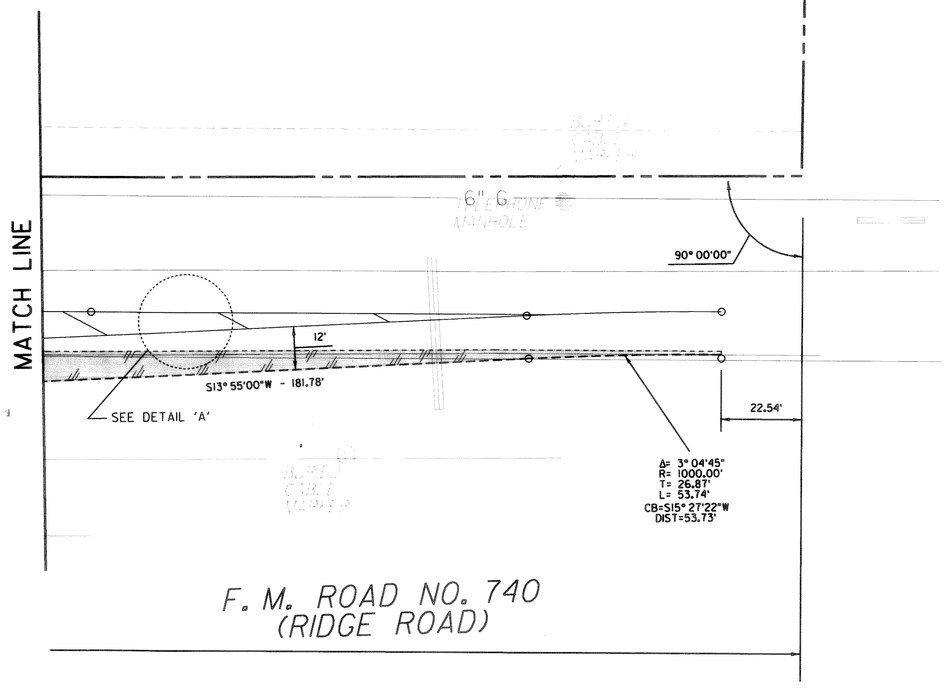

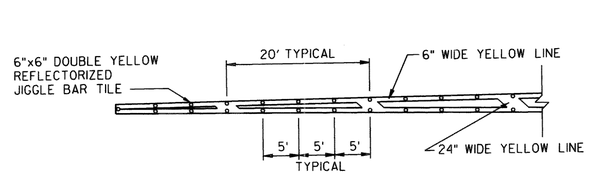

DETAIL 'A'

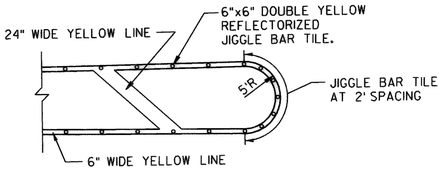

DETAIL 'B'

TAPERED STRIPE DETAILS
N.T.S.

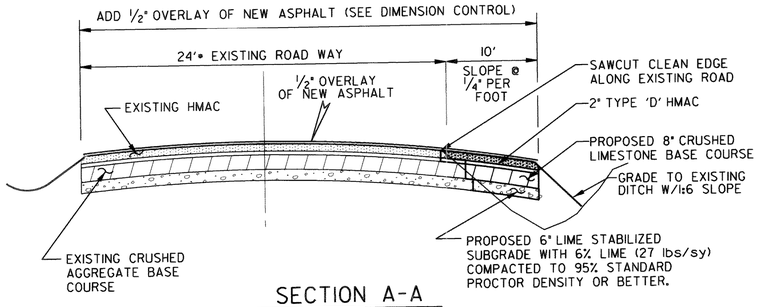

SECTION A-A
EXIST ASPHALT PAVEMENT
W/ PAVEMENT WIDENING
N.T.S.

RECORD DRAWINGS
These drawings have been modified to reflect construction records provided to the Engineer.

DATE	REVISION	MADE	CKD.	APPD.

Carter :: Burgess
Carter & Burgess, Inc. 7950 Elmbrook Drive Dallas, Texas 75247-4961
(214) 638-0145 Metro 263-2019 Fax (214) 638-0447

RIDGE ROAD LEFT TURN LANE
ROCKWALL ASSISTED LIVING ADDITION
CONSTRUCTION PLANS
CITY OF ROCKWALL, ROCKWALL COUNTY, TX

DESIGN	DRAWN	CHECKED	SCALE	DATE	FILE	NO.
STEPHEN	BAUM	MARSH	1" = 20'	JUNE 98	01-3110	C7

JAY E. MARSH 70773 REGISTERED PROFESSIONAL ENGINEER
05 JUN 98

PROJECT No. 97-2152-010

The seal appearing on this document was authorized by JAY E. MARSH, P.E. 70773, on JUNE 2, 1998. Alteration of a sealed document without proper notification to the responsible engineer is an offense under the Texas Engineering Practice Act.

PLOTTED Fri Jun 5 09:56:36 1998
USER=BaumL W JOB#=(UNKNOWN)
TBL=F:\PLT-TBL\LANDEWHT.TBL
PRF=F:\P\877OM\S2LL70LPRF - ROT=0.000000 - SCALE=20.000000
DGN=d:\dgn\9726S0\gr0\S2H10.dgn - DN=-63