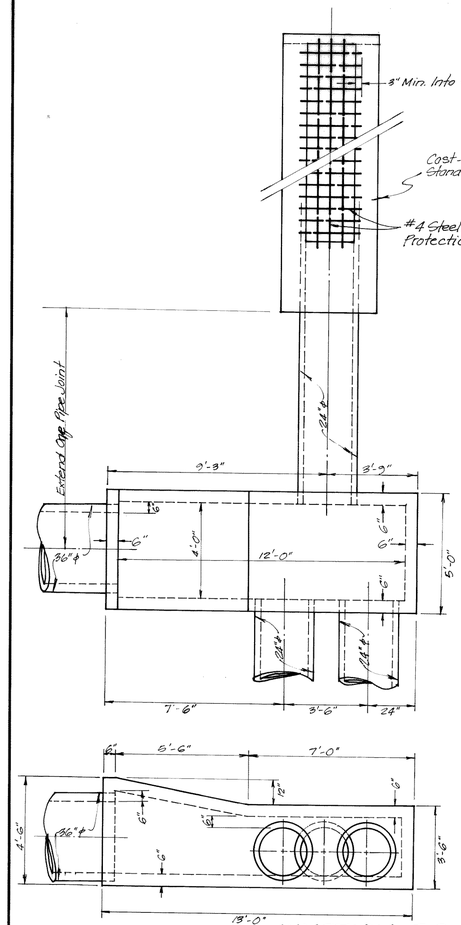

JUNCTION BOX DETAIL
SCALE 1"=3'

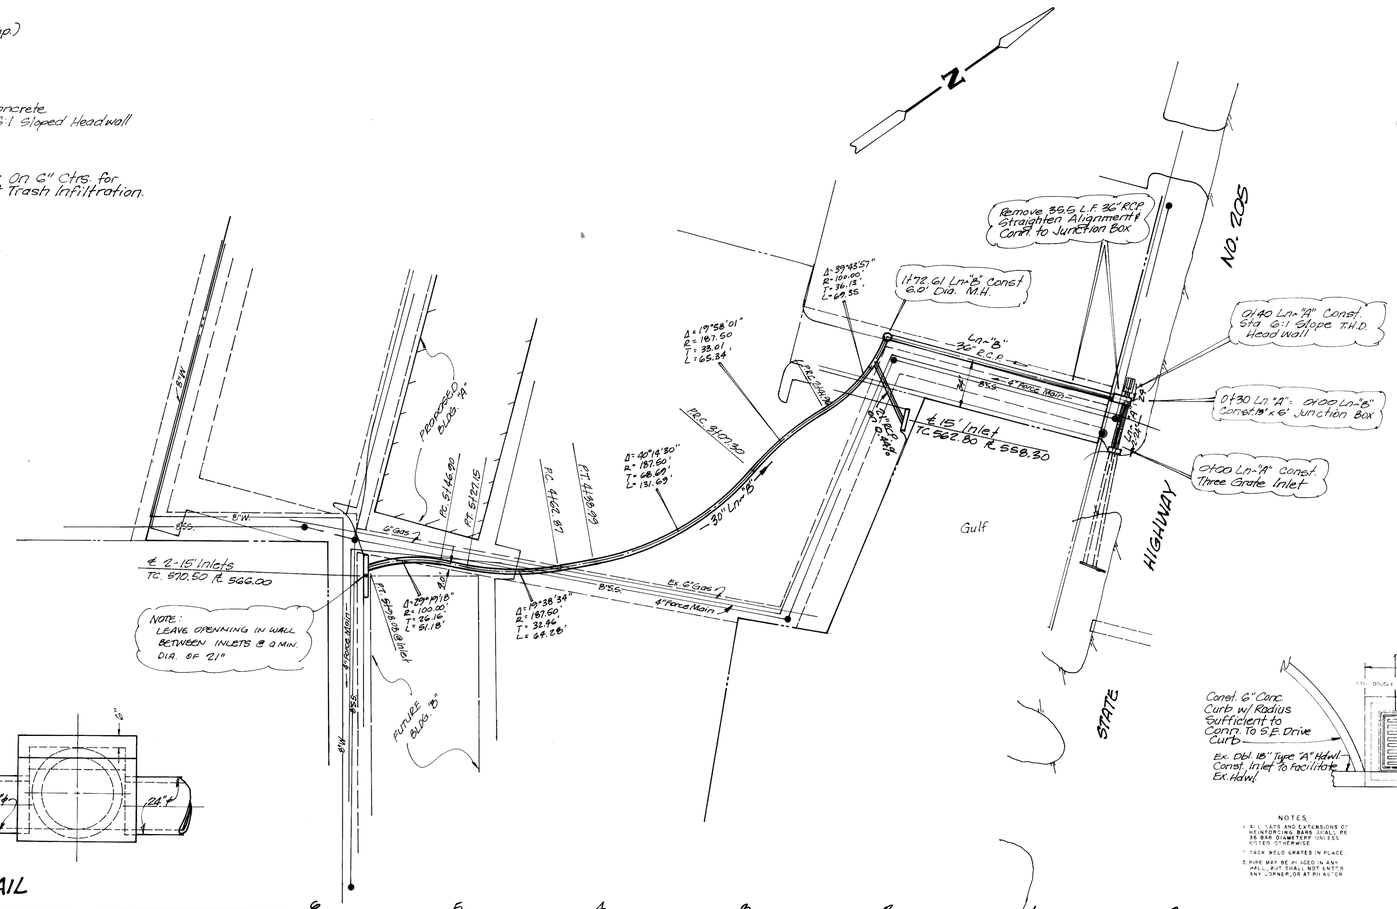

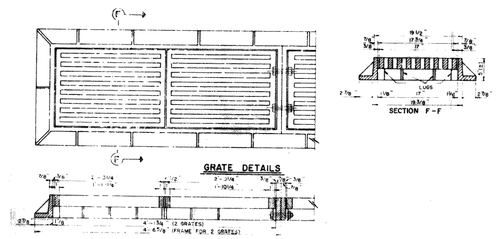

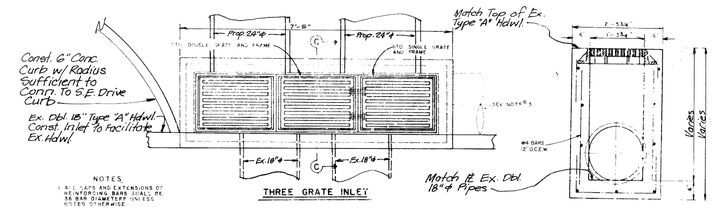

NOTES

1. ALL LAPS AND EXTENSIONS OF REINFORCING BARS SHALL BE 36 BAR DIAMETERS UNLESS NOTED OTHERWISE
2. TACK WELD GRATES IN PLACE
3. PIPE MAY BE PLACED IN ANY WALL, BUT SHALL NOT ENTER ANY CORNER, OR AT PILASTER

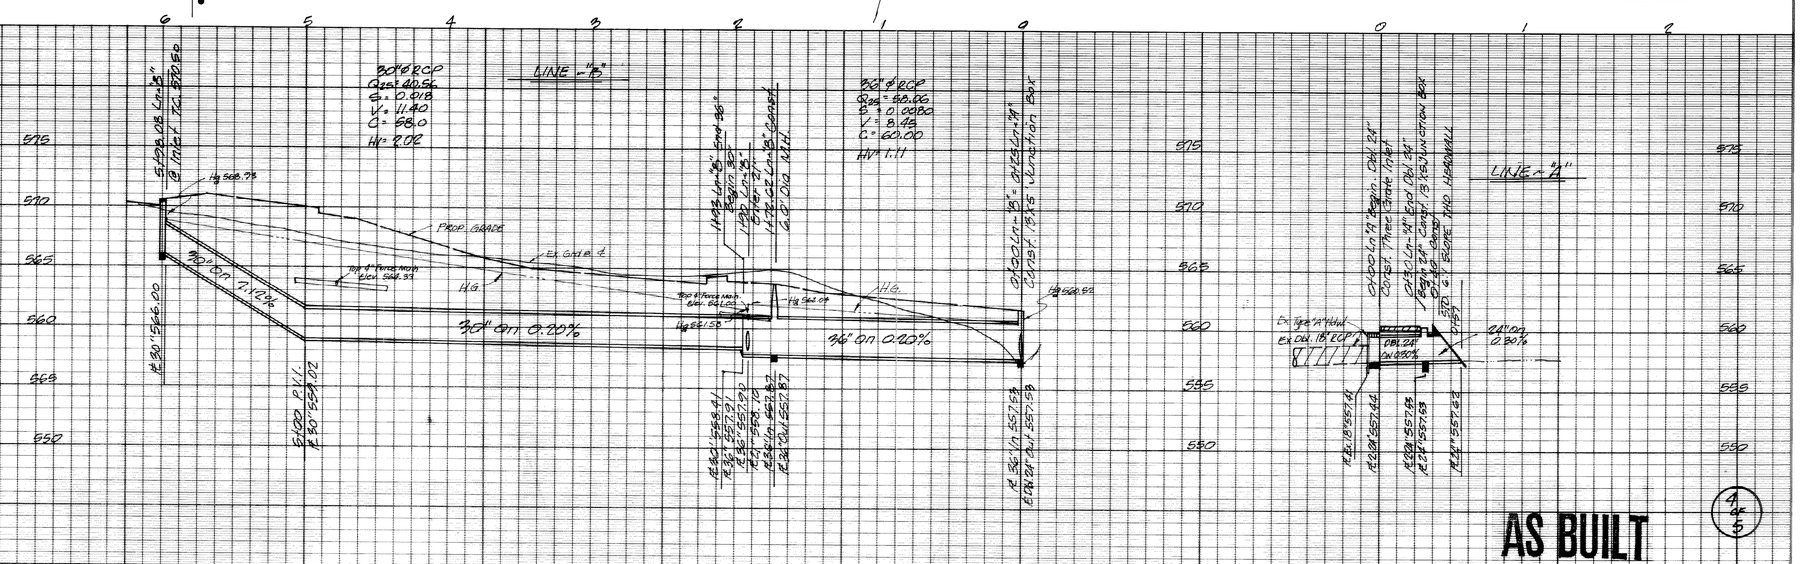

AS BUILT

4 of 5

Revision Description

1. From Station 0+00 Ln "B" to 0+35.68 Ln "B", Removed Horizontal Curve.
- Moved 18'x6' Junction Box 6' Upstream on Ln "A".
- Add Junction Box Detail

HAROLD L. EVANS CONSULTING ENGINEER 2331 GUS THOMASSON RD. SUITE 102 DALLAS, TEXAS 75228 PHONE (214) 328-8133		
SCALE	DATE	JOB NO.
H 1"=20' V 1"=6'	2-22-86	84288

STORM SEWER PLAN
ROCKWALL CENTRAL SHOPPING CENTER
CITY OF ROCKWALL
ROCKWALL COUNTY, TEXAS

REDRAWN 2-22-86 / Revised 3-7-86 #, 3-13-86

N83773