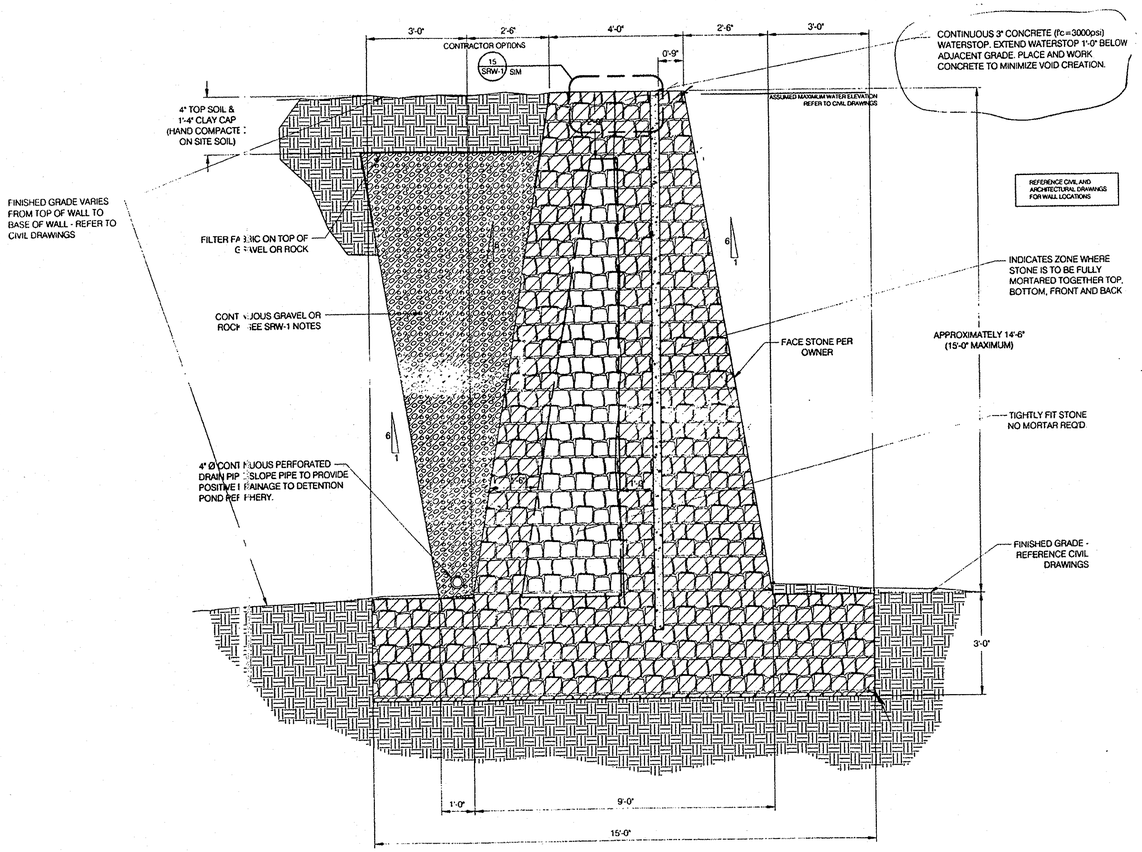

1 SRW-3 SCALE: 3/4" = 1'-0"

POND WALL SECTION

BEARING IN UNDISTURBED ONSITE SOIL OR COMPACTED AND TESTED FILL (3000 PSF MINIMUM BEARING STRENGTH REQUIRED)

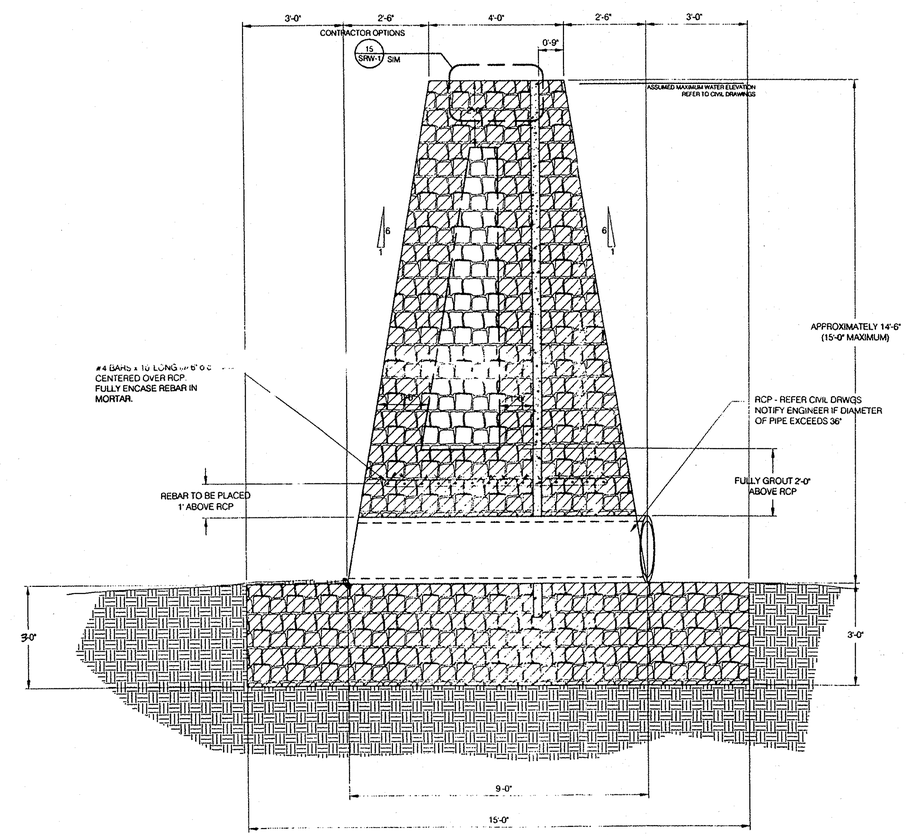

2 SRW-3 SCALE: 3/4" = 1'-0"

POND WALL SECTION w/ RCP

REFERENCE DETAIL 1/SRW-3 FOR ADDITIONAL INFORMATION

RECORD DRAWING

THIS RECORD DRAWING HEREIN REFLECTS TO THE BEST OF THE DESIGN ENGINEER'S KNOWLEDGE, THE APPROXIMATE LOCATION OF THE CONSTRUCTED WORK, USING INFORMATION AS PROVIDED BY THE CONTRACTORS AND SURVEYED GRADES.

FX
ENGINEERING SERVICES, INC.
P.O. Box 213
Bedford, Texas 76095
Ph. 817.715.0716

Contractor

ENGINEERED RETAINING WALL SYSTEMS, INC.
EULESS, TEXAS

ROCKWALL COMMONS

ROCKWALL, TEXAS

THE USE OF THESE PLANS AND SPECIFICATIONS SHALL BE RESTRICTED TO THE ORIGINAL SITE FOR WHICH THEY WERE PREPARED. ANY REPRODUCTION OR DISTRIBUTION IN EXCESS NOT LIMITED TO SUCH USE AND OTHER REPRODUCTION, REUSE OR DISCLOSURE BY ANY METHOD OR WHOLE OR IN PART IS PROHIBITED. THESE DRAWINGS AND SPECIFICATIONS CONTAIN PROPRIETARY INFORMATION AND TITLE REMAINS IN FX ENGINEERING SERVICES, INC.

BIRK CARVAJAL 88456 REGISTERED PROFESSIONAL ENGINEER

8-27-04

Revisions

#	ISSUE	DATE

Sheet Information

Date	8/27/04
FX Job #	0122
Scale	AS NOTED
Drawn	RKR
Approved	FDC

Sheet Title

TYPICAL WALL SECTIONS

Sheet #

SRW-3

ISSUE for CONSTRUCTION