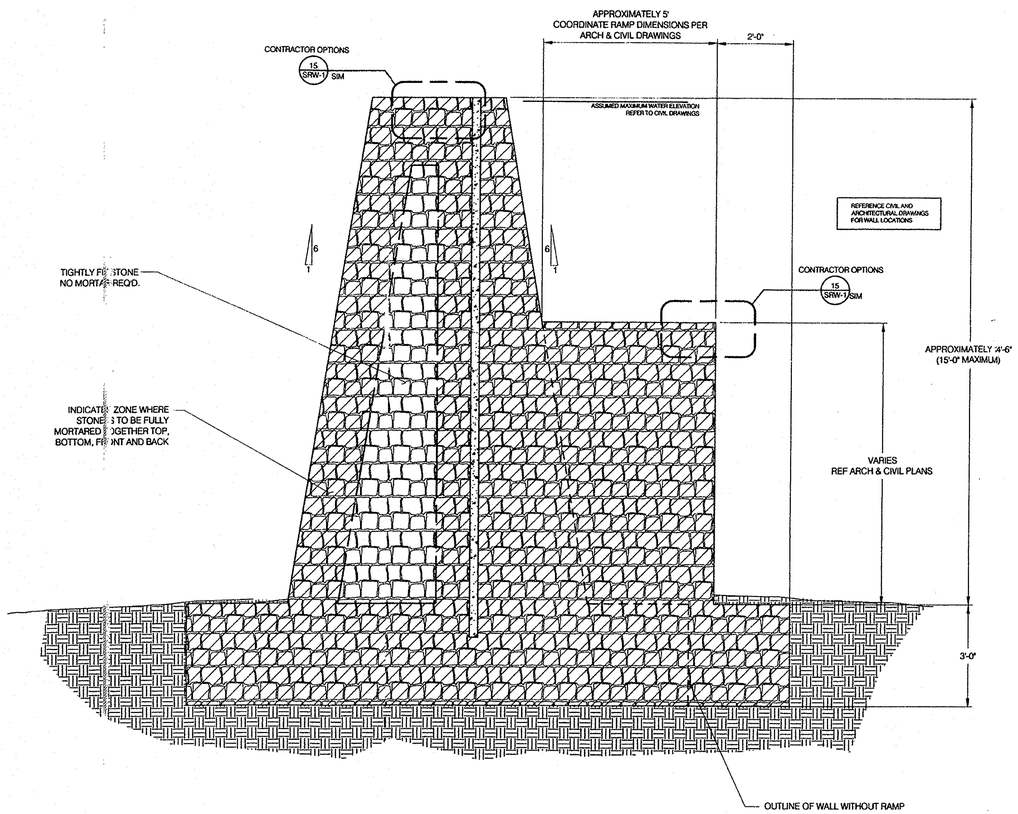

1
SRW-5

SCALE: 1/2" = 1'-0"

POND WALL SECTION @ RAMP

BEARING IN UNDISTURBED ONSITE SOIL OR COMPACTED AND TESTED FILL
(3000 PSF MINIMUM BEARING STRENGTH REQUIRED)
REFERENCE DETAIL 1/SRW-3 FOR ADDITIONAL INFORMATION

RECORD DRAWING
THIS RECORD DRAWING HEREIN REFLECTS TO THE BEST OF THE DESIGN ENGINEER'S KNOWLEDGE, THE APPROXIMATE LOCATION OF THE CONSTRUCTED WORK, USING INFORMATION AS PROVIDED BY THE CONTRACTORS AND SURVEYED GRADES.

FX
ENGINEERING SERVICES, INC.
P.O. Box 213
Bedford, Texas 76095
Ph. 817/715.0718

Contractor

ENGINEERED RETAINING WALL SYSTEMS, INC.
EULESS, TEXAS

ROCKWALL COMMONS
ROCKWALL, TEXAS

THE USE OF THESE PLANS AND SPECIFICATIONS SHALL BE RESTRICTED TO THE ORIGINAL SITE FOR WHICH THEY WERE PREPARED. ANY REPRODUCTION OR DISTRIBUTION IS EXPRESSLY LIMITED TO SUCH USE. ANY OTHER REPRODUCTION, REUSE, OR DISCLOSURE BY ANY METHOD, IN WHOLE, OR IN PART, IS PROHIBITED. THESE DRAWINGS AND SPECIFICATIONS CONTAIN PROPRIETARY INFORMATION AND TITLE REMAINS IN FX ENGINEERING SERVICES, INC.

DIRK CARVAJAL
88456
REGISTERED
PROFESSIONAL ENGINEER
8-27-04

Revisions

#	ISSUE	DATE

Sheet Information

Date	8/27/04
FX Job #	0122
Scale	AS NOTED
Drawn	RKR
Approved	FDC

Sheet Title

TYPICAL WALL SECTIONS

Sheet #

SRW-5

ISSUE for CONSTRUCTION