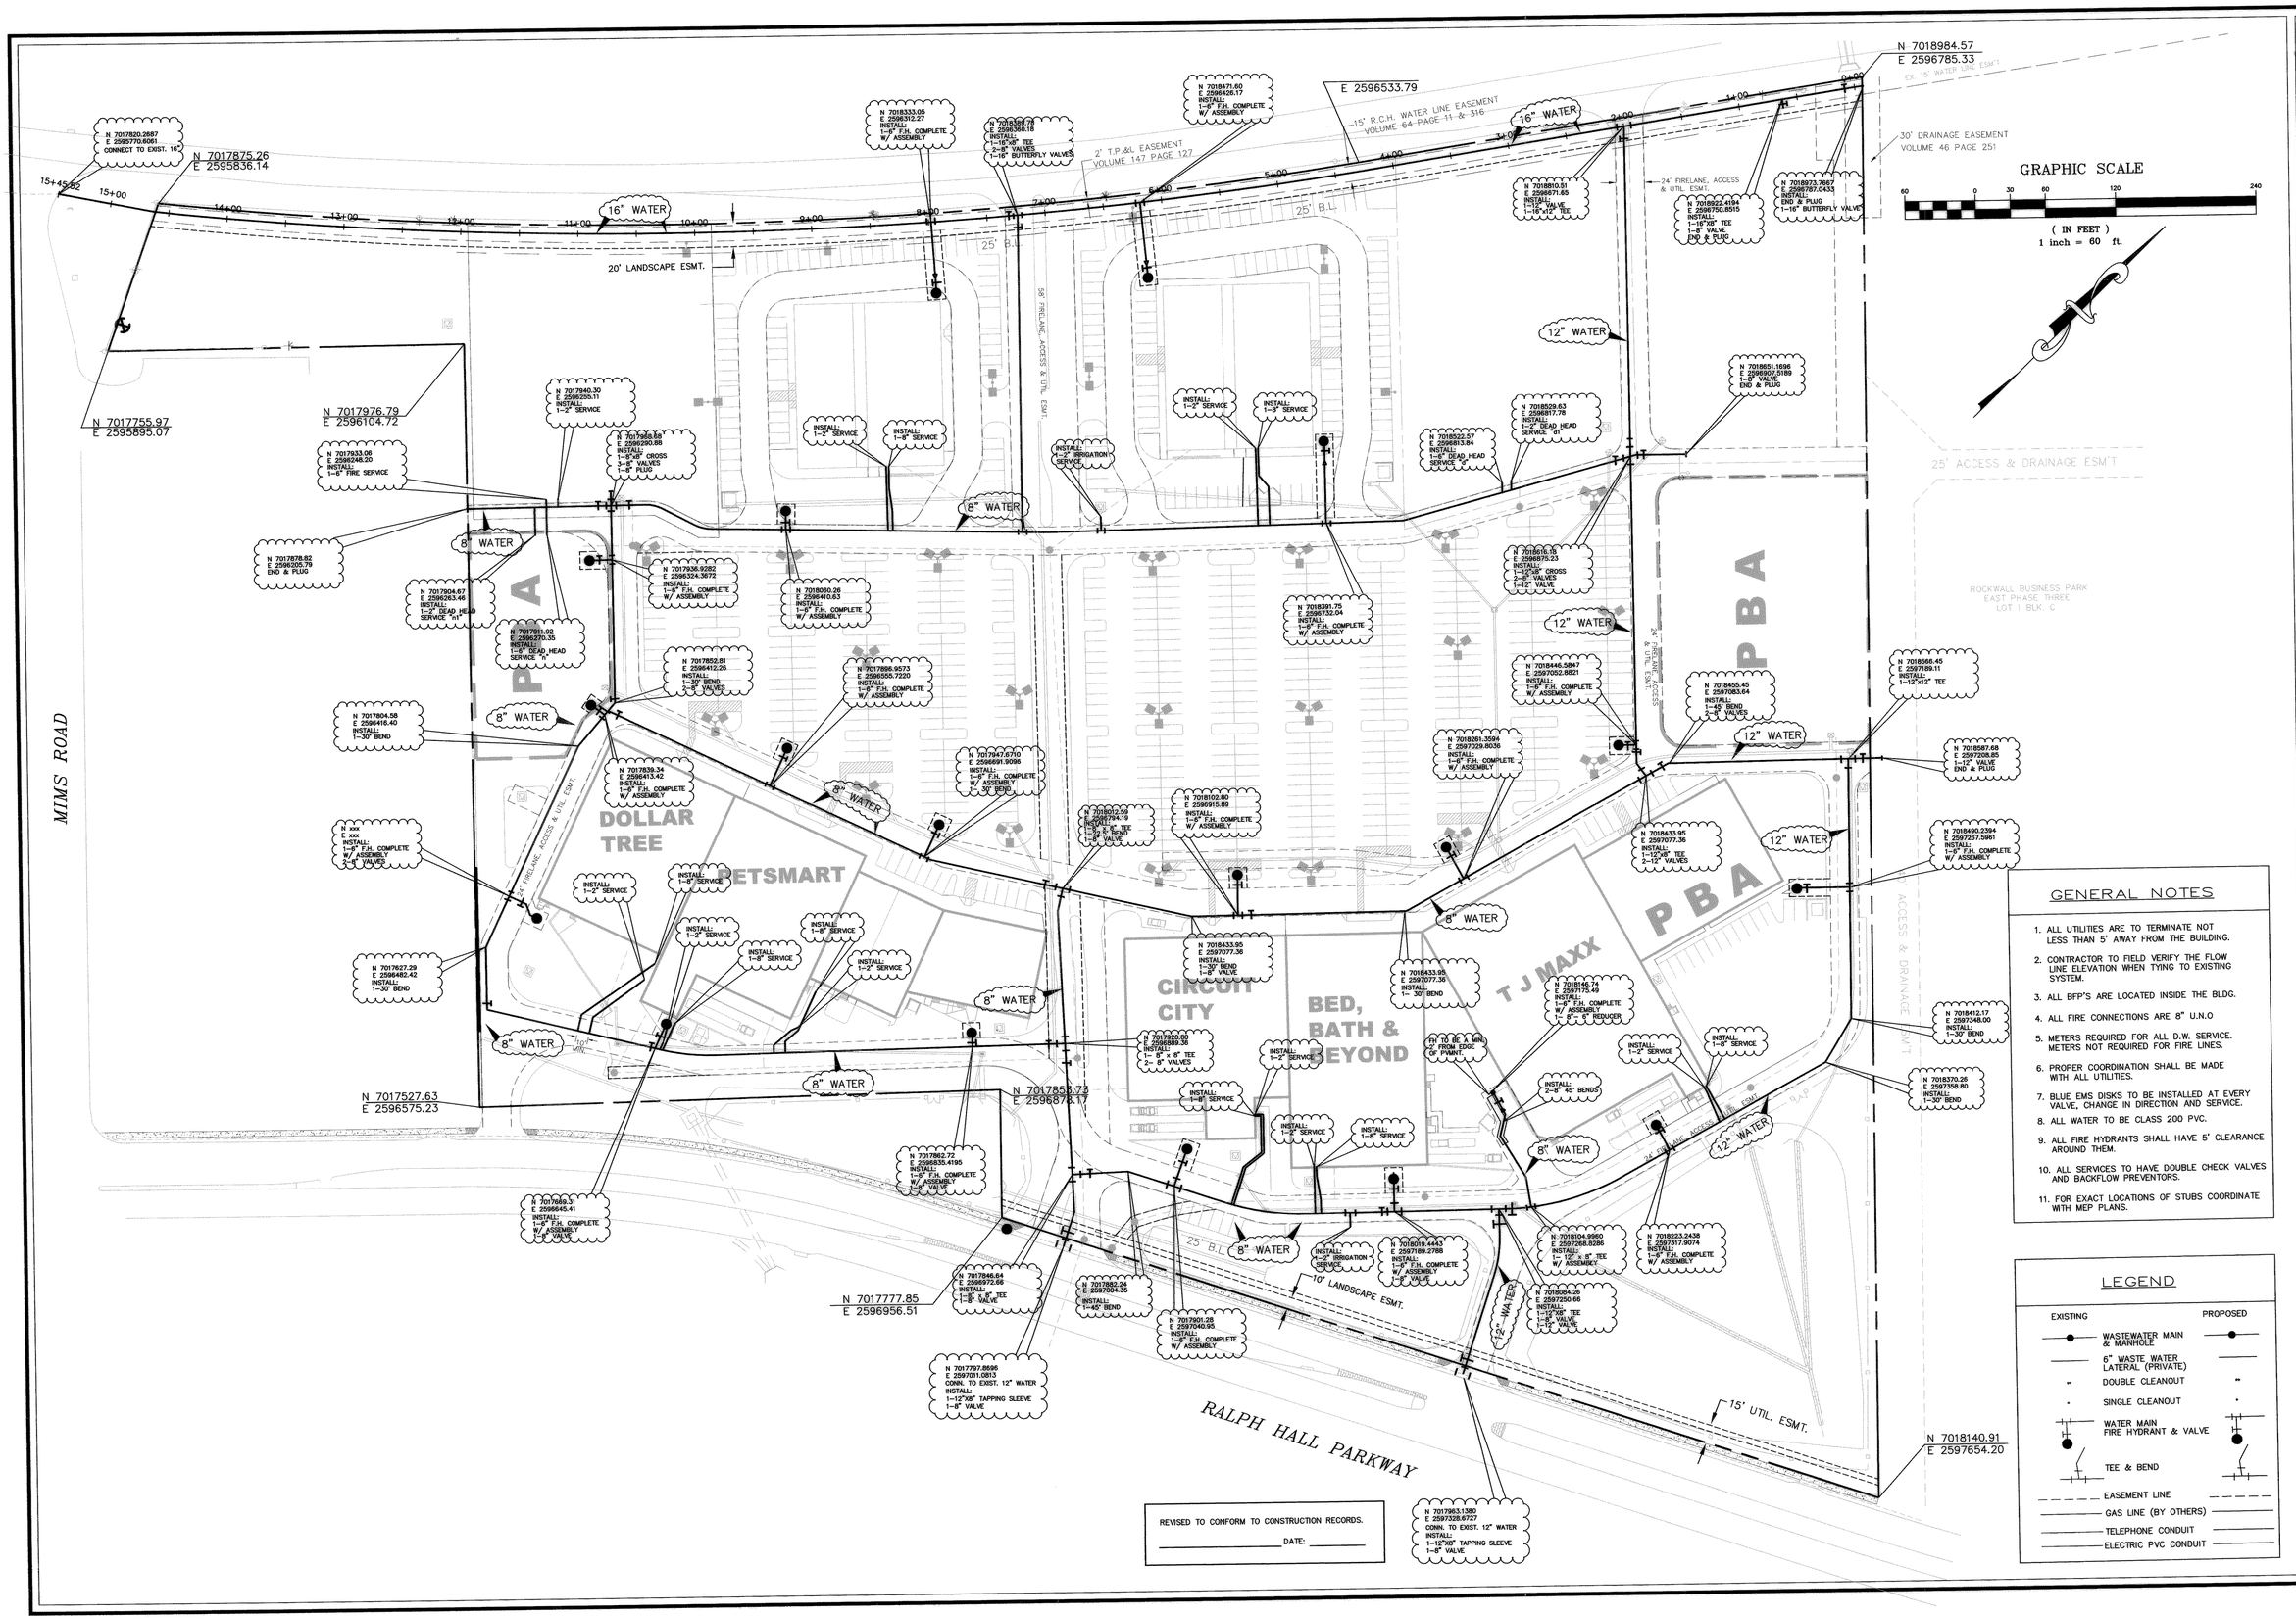

REVISED TO CONFORM TO CONSTRUCTION RECORDS.

DATE: _____

GENERAL NOTES

1. ALL UTILITIES ARE TO TERMINATE NOT LESS THAN 5' AWAY FROM THE BUILDING.
2. CONTRACTOR TO FIELD VERIFY THE FLOW LINE ELEVATION WHEN TYING TO EXISTING SYSTEM.
3. ALL BFP'S ARE LOCATED INSIDE THE BLDG.
4. ALL FIRE CONNECTIONS ARE 8" U.N.O
5. METERS REQUIRED FOR ALL D.W. SERVICE. METERS NOT REQUIRED FOR FIRE LINES.
6. PROPER COORDINATION SHALL BE MADE WITH ALL UTILITIES.
7. BLUE EMS DISKS TO BE INSTALLED AT EVERY VALVE, CHANGE IN DIRECTION AND SERVICE.
8. ALL WATER TO BE CLASS 200 PVC.
9. ALL FIRE HYDRANTS SHALL HAVE 5' CLEARANCE AROUND THEM.
10. ALL SERVICES TO HAVE DOUBLE CHECK VALVES AND BACKFLOW PREVENTORS.
11. FOR EXACT LOCATIONS OF STUBS COORDINATE WITH MEP PLANS.

LEGEND

EXISTING		PROPOSED
	WASTEWATER MAIN & MANHOLE	
	6" WASTE WATER LATERAL (PRIVATE)	
	DOUBLE CLEANOUT	
	SINGLE CLEANOUT	
	WATER MAIN FIRE HYDRANT & VALVE	
	TEE & BEND	
	EASEMENT LINE	
	GAS LINE (BY OTHERS)	
	TELEPHONE CONDUIT	
	ELECTRIC PVC CONDUIT	

THE SEAL APPEARING ON THIS DOCUMENT WAS AUTHORIZED BY W.L. DOUPHRATE II TEXAS P.E. NO. 60102 ON 9/29/04

DOUPHRATE & ASSOCIATES, INC.
ENGINEERING • PROJECT MANAGEMENT • SURVEYING
2235 RIDGE RD. # 200 ROCKWALL, TEXAS 75087
PHONE: (972)771-9004 FAX: (972)771-9005

WATER MAIN PLAN
ROCKWALL CROSSING
CITY OF ROCKWALL
ROCKWALL COUNTY, TEXAS

REVISION	
CHECKED	W.L.D.
DRAWN	K.E.B.
DATE	10/15/04
PROJECT	0242