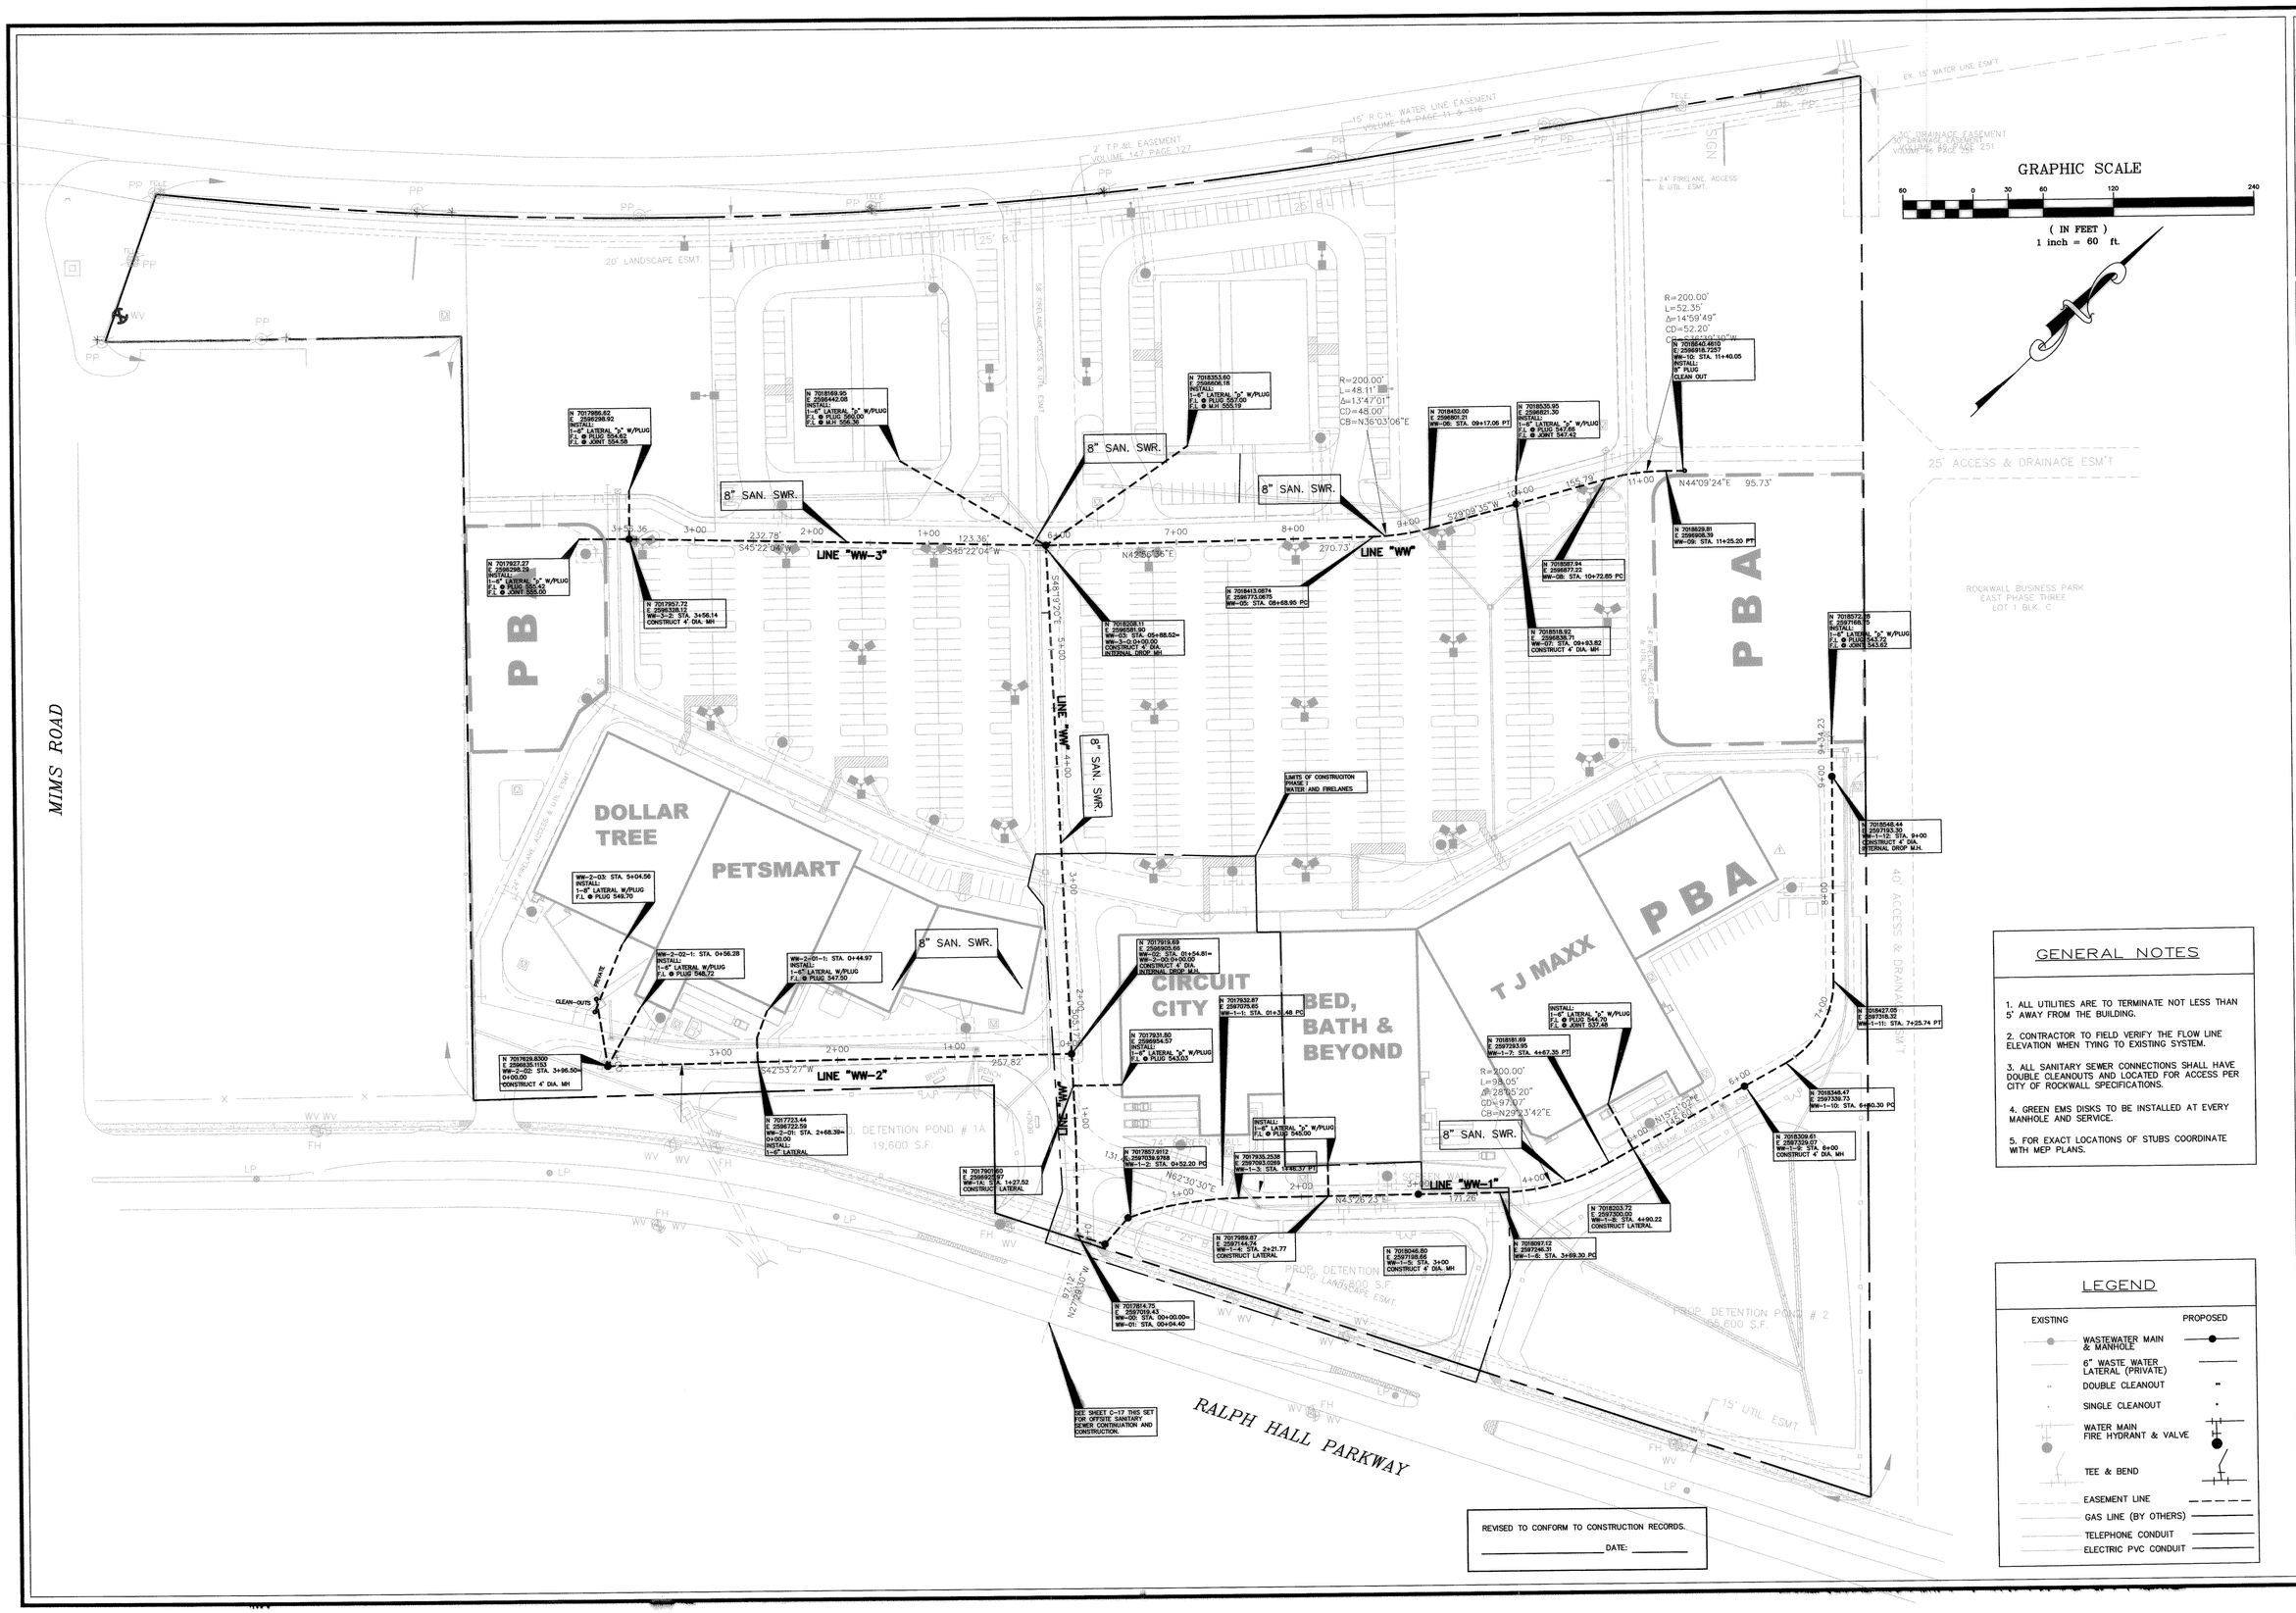

GENERAL NOTES

1. ALL UTILITIES ARE TO TERMINATE NOT LESS THAN 5' AWAY FROM THE BUILDING.
2. CONTRACTOR TO FIELD VERIFY THE FLOW LINE ELEVATION WHEN TYING TO EXISTING SYSTEM.
3. ALL SANITARY SEWER CONNECTIONS SHALL HAVE DOUBLE CLEANOUTS AND LOCATED FOR ACCESS PER CITY OF ROCKWALL SPECIFICATIONS.
4. GREEN EMS DISKS TO BE INSTALLED AT EVERY MANHOLE AND SERVICE.
5. FOR EXACT LOCATIONS OF STUBS COORDINATE WITH MEP PLANS.

LEGEND

EXISTING	PROPOSED
WASTEWATER MAIN & MANHOLE	
6" WASTE WATER LATERAL (PRIVATE)	
DOUBLE CLEANOUT	
SINGLE CLEANOUT	
WATER MAIN FIRE HYDRANT & VALVE	
TEE & BEND	
EASEMENT LINE	
GAS LINE (BY OTHERS)	
TELEPHONE CONDUIT	
ELECTRIC PVC CONDUIT	

REVISED TO CONFORM TO CONSTRUCTION RECORDS.

DATE: _____

THE SEAL APPEARING ON THIS DOCUMENT WAS AUTHORIZED BY W.L. DOUPHRATE II TEXAS P.E. NO. 60102 ON 7/9/06

DOUPHRATE & ASSOCIATES, INC.
ENGINEERING - PROJECT MANAGEMENT - SURVEYING
2235 RIDGE RD., # 200 ROCKWALL, TEXAS 75087
PHONE: (972)771-9004 FAX: (972)771-9005

SANITARY SEWER PLAN
ROCKWALL CROSSING
CITY OF ROCKWALL
ROCKWALL COUNTY, TEXAS

REVISION	
CHECKED	W.L.D.
DRAWN	K.E.B.
DATE	10/15/04
PROJECT	0242