BENCHMARK #1

PK NAIL FOUND IN CENTER OF S. JOHN KING BLVD. 20' ± NORTH OF MEDIAN OPENING NEAR NORTHWEST CORNER OF PROPERTY.

ELEV.=564.12
N. 7021747.513
E. 2602779.713

BENCHMARK #2

"X" FOUND ON NORTH END OF TOP OF HEADWALL ON WEST SIDE OF S. JOHN KING BLVD. AT BUFFALO CREEK.

ELEV.=550.82
N. 7020725.306
E. 2602982.310

SCALE: 1" = 40'

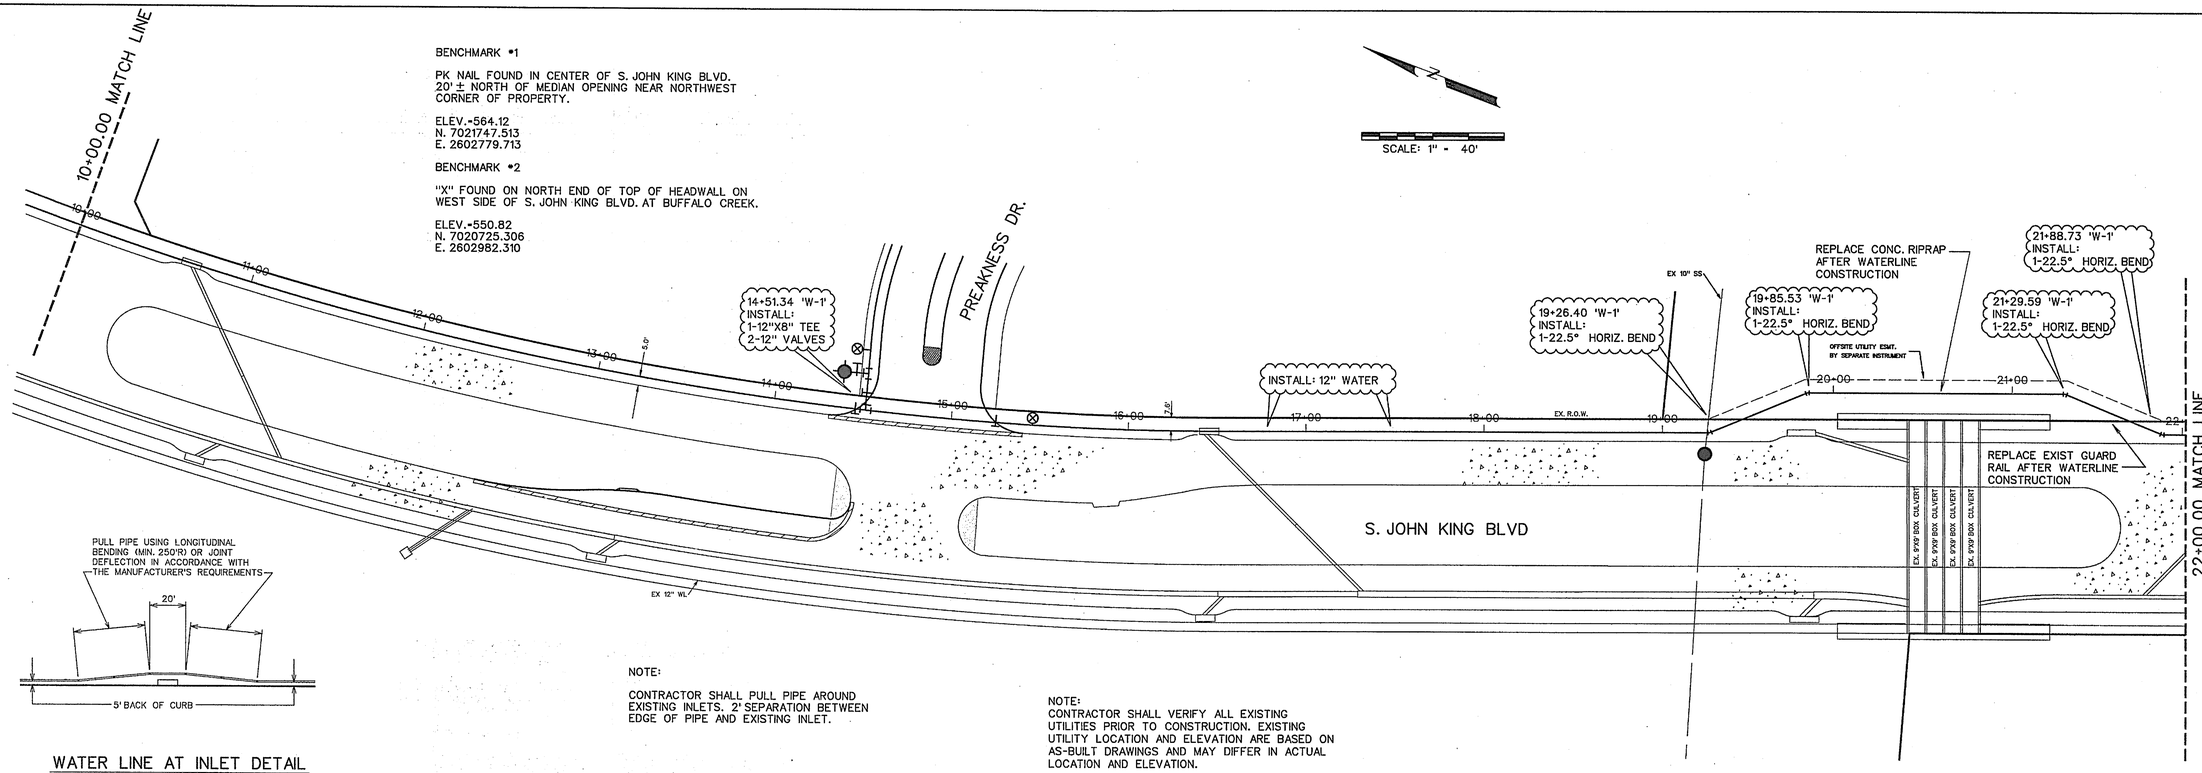

WATER LINE AT INLET DETAIL
N.T.S.

NOTE:

CONTRACTOR SHALL PULL PIPE AROUND EXISTING INLETS. 2' SEPARATION BETWEEN EDGE OF PIPE AND EXISTING INLET.

NOTE:
CONTRACTOR SHALL VERIFY ALL EXISTING UTILITIES PRIOR TO CONSTRUCTION. EXISTING UTILITY LOCATION AND ELEVATION ARE BASED ON AS-BUILT DRAWINGS AND MAY DIFFER IN ACTUAL LOCATION AND ELEVATION.

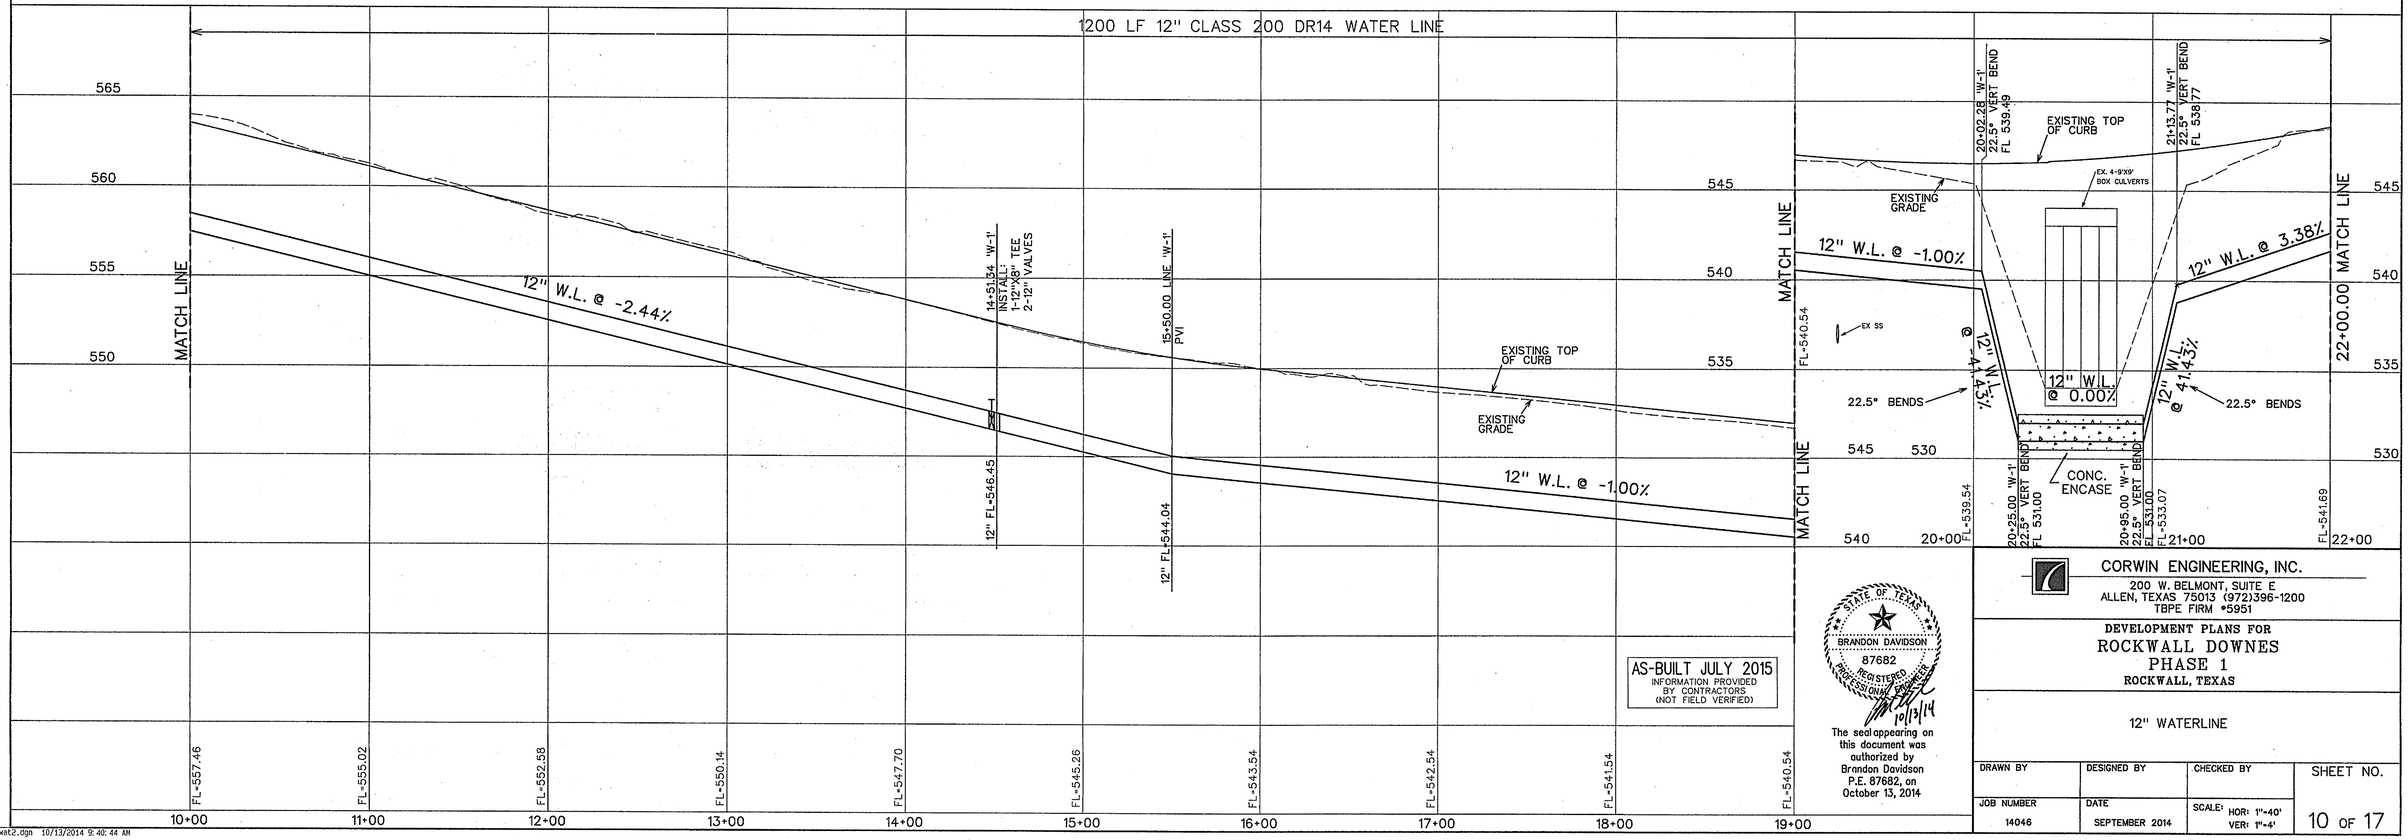

AS-BUILT JULY 2015
INFORMATION PROVIDED BY CONTRACTORS (NOT FIELD VERIFIED)

STATE OF TEXAS
BRANDON DAVIDSON
87682
REGISTERED PROFESSIONAL ENGINEER
10/13/14

The seal appearing on this document was authorized by Brandon Davidson P.E. 87682, on October 13, 2014

CORWIN ENGINEERING, INC.
200 W. BELMONT, SUITE E
ALLEN, TEXAS 75013 (972)396-1200
TBPE FIRM #5951

DEVELOPMENT PLANS FOR
ROCKWALL DOWNES
PHASE 1
ROCKWALL, TEXAS

12" WATERLINE

DRAWN BY	DESIGNED BY	CHECKED BY	SHEET NO.
JOB NUMBER 14046	DATE SEPTEMBER 2014	SCALE: HOR: 1"=40' VER: 1"=4'	10 OF 17

...\dgn\14046_wat2.dgn 10/13/2014 9:40:44 AM