


LOCATION MAP  
NO SCALE

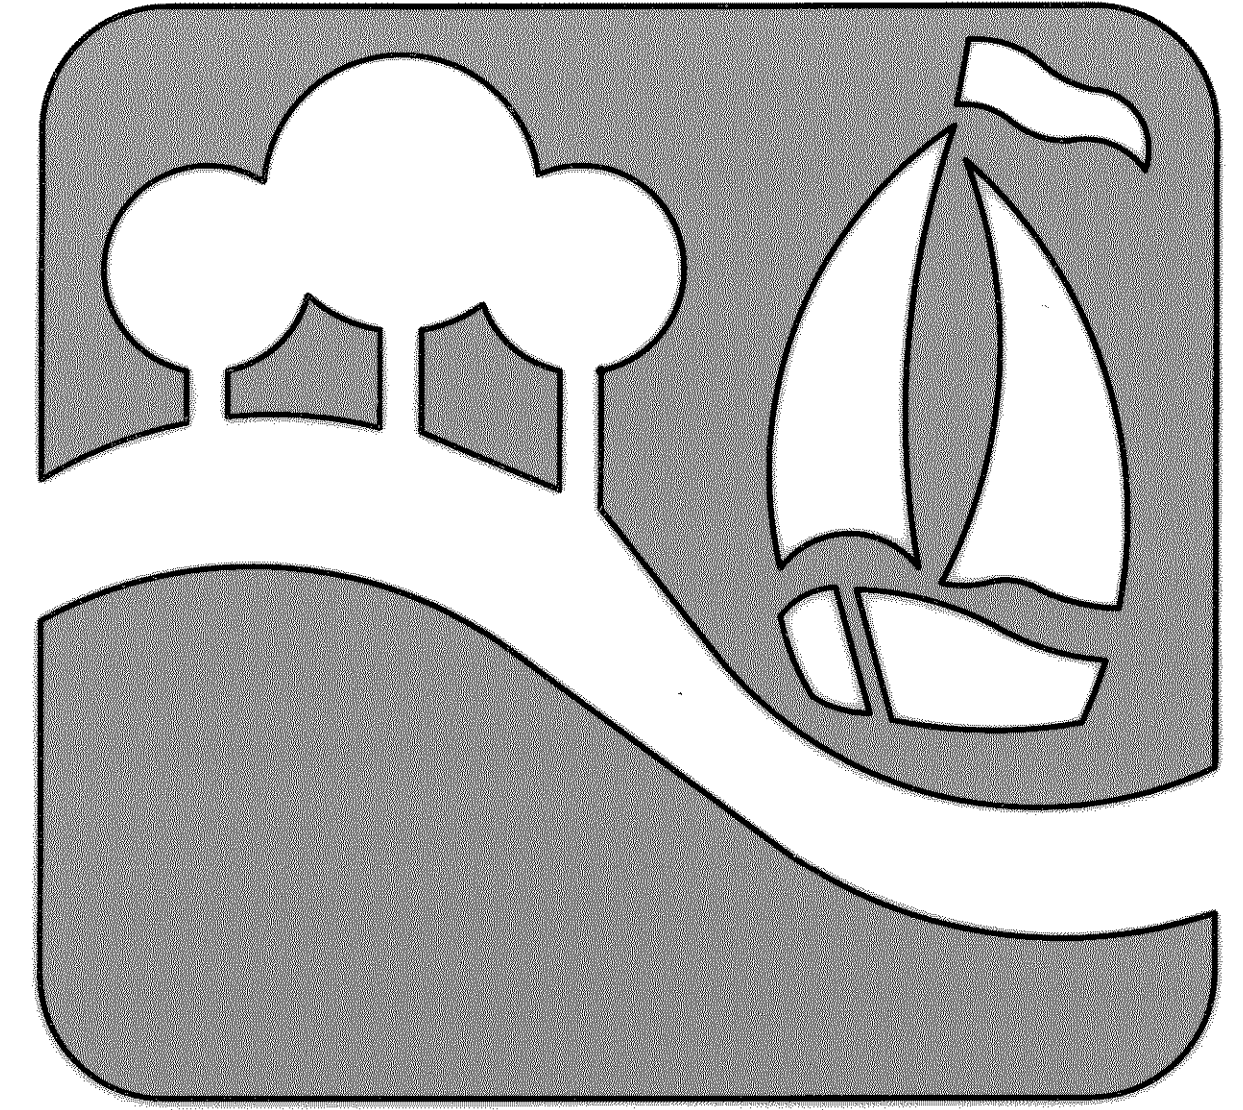

"THE NEW HORIZON"

**SITE CONSTRUCTION PLANS**

**FOR**

**ROCKWALL HONDA**

**NEWMAN CENTER NO. 1 ADDITION**

**BLOCK A, LOT 1R**

**IN THE**

**CITY OF ROCKWALL, TEXAS**


**SHEET INDEX**

Sheet No.	Description
1	Cover Sheet
2	Replat
C1	Site Plan
C2	Dimension Control
C3	Grading Plan
C4	Drainage Area Map
C5	Water & Sewer Plan
C6	Erosion Control
C7	Typical Details & Notes

**BENTLEY ENGINEERING, INC**

CIVIL ENGINEERING • PLANNING • CONSTRUCTION MANAGEMENT

702 GATEWOOD DRIVE  
GARLAND, TEXAS 75043  
PH: (972) 240-4821  
FAX: (972) 240-0922

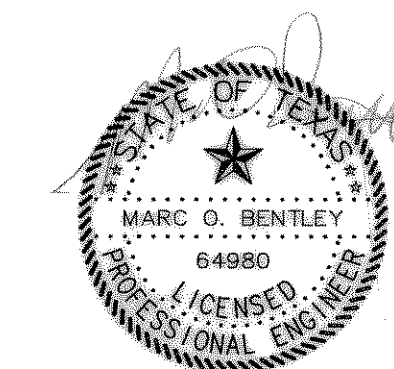

THE SEAL APPEARING ON THIS DOCUMENT WAS AUTHORIZED BY MARC O. BENTLEY, P.E. NO. 64980 ON 8/24/01

AUGUST 2001

RECORD DRAWING

IMPROVEMENTS INDICATED ON THIS PLAN WHERE MADE IN ACCORDANCE WITH THE PROJECT PLANS & SPECIFICATIONS. THE DESIGN ENGINEER IS NOT AWARE OF ANY CHANGES TO THESE PLANS OTHER THAN THOSE PROVIDED ON A CONTRACTORS SET OF MARKUPS.

DATE: OCTOBER 2, 2002