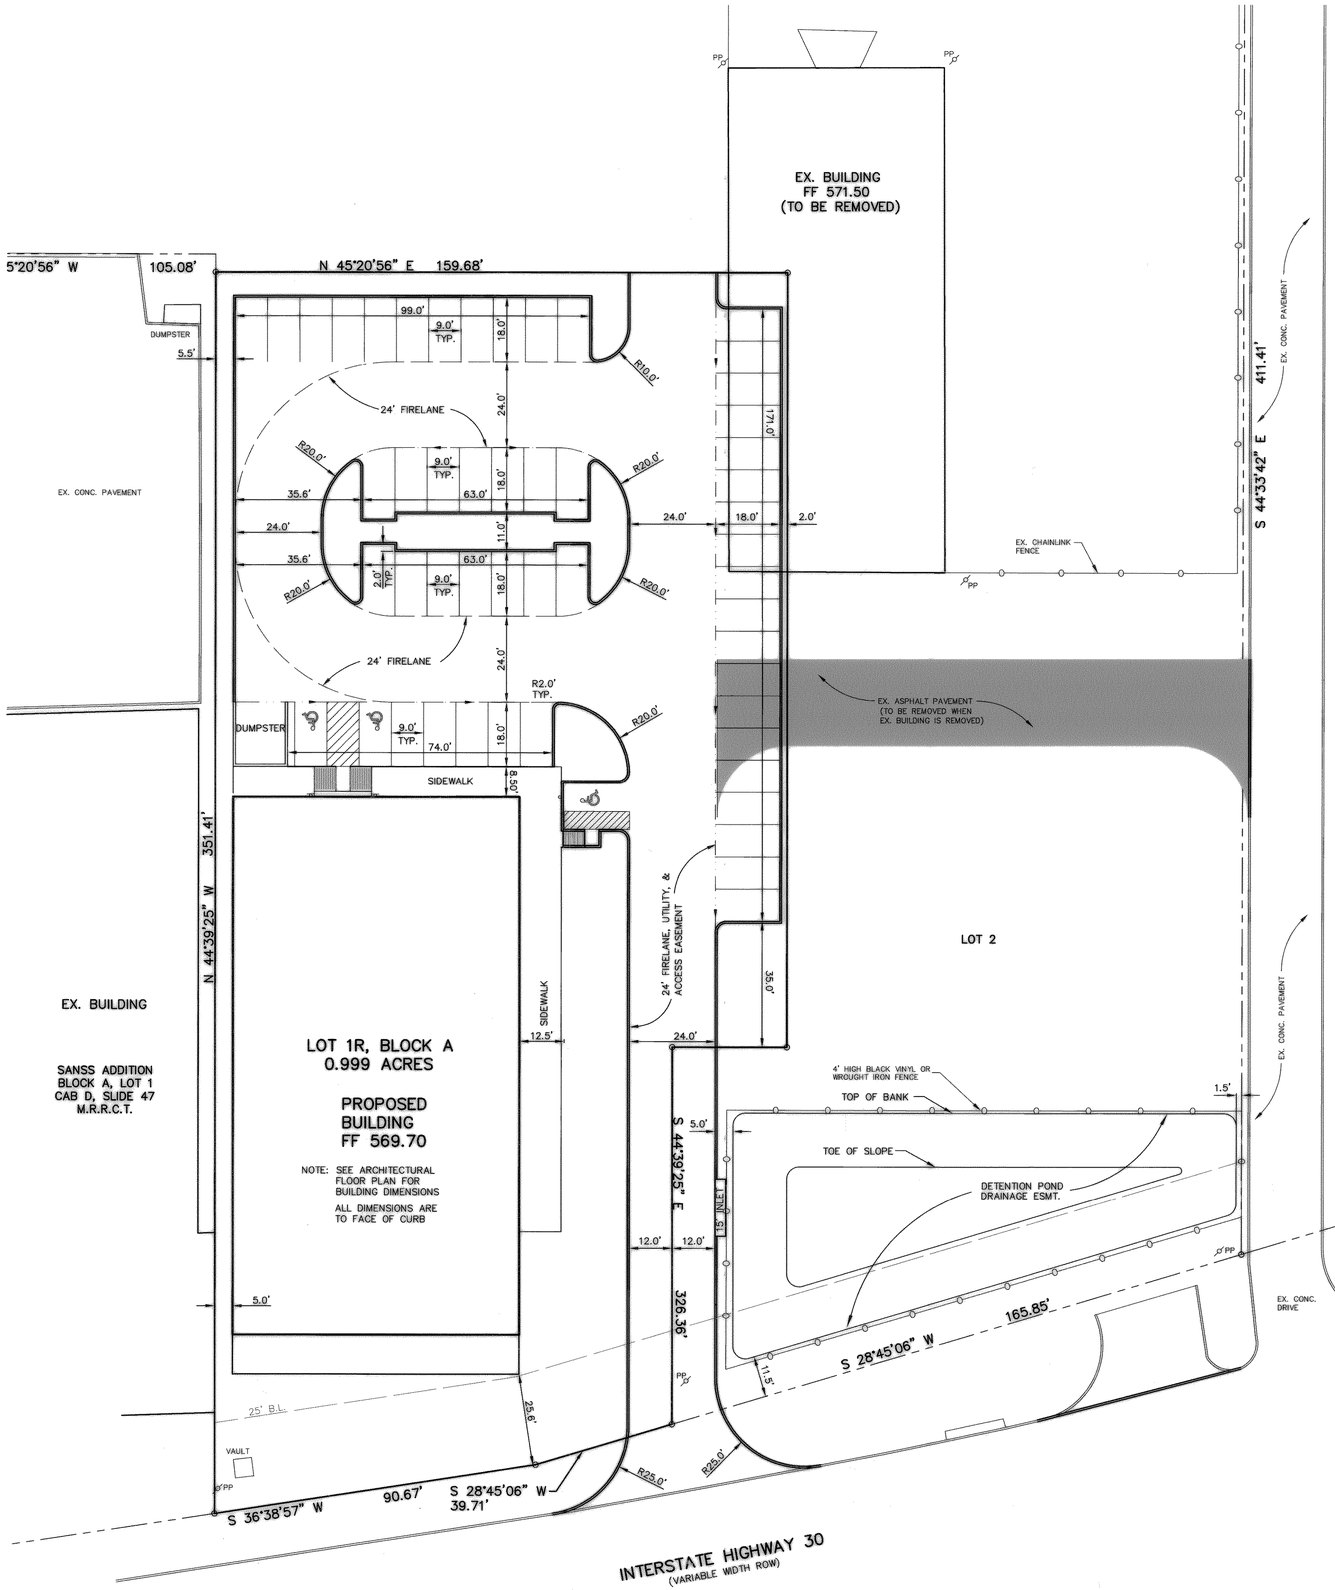

RECORD DRAWING

IMPROVEMENTS INDICATED ON THIS PLAN WHERE MADE IN ACCORDANCE WITH THE PROJECT PLANS & SPECIFICATIONS. THE DESIGN ENGINEER IS NOT AWARE OF ANY CHANGES TO THESE PLANS OTHER THAN THOSE PROVIDED ON A CONTRACTORS SET OF MARKUPS.

DATE: OCTOBER 2, 2002

BENTLEY ENGINEERING, INC
CIVIL ENGINEERING • PLANNING • CONSTRUCTION MANAGEMENT
702 GATEWOOD DRIVE
GARLAND, TEXAS 75043
PHONE: (972) 240-6511
FAX: (972) 240-6922

RECORD DRAWING

No.	Date	Revision	By

DIMENSION CONTROL

ROCKWALL HONDA
CITY OF ROCKWALL, TEXAS

MARC O. BENTLEY
64980
LICENSED
PROFESSIONAL ENGINEER

THE SEAL APPEARING ON THIS DOCUMENT WAS AUTHORIZED BY MARC O. BENTLEY, P.E. NO. 64980 ON 9/11/01

Scale:	1"=20'
File Name:	HONDASITE
Date:	JAN. 2001
Project No.:	20123
Designed:	B.E.I.
Drawn:	B.E.I.
Checked:	M.O.B.

SHEET
C2

G:\2000\20123\hondasite.dwg Tue Oct 01 13:52:11 2002