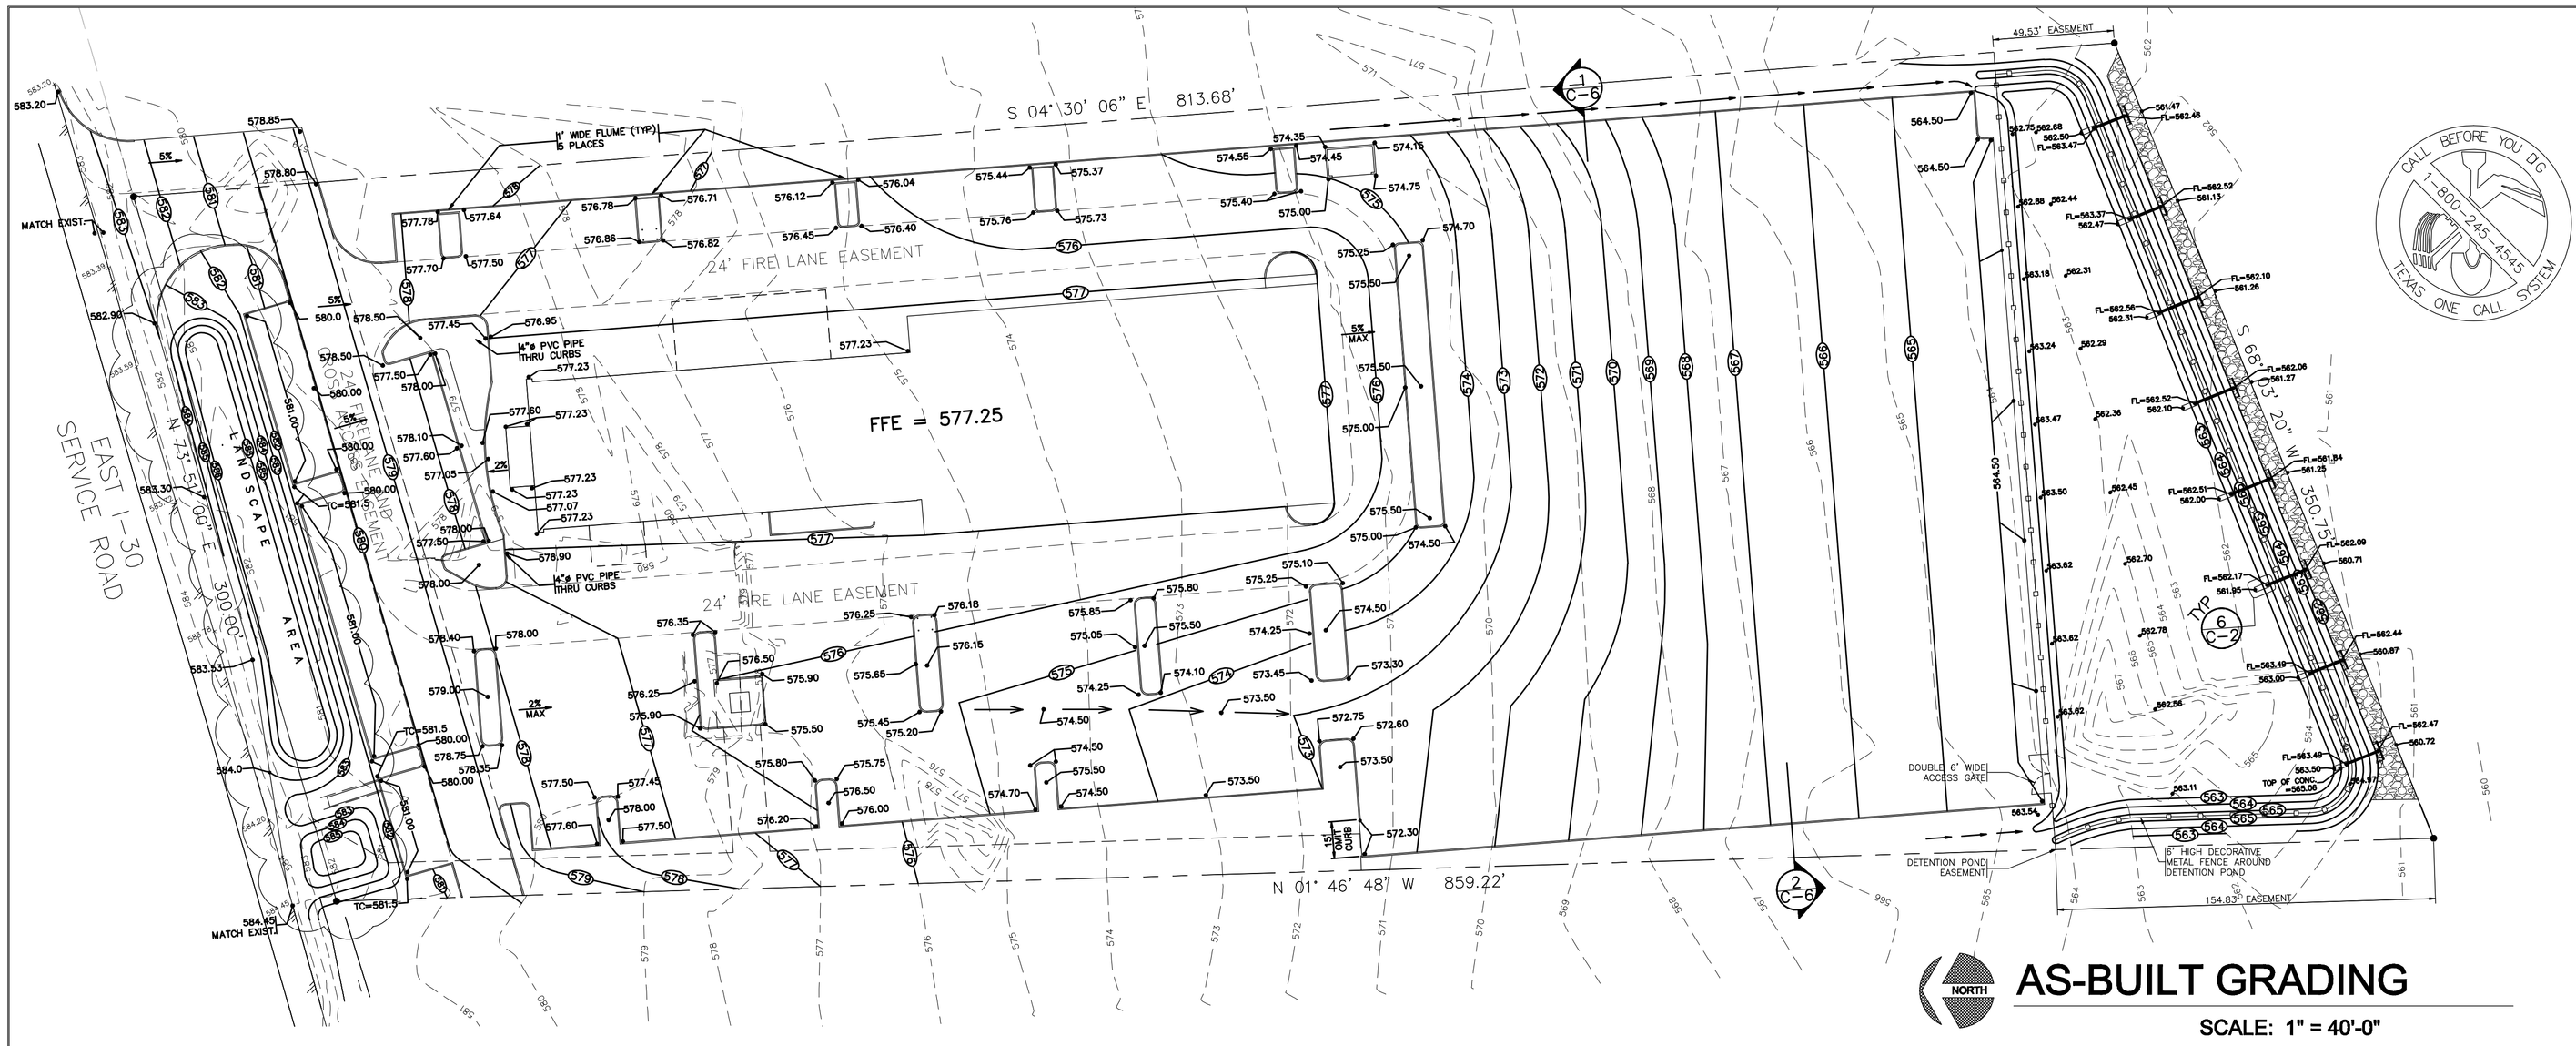

NORTH

AS-BUILT GRADING

SCALE: 1" = 40'-0"

CALL BEFORE YOU DIG 1-800-245-4545 TEXAS ONE CALL SYSTEM

NOTE:
1. ALL FILL TO BE COMPACTED TO MIN. OF 95% STANDARD PROCTOR DENSITY.
2. ALL FILL TO BE COMPACTED USING A SHEEP'S FOOT ROLLER.

LEGEND

-----572-----	EXISTING TOPOGRAPHY
572	AS-BUILT TOPOGRAPHY

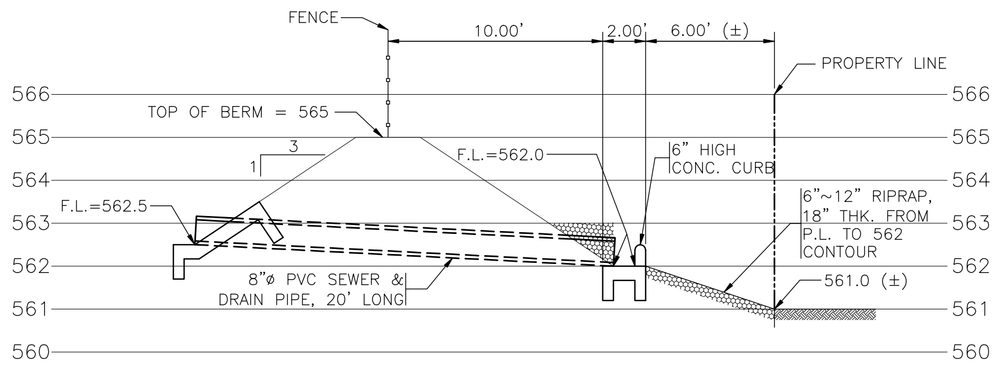

1 LINE "A" – PROFILE (TYP FOR 4 LOCATIONS)
SCALE: 1:5 HORIZ (2xSCALE VERT)

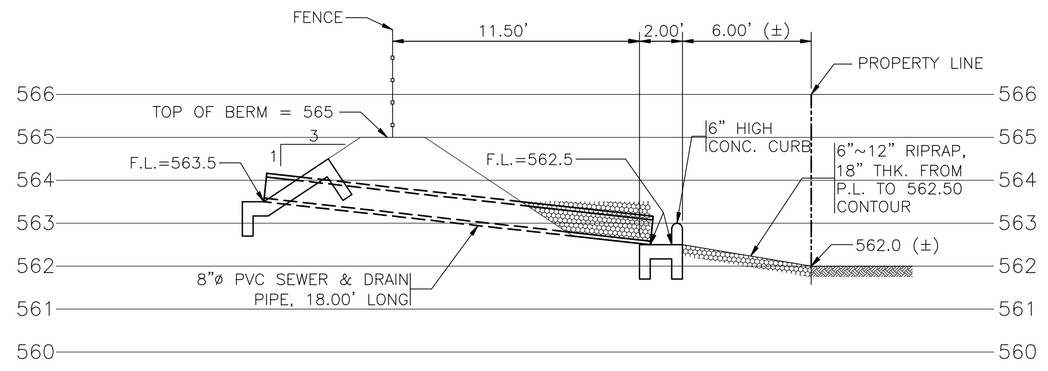

3 LINE "B" – PROFILE (TYP FOR 4 LOCATIONS)
SCALE: 1:5 HORIZ (2xSCALE VERT)

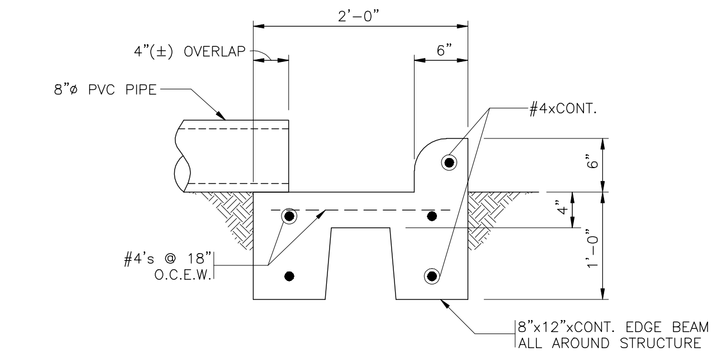

5 CONCRETE ENERGY DISSIPATION STRUCTURE
SCALE: NTS

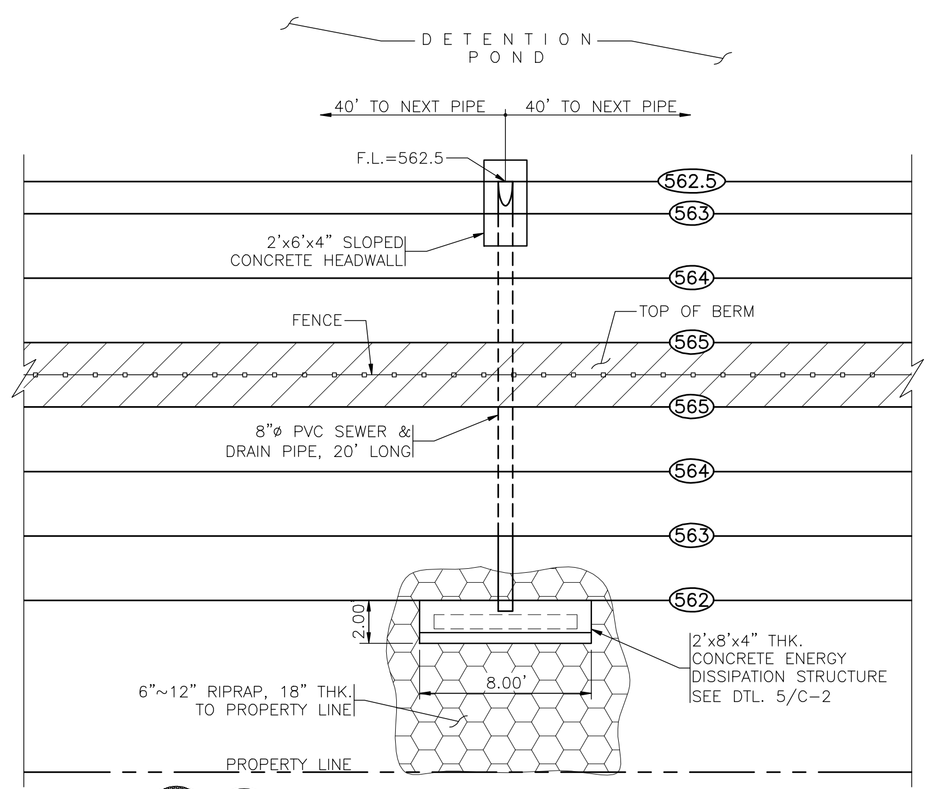

2 LINE "A" – PLAN (TYP FOR 4 LOCATIONS)
SCALE: 1:5

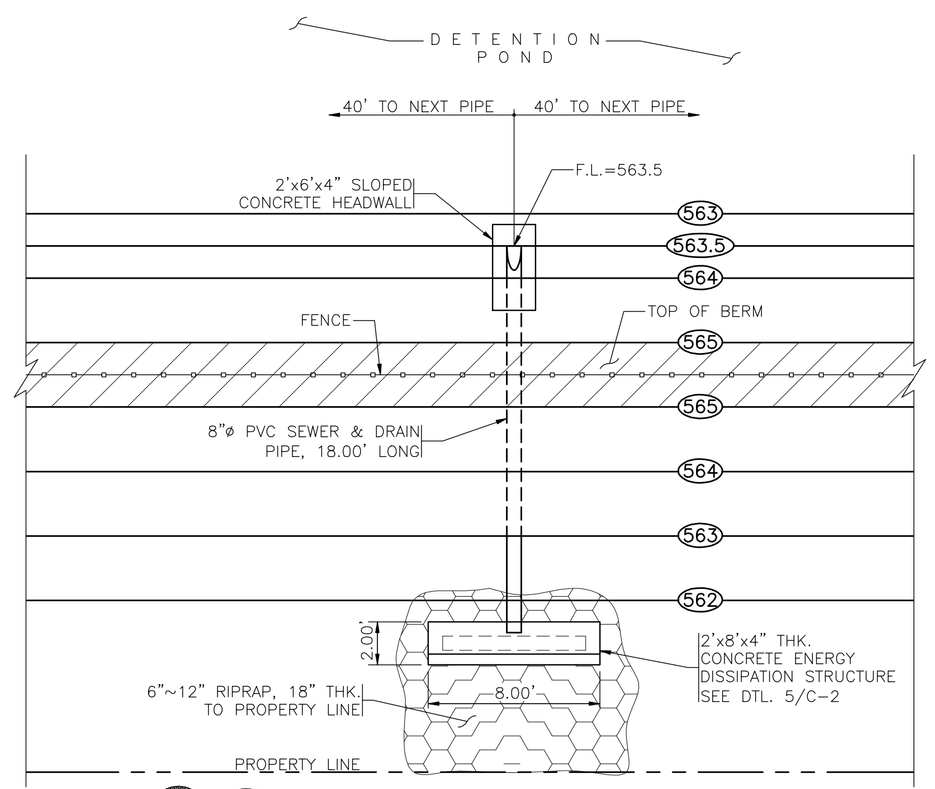

4 LINE "B" – PLAN (TYP FOR 4 LOCATIONS)
SCALE: 1:5

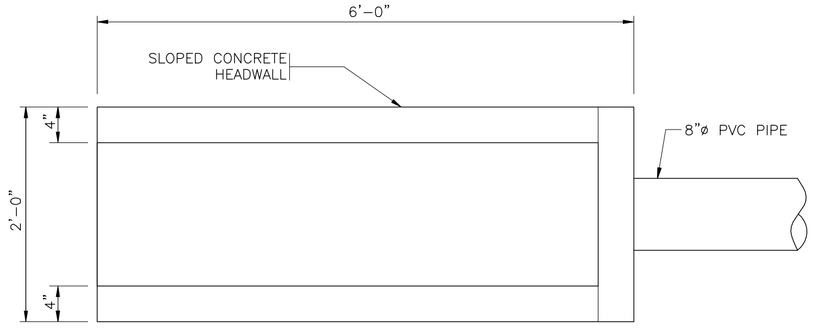

6 TYPICAL SLOPED HEADWALL @ ALL INLETS
SCALE: NTS

Preston Engineering & Construction
12770 Coit Rd., Suite # 902 Dallas, TX 75251
Phone 972-991-0498 Fax 972-991-0499

New Facility for New Car Dealership

Rockwall Kia

1790 East Interstate 30
Rockwall, Texas

AS-BUILT DRAWINGS

STATE OF TEXAS
BRIAN CAMPBELL
75554
REGISTERED
PROFESSIONAL ENGINEER
11/13/08

REVISIONS:

DRAWN BY:	IMH
CHECKED BY:	JBC
ISSUE DATE:	JUN 2008
JOB NUMBER:	50304

SHEET NO:

C-2

g W C engineering, LP
4201 Spring Valley Road Ste. 1120
Farmers Branch, Tx 75244
(tel)469-374-0810 (fax)469-374-0811
(email) production@gwcengineering.com