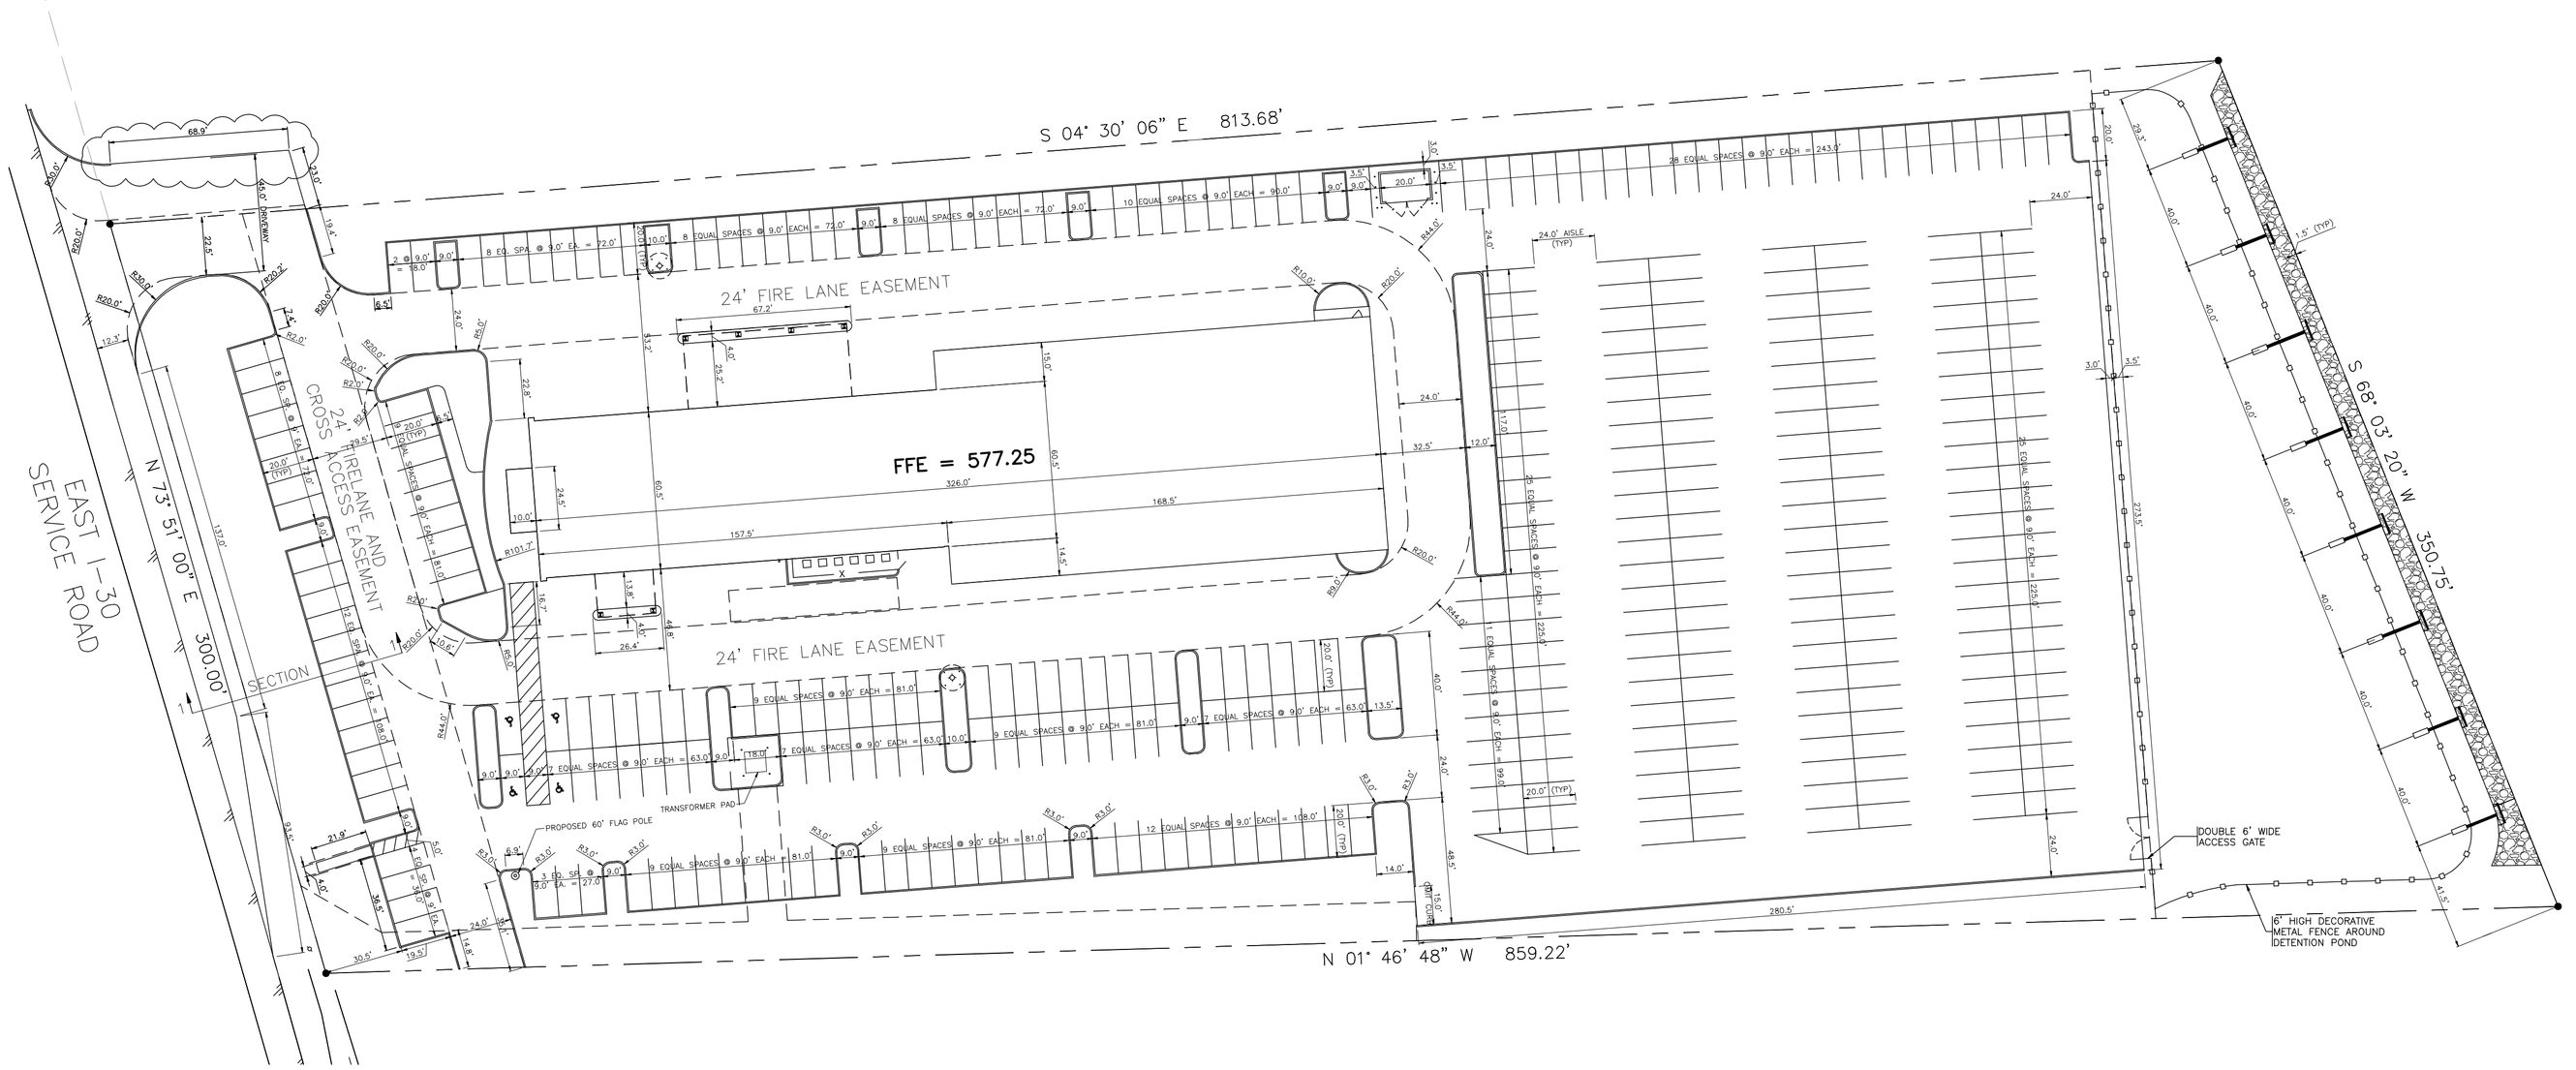

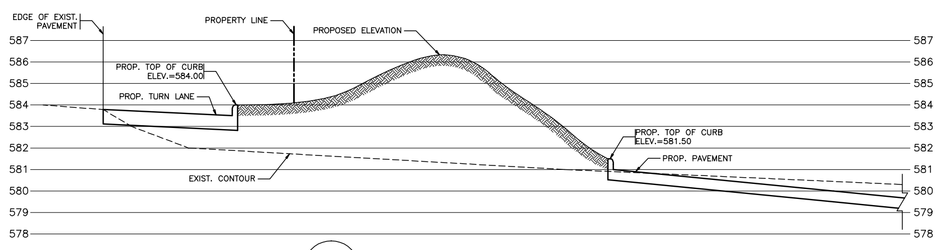

1 SECTION
SCALE: 1:10 HORIZ 1:5 VERT

DIMENSION CONTROL PLAN

SCALE: 1" = 40'-0"

NOTE

1. ALL PAVEMENT DIMENSIONS ARE TO FACE OF CURBS.
2. UTILITIES SHOWN ON SHEET C-5.

DRIVEWAY TO WEST: 300' (±) EDGE-TO-EDGE
DRIVEWAY TO EAST: 44' (±) EDGE-TO-EDGE

Preston Engineering & Construction
12770 Coit Rd., Suite # 902 Dallas, TX 75251
Phone 972-991-0498 Fax 972-991-0499

New Facility for New Car Dealership

Rockwall Kia

1790 East Interstate 30
Rockwall, Texas

AS-BUILT DRAWINGS

STATE OF TEXAS
J. BRIAN CAMPBELL
75554
REGISTERED PROFESSIONAL ENGINEER
11/13/08

REVISIONS:
7-11-08 OMIT CURB ON EAST SIDE OF DRIVE

DRAWN BY:	IMH
CHECKED BY:	JBC
ISSUE DATE:	JUN 2008
JOB NUMBER:	50304

CALL BEFORE YOU DIG 1-800-245-4545 TEXAS ONE CALL SYSTEM

g W C engineering, LP
4201 Spring Valley Road Ste. 1120
Farmers Branch, Tx 75244
(tel)469-374-0810 (fax)469-374-0811
(email) production@gwcengineering.com

SHEET NO:
C-4