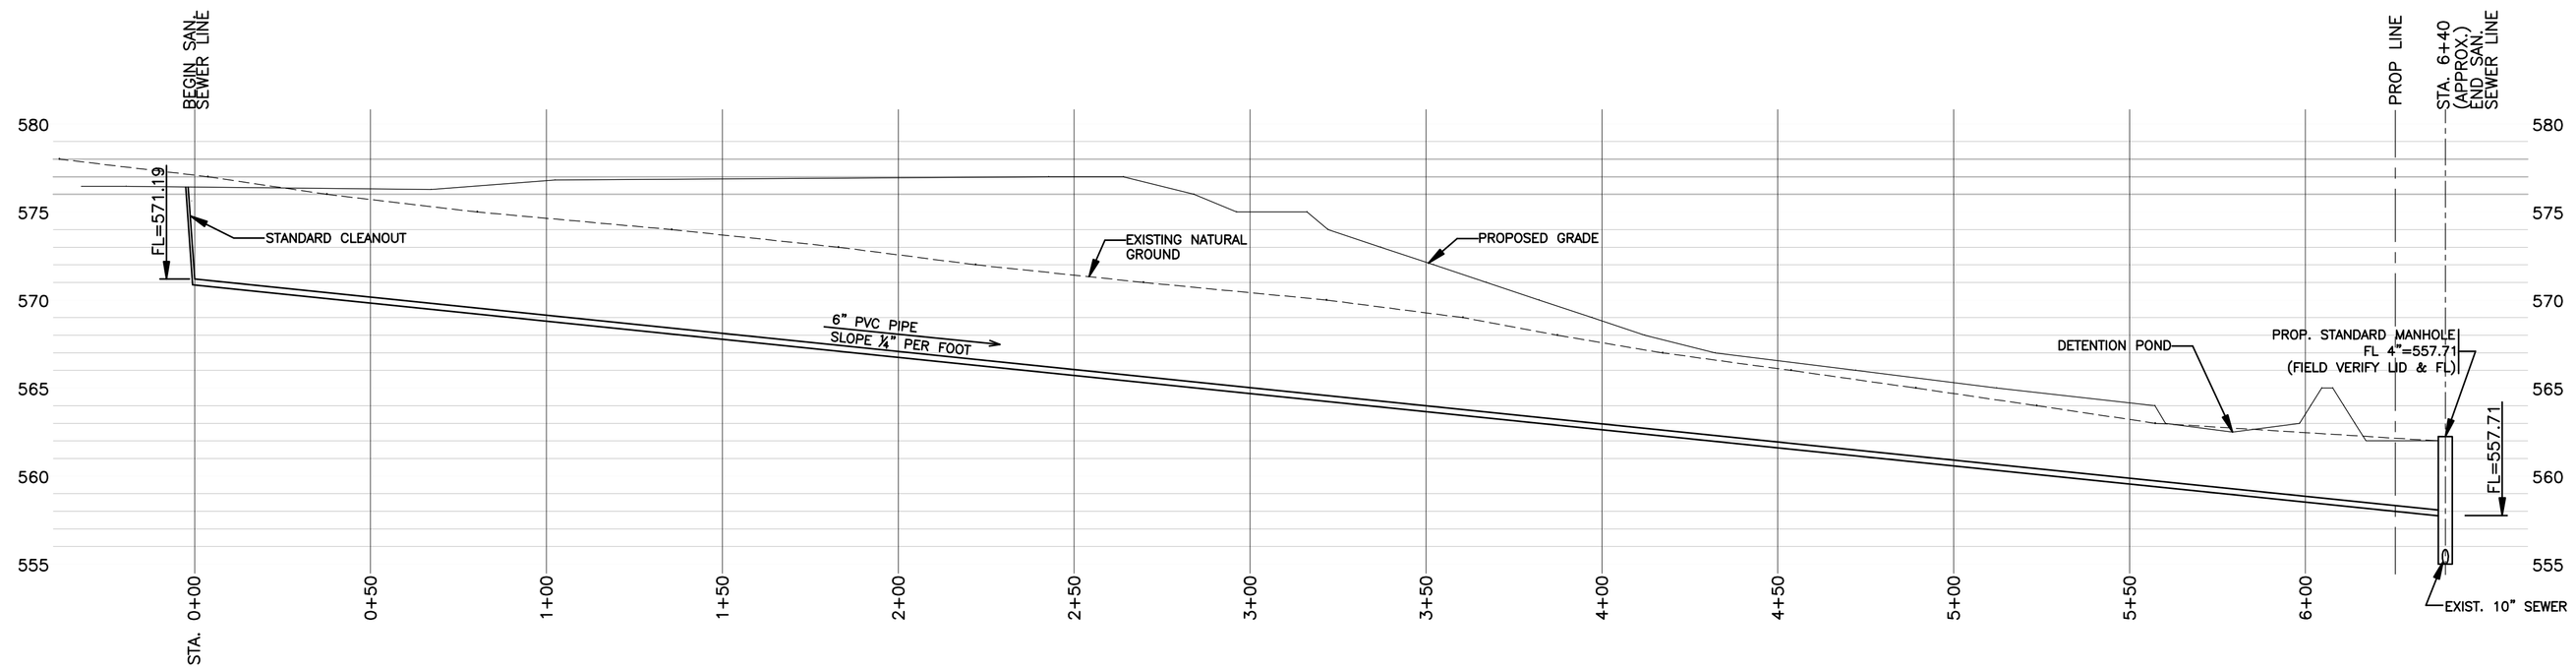

PRIVATE SANITARY SEWER PROFILE

SCALE: H: 1" = 30'-0" V: 1" = 6'-0"

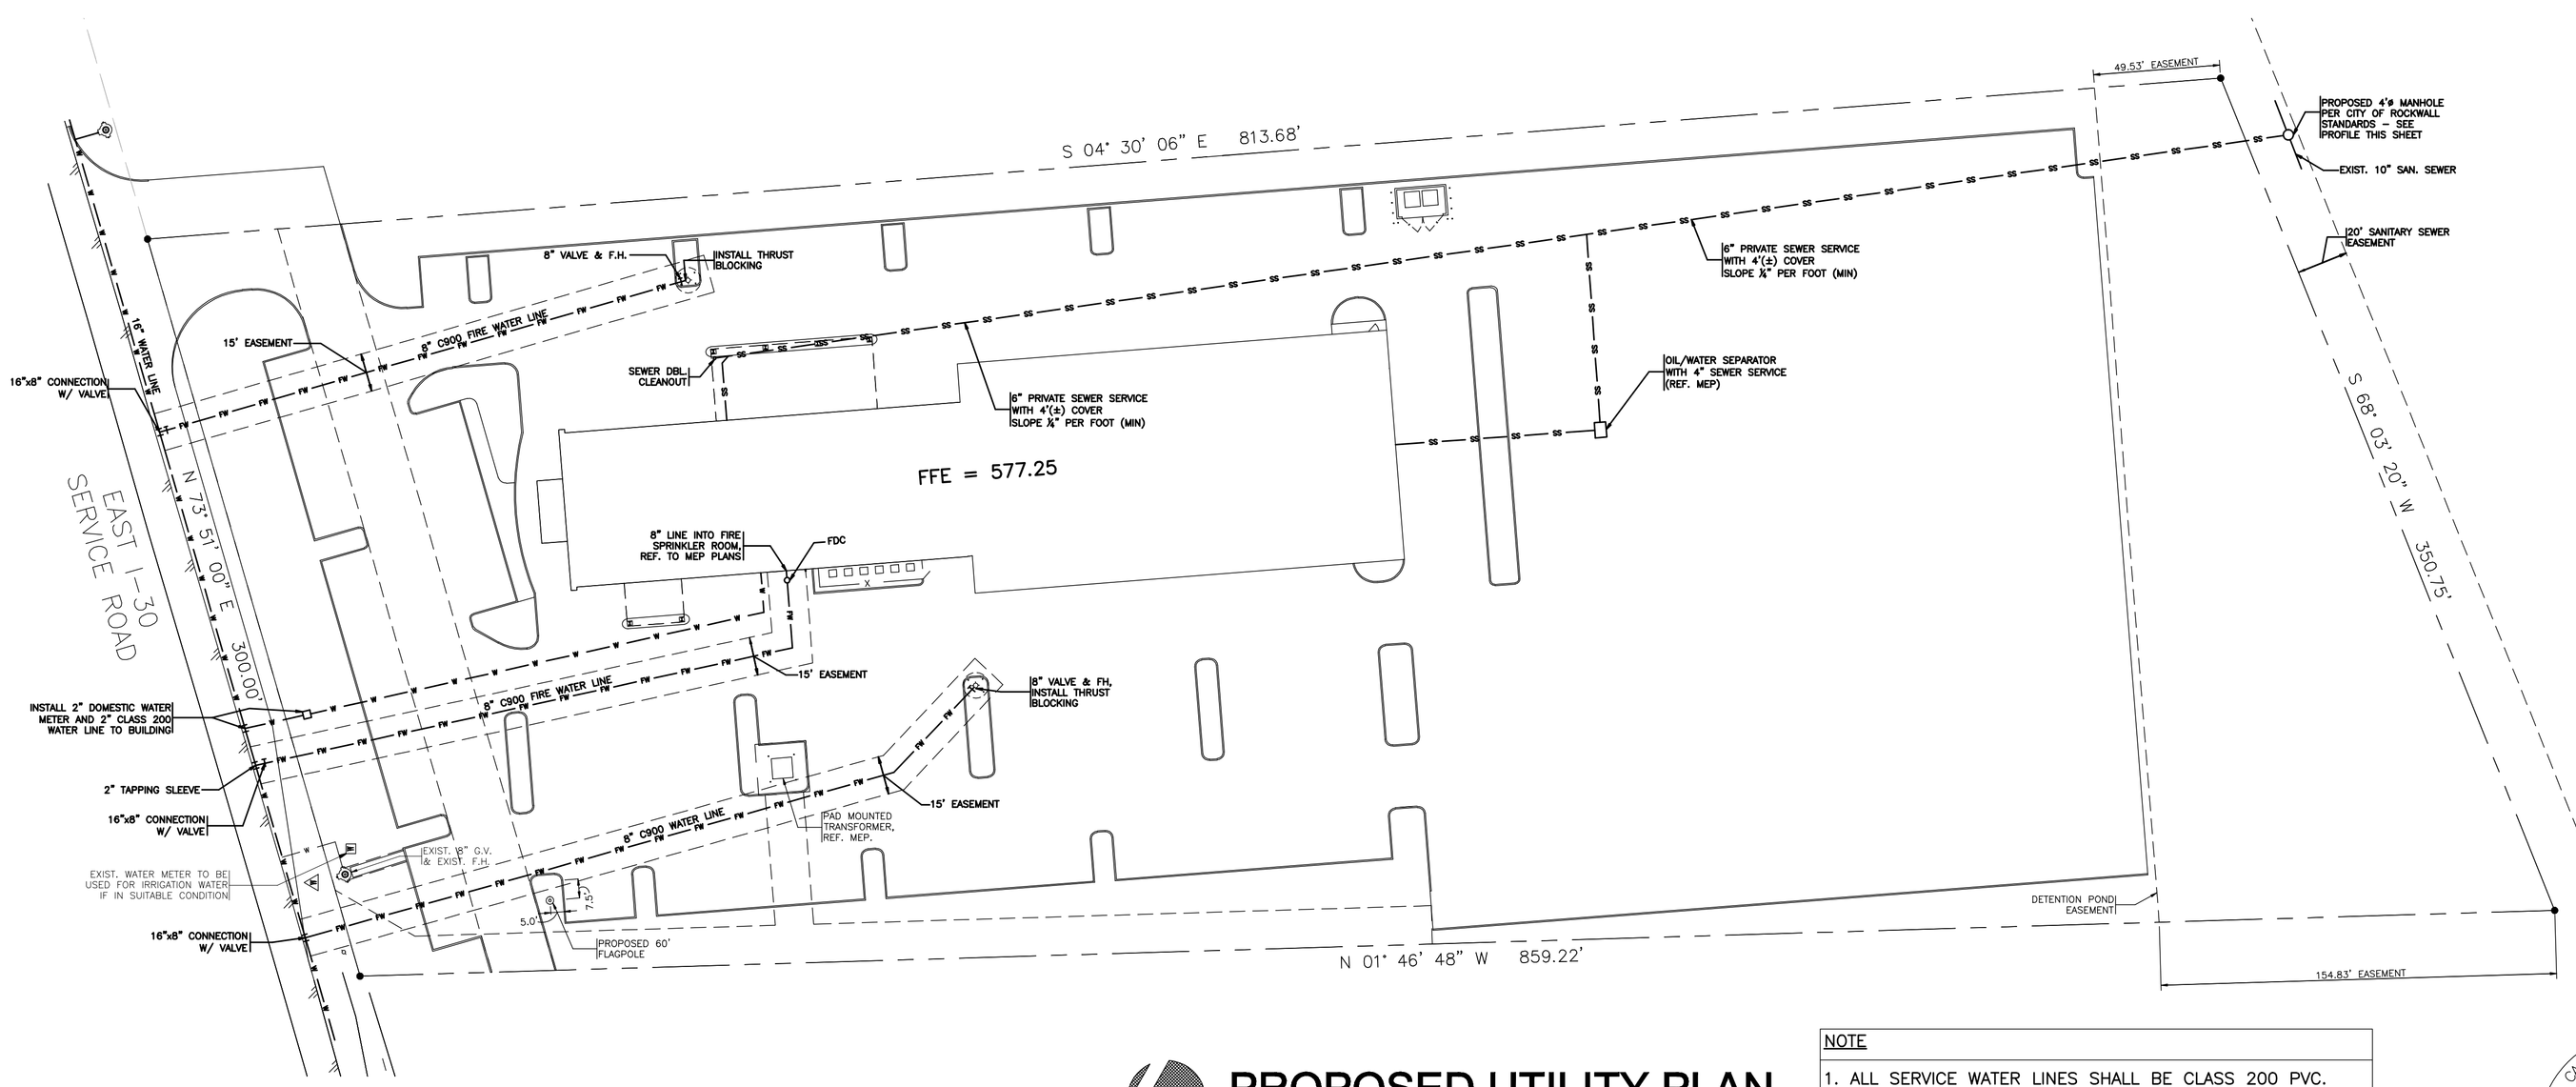

NORTH

PROPOSED UTILITY PLAN

SCALE: 1" = 40'-0"

NOTE:

CONTRACTOR SHALL SUBMIT TO THE ENGINEER, ARCHITECT, AND OWNER A TRENCH SAFETY PLAN DETAILING THE SAFETY MEASURES PROVIDED FOR THE EXCAVATION REQUIRED TO INSTALL THE PROPOSED DOMESTIC WATER AND WASTE WATER LINES/LATERALS.

NOTE

1. ALL SERVICE WATER LINES SHALL BE CLASS 200 PVC.
2. ALL FIRE HYDRANTS SHALL HAVE 5' CLEARANCE.
3. BLUE EMS DISKS SHALL BE INSTALLED ON WATER LINES AT EVERY BEND, SERVICE, VALVE, AND CHANGE IN DIRECTION.
4. ALL SERVICES AND FIRE LINE SHALL HAVE DOUBLE CHECK AND BACKFLOW PREVENTORS.

LEGEND

—w—w— PROPOSED WATER LINE

—ss—ss— PROPOSED WASTE WATER LINE

CALL BEFORE YOU DIG 1-800-245-4545 TEXAS ONE CALL SYSTEM

g W C engineering, LP
4201 Spring Valley Road Ste. 1120
Farmers Branch, Tx 75244
(tel)469-374-0810 (fax)469-374-0811
(email) production@gwcengineering.com

Preston Engineering & Construction
12770 Coit Rd., Suite # 902 Dallas, TX 75251
Phone 972-991-0498 Fax 972-991-0499

New Facility for New Car Dealership

Rockwall Kia

1790 East Interstate 30
Rockwall, Texas

AS-BUILT DRAWINGS

STATE OF TEXAS
J. BRIAN CAMPBELL
75554
LICENSED PROFESSIONAL ENGINEER

11/13/08

REVISIONS:

DRAWN BY:	IMH
CHECKED BY:	JBC
ISSUE DATE:	JUN 2008
JOB NUMBER:	50304

SHEET NO:

C-5