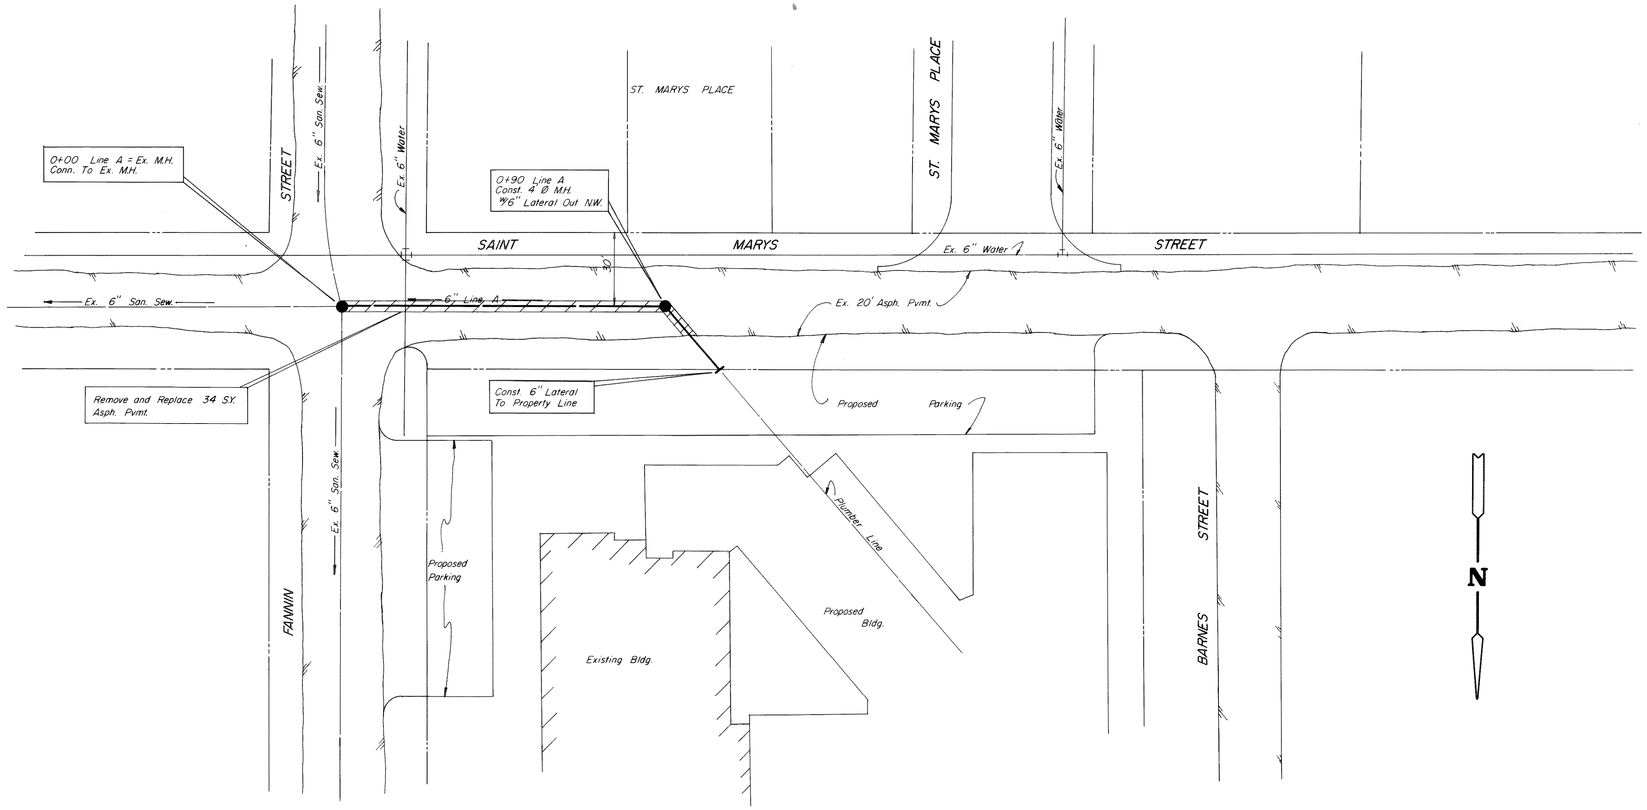

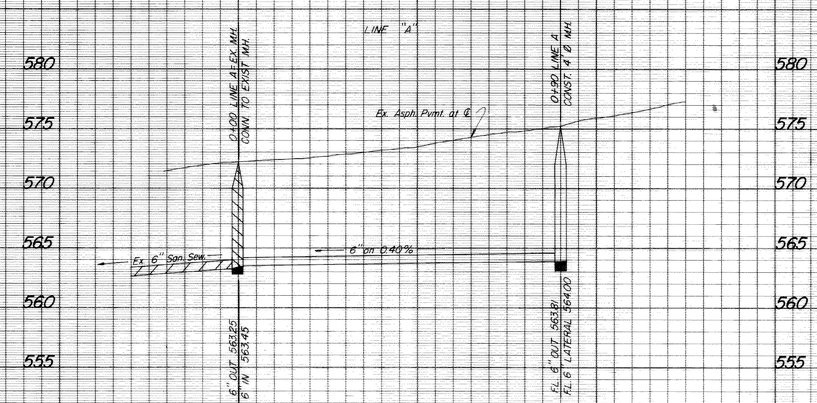

AS BUILT

SANITARY SEWER PLAN						
IN SAINT MARY'S STREET						
SERVING ROCKWALL NURSING HOME						
CITY OF ROCKWALL ····· ROCKWALL COUNTY, TEXAS						
HAROLD L. EVANS ∽ CONSULTING ENGINEER						
DESIGN	DRAWN	DATE	SCALE	NOTES	FILE	NO.
P.N.	T.L.O.	JAN., 1984	1"=20' H. 1"=6' V.			83269

D/S