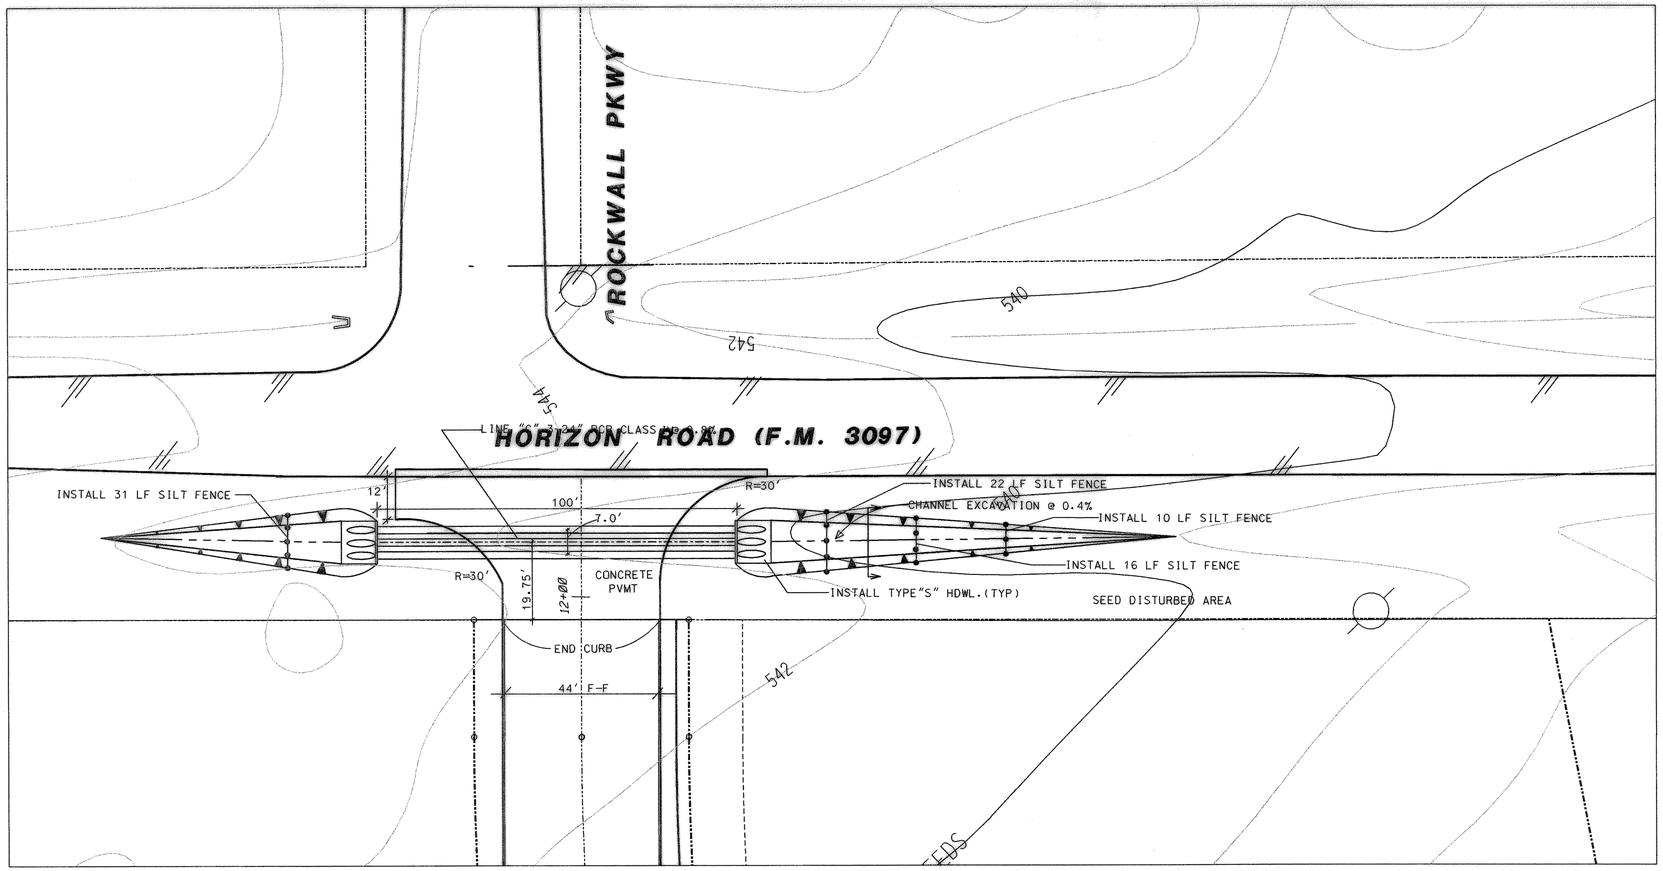

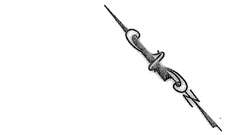

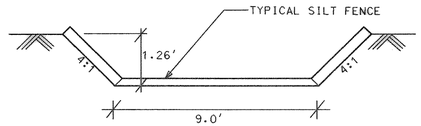

TYPICAL CHANNEL SECTION @ 1+80

NTS

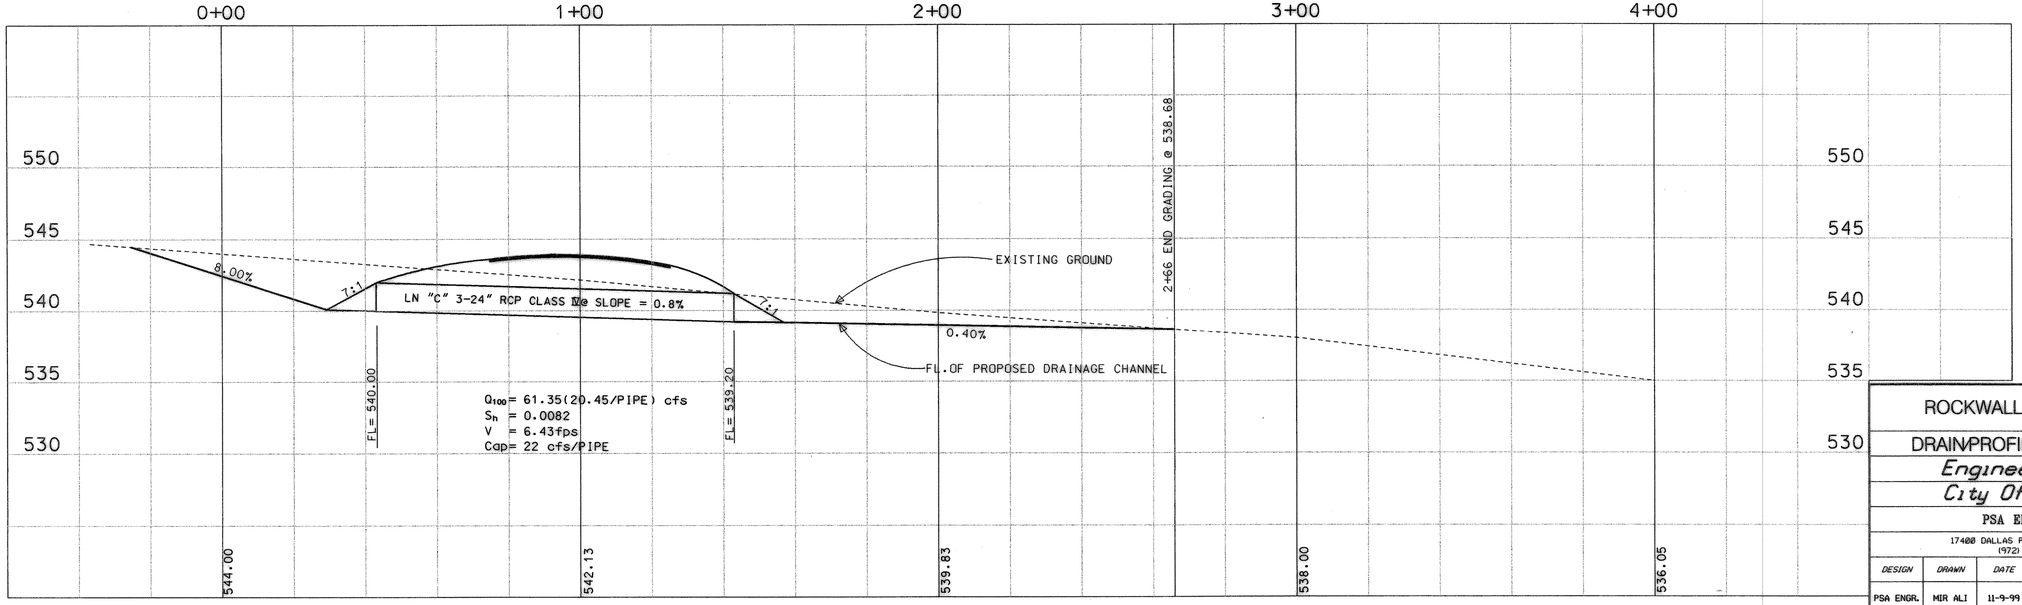

STATE OF TEXAS
PANSAK SRIBHEN
40320
REGISTERED PROFESSIONAL ENGINEER
11.19.99

D-3

ROCKWALL PKWY. IMPROVEMENTS

DRAIN/PROFILE STA 0+00 TO 4+00

Engineering Department

City Of Rockwall, Texas

PSA ENGINEERING-DALLAS, TEXAS

17400 DALLAS PARKWAY, SUITE 110, DALLAS, TEXAS 75287
(972) 248-9651 FAX (972) 248-9681

DESIGN	DRAWN	DATE	SCALE	NOTES	FILE	NO.
PSA ENGR.	MIR ALI	11-9-99	1"=20' H 1"=5' V	PSA ENGR.	PSA	9907.HRC

AS-BUILT

E:\dwg\9907\rc\dprmtc3.dgn Nov. 18, 1999 12:00:03