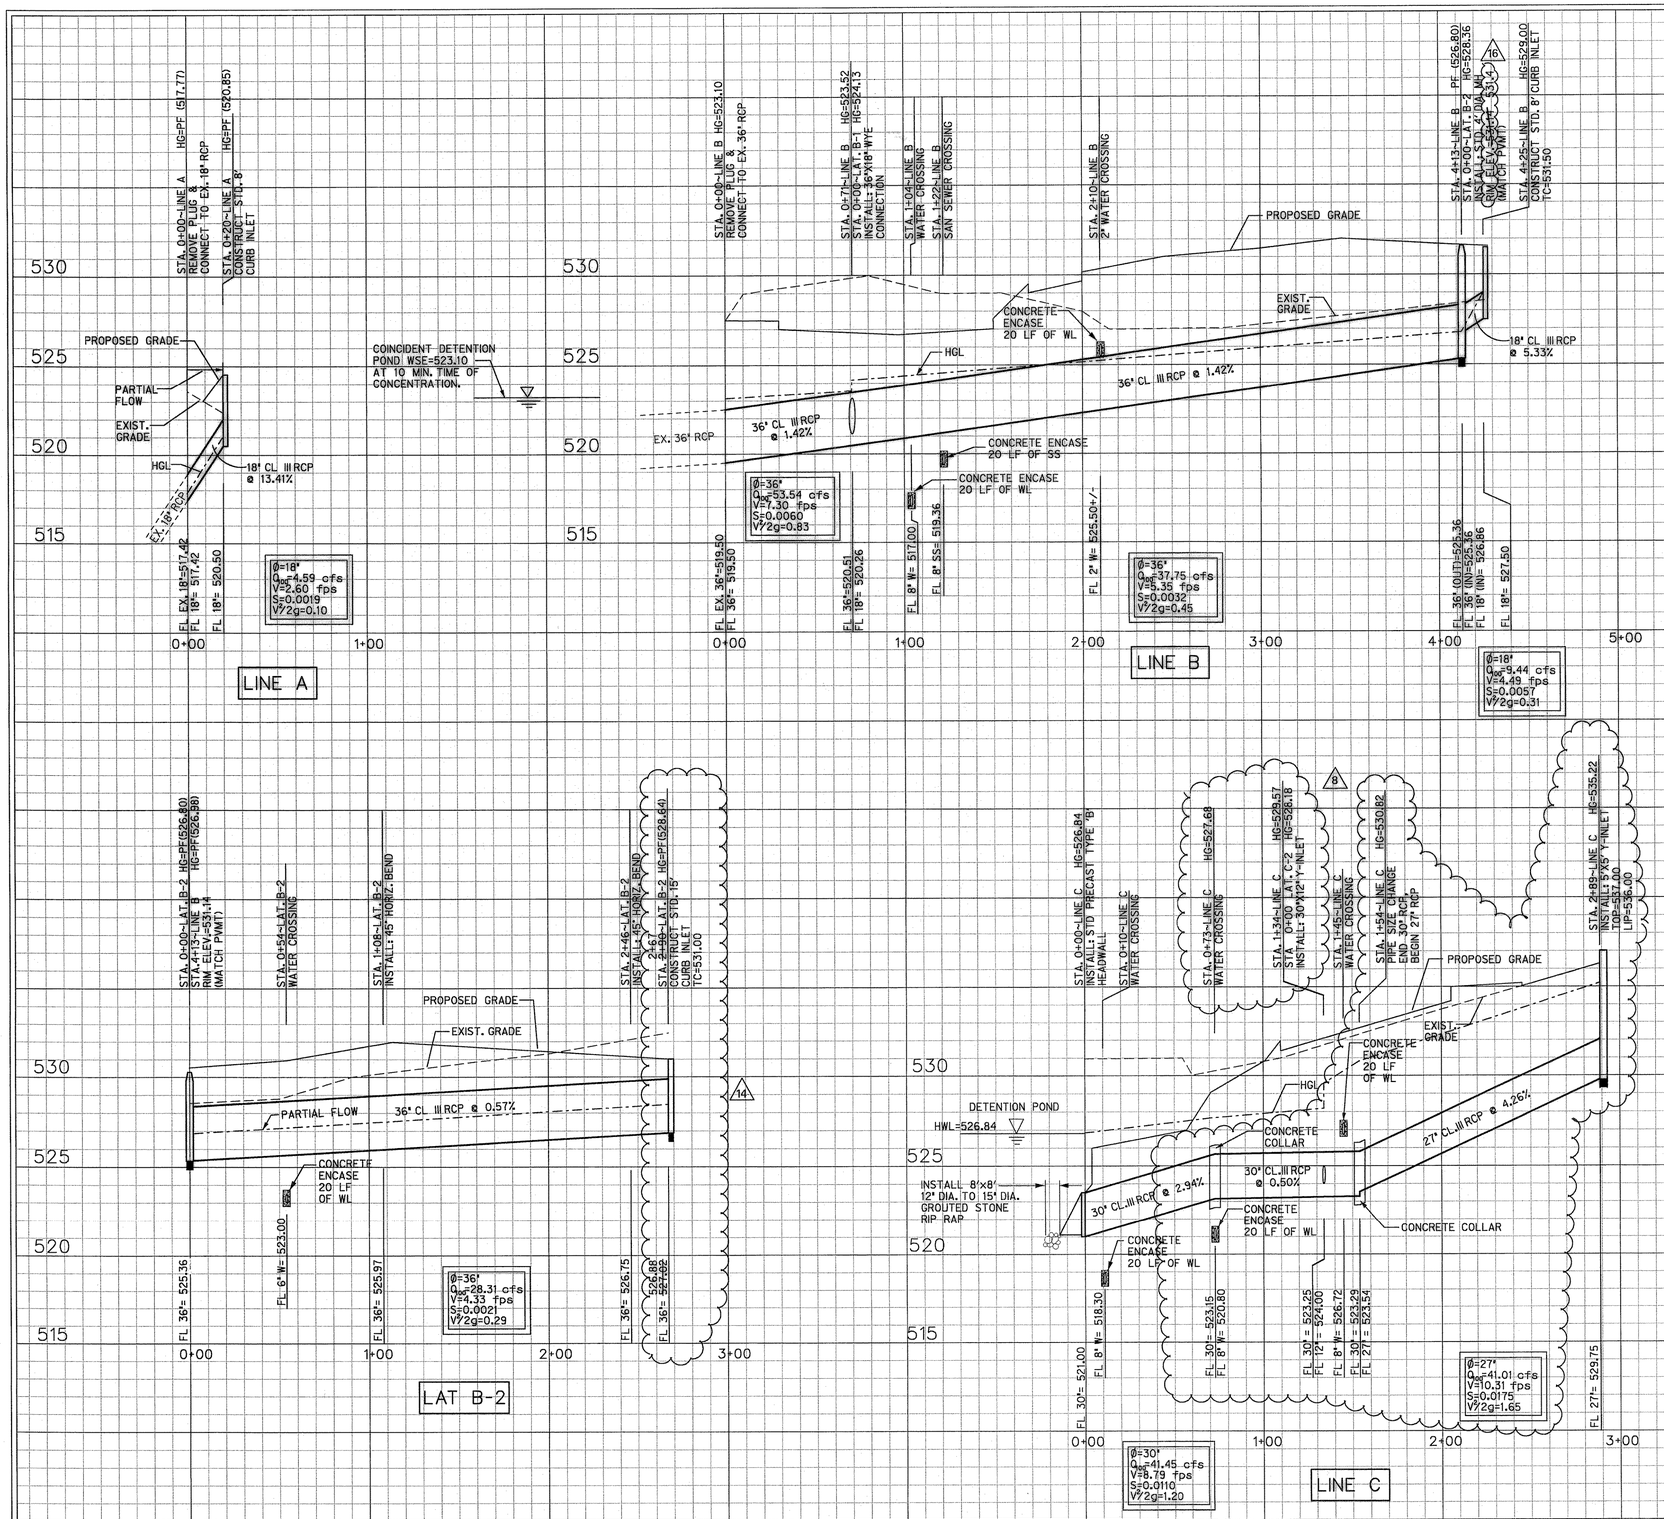

RIDGE ROAD TOWN CENTRE
ROCKWALL, TEXAS

Ridge Road Town Centre Partners, L.P.
by its General Partners:
RIDGE ROAD PARTNERS L.L.C.

MARK W. McGRAW
83967
LICENSED
PROFESSIONAL ENGINEER
10-26-04

Halff Associates, Inc.
ENGINEERS · ARCHITECTS · SCIENTISTS · PLANNERS · SURVEYORS
8616 NORTHWEST PLAZA DRIVE
DALLAS, TEXAS 75225
TEL (214) 346-6200
FAX (214) 739-0095

Project No:	AVO # 20817
Issued:	

Revisions:

No.	Date	Description
1	11/04/02	FIRST SUBMITTAL
2	4/09/03	SECOND SUBMITTAL
3	5/09/03	THIRD SUBMITTAL
4	6/09/03	FOURTH SUBMITTAL
5	7/02/04	FIFTH SUBMITTAL
7	12/29/04	SEVENTH SUBMITTAL

Drawn by:
Checked by:
Sheet Title
STORM SEWER PROFILES
Sheet Number
C5.2

16 02-08-06 RECORD DRAWINGS
14 9/22/05 ELIMINATED 26 PARKING SPACES
8 11/30/04 REVISED STORM, CONFLICT

I:\20000s\20817a\dgn\civil\817cad02.dgn 2/8/2006 9:56:44 AM