
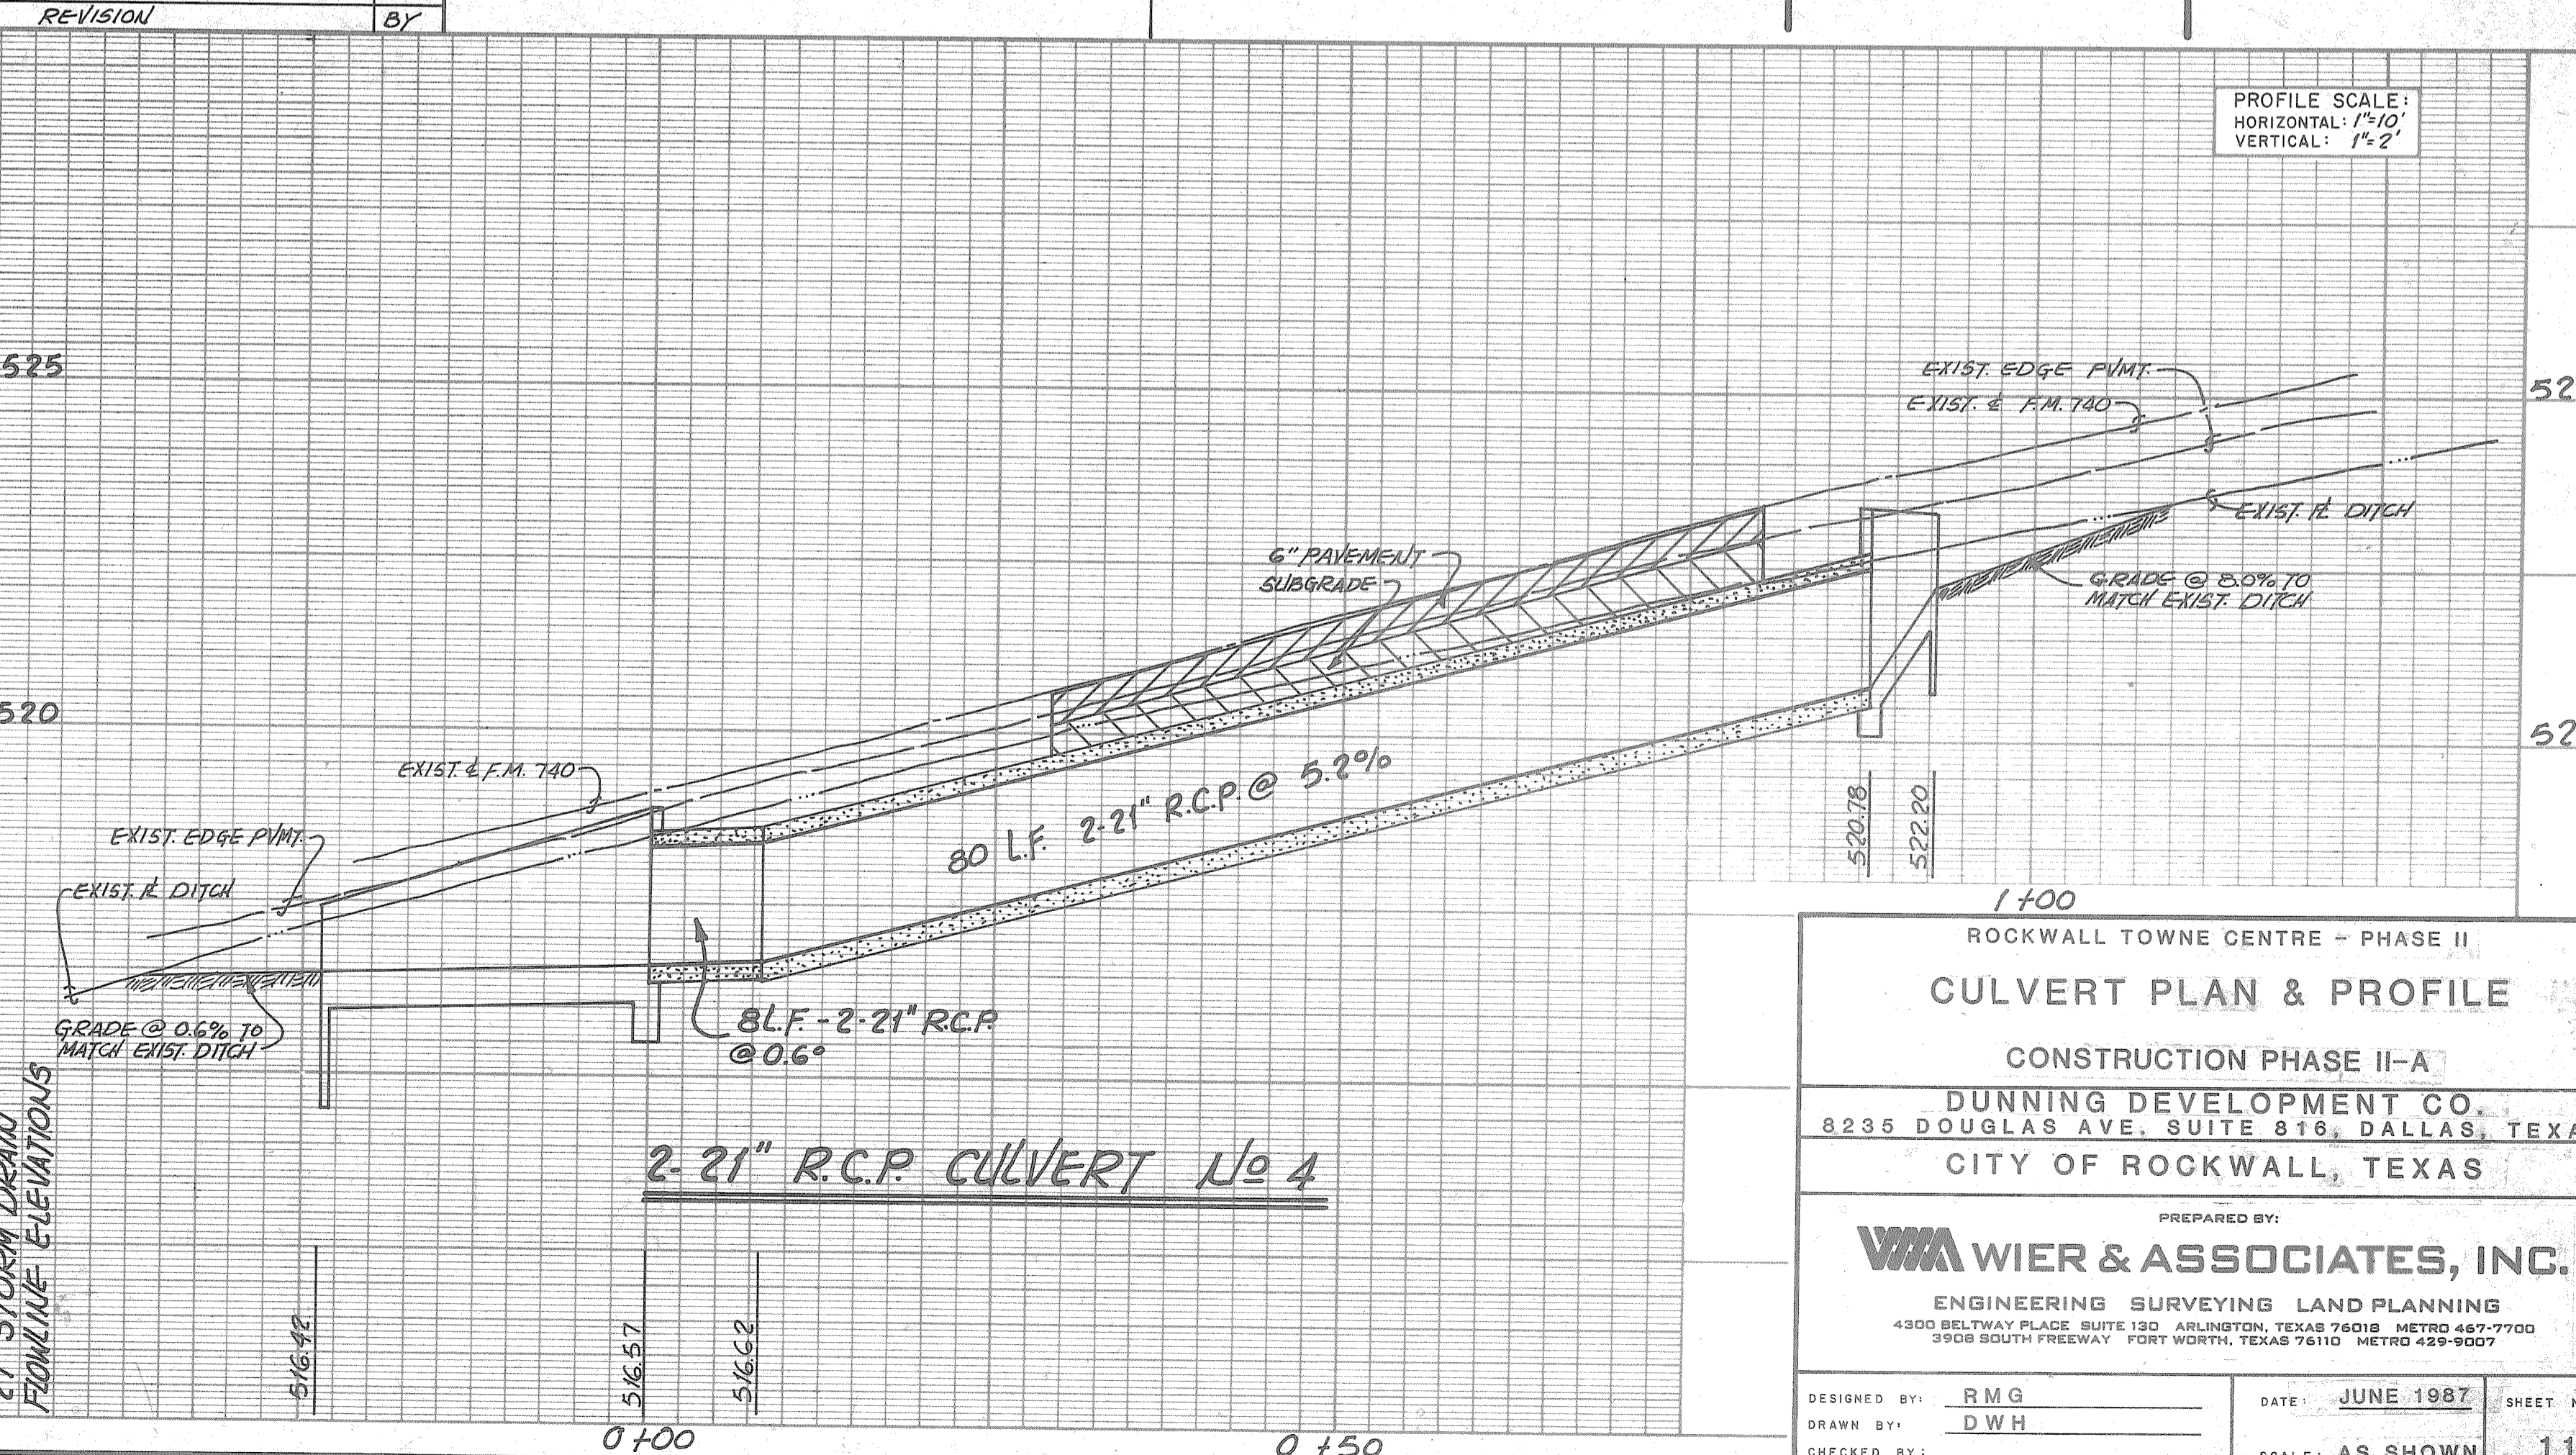


Nº	DATE	REVISION	BY
1	9/10/88	COMPLETE REDRAW - BOTH CULVERTS	RMG
		REVISION	

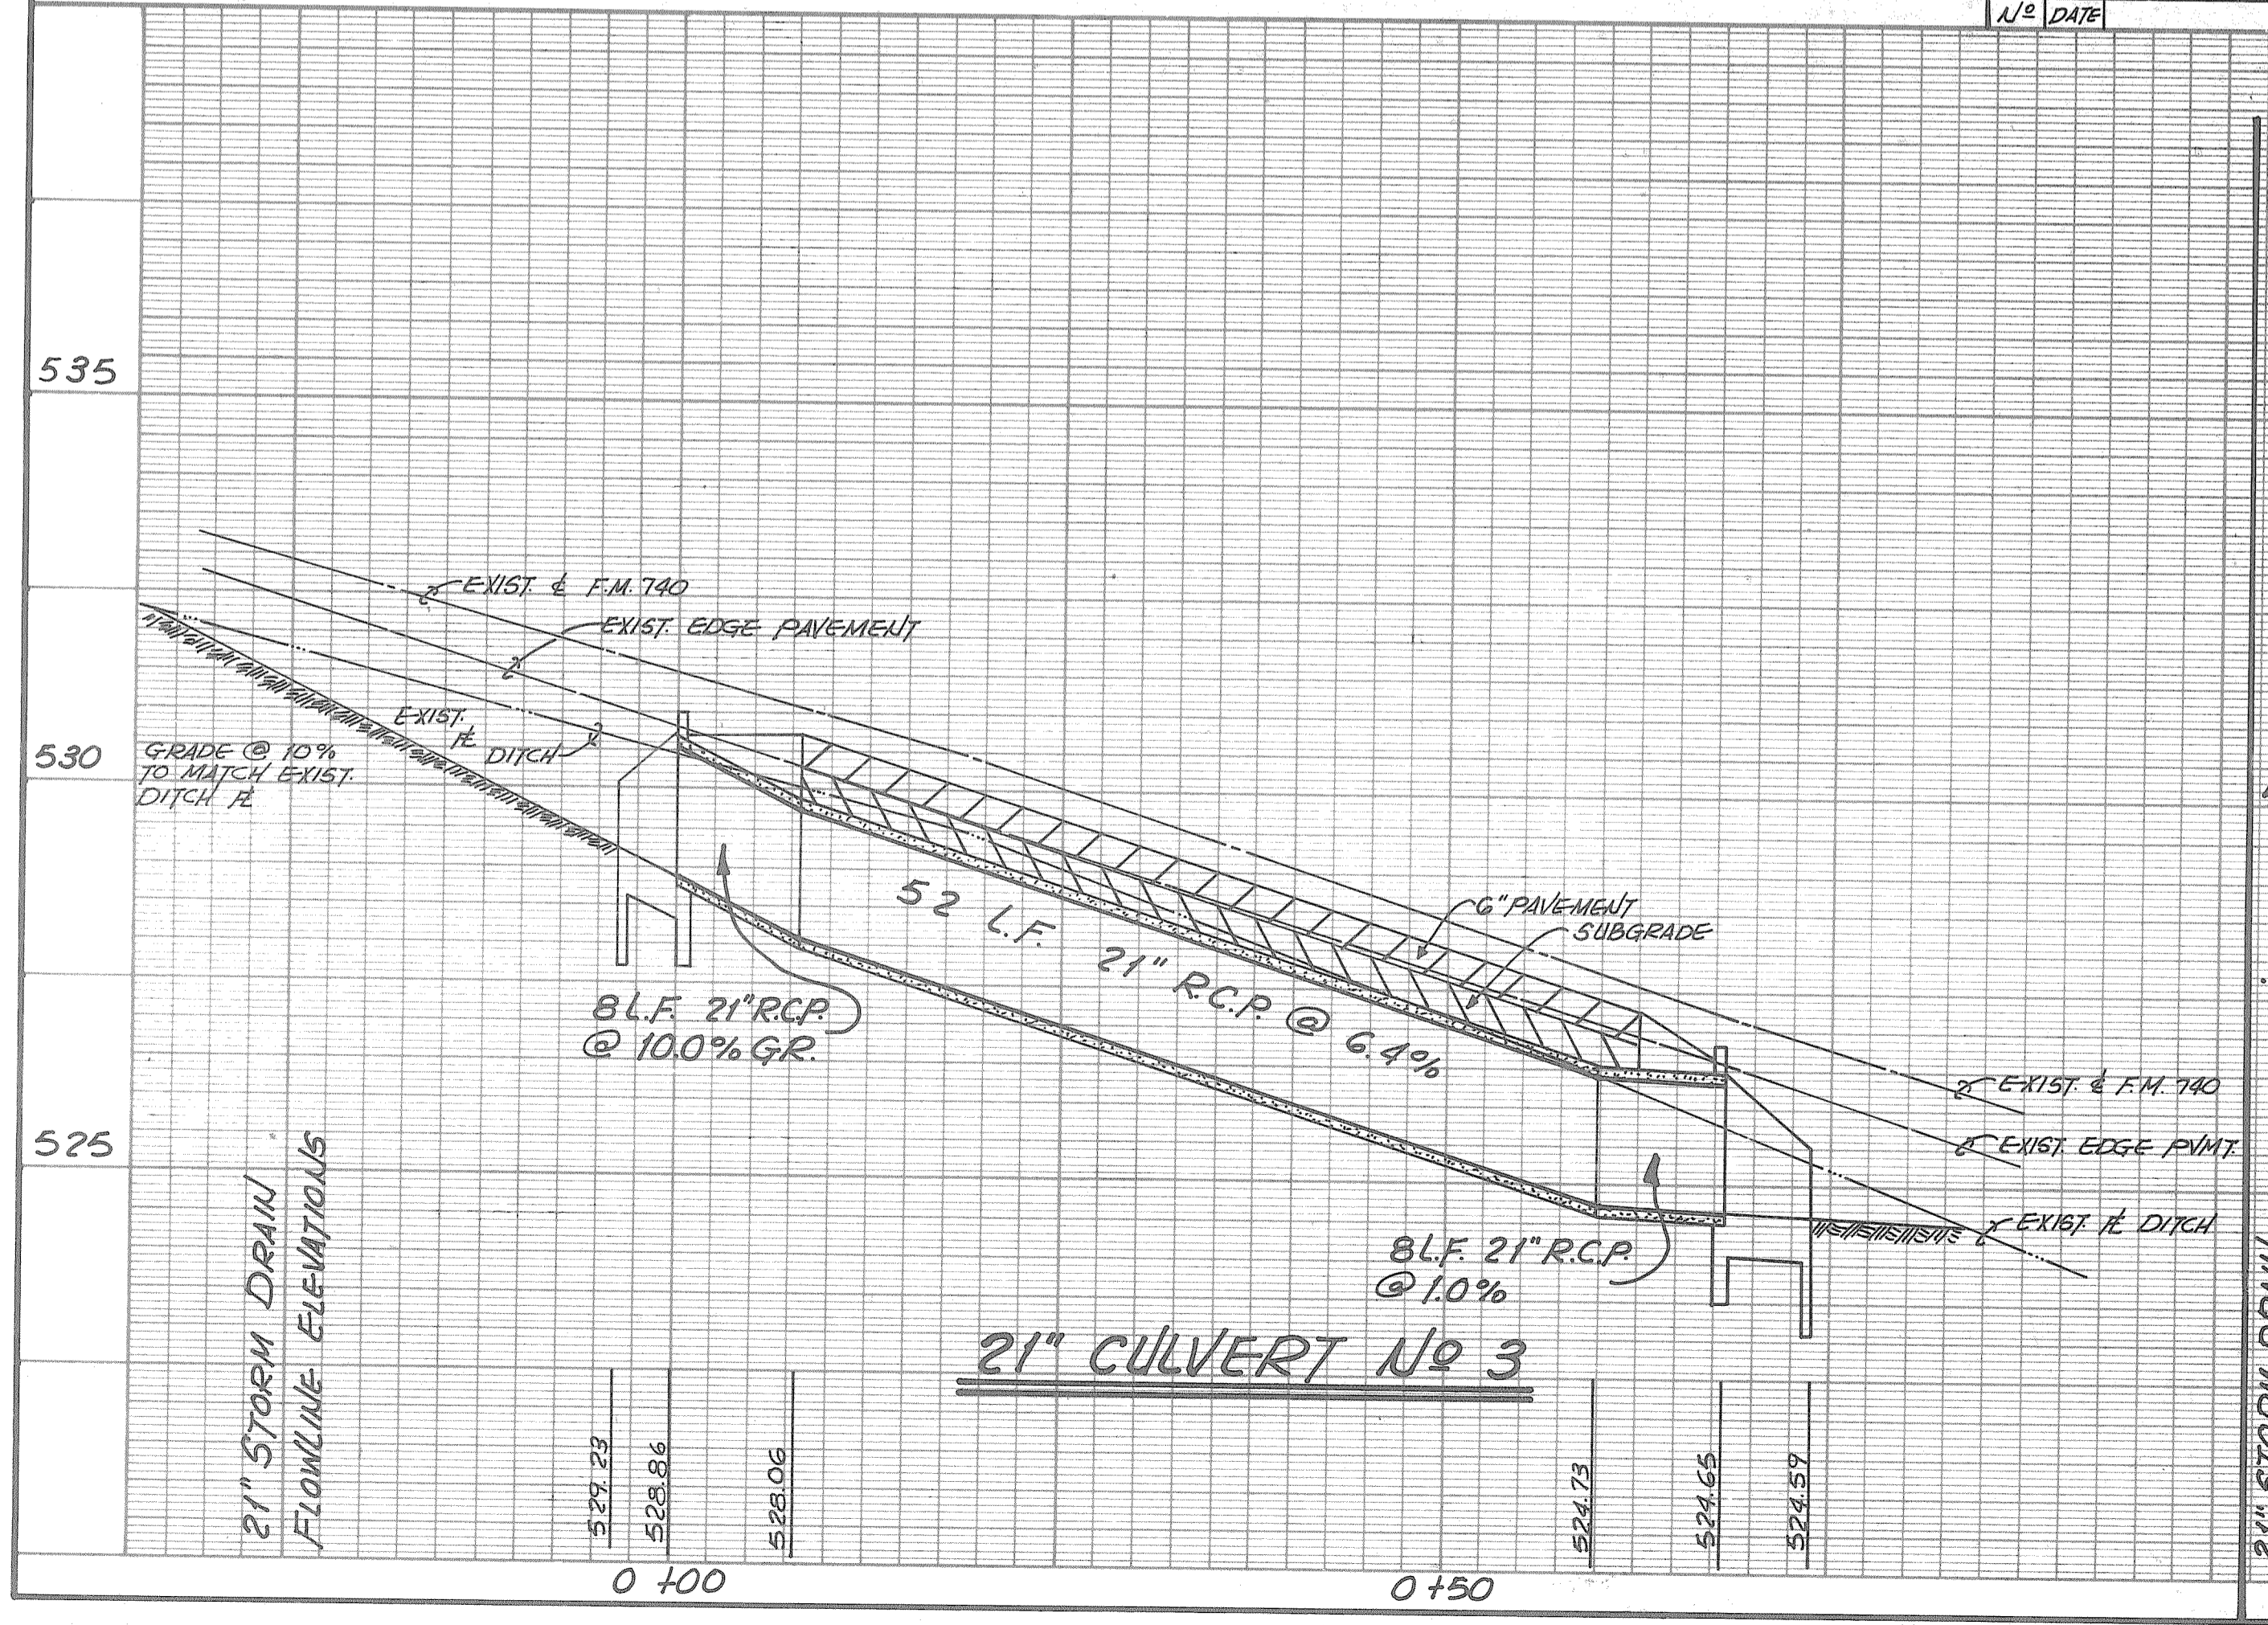

PROFILE SCALE:
 HORIZONTAL: 1"=10'
 VERTICAL: 1"=2'

1+00
 ROCKWALL TOWN CENTRE - PHASE II
CULVERT PLAN & PROFILE
 CONSTRUCTION PHASE II-A
 DUNNING DEVELOPMENT CO.
 8235 DOUGLAS AVE. SUITE 816, DALLAS, TEXAS
 CITY OF ROCKWALL, TEXAS

PREPARED BY:
WIER & ASSOCIATES, INC.
 ENGINEERING SURVEYING LAND PLANNING
 4300 BELTWAY PLACE SUITE 130 ARLINGTON, TEXAS 76010 METRO 487-7700
 3808 SOUTH FREEWAY FORT WORTH, TEXAS 76110 METRO 429-9007

DESIGNED BY: RMG	DATE: JUNE 1987	SHEET NO.
DRAWN BY: DWH		11
CHECKED BY:	SCALE: AS SHOWN	

WA 84-049