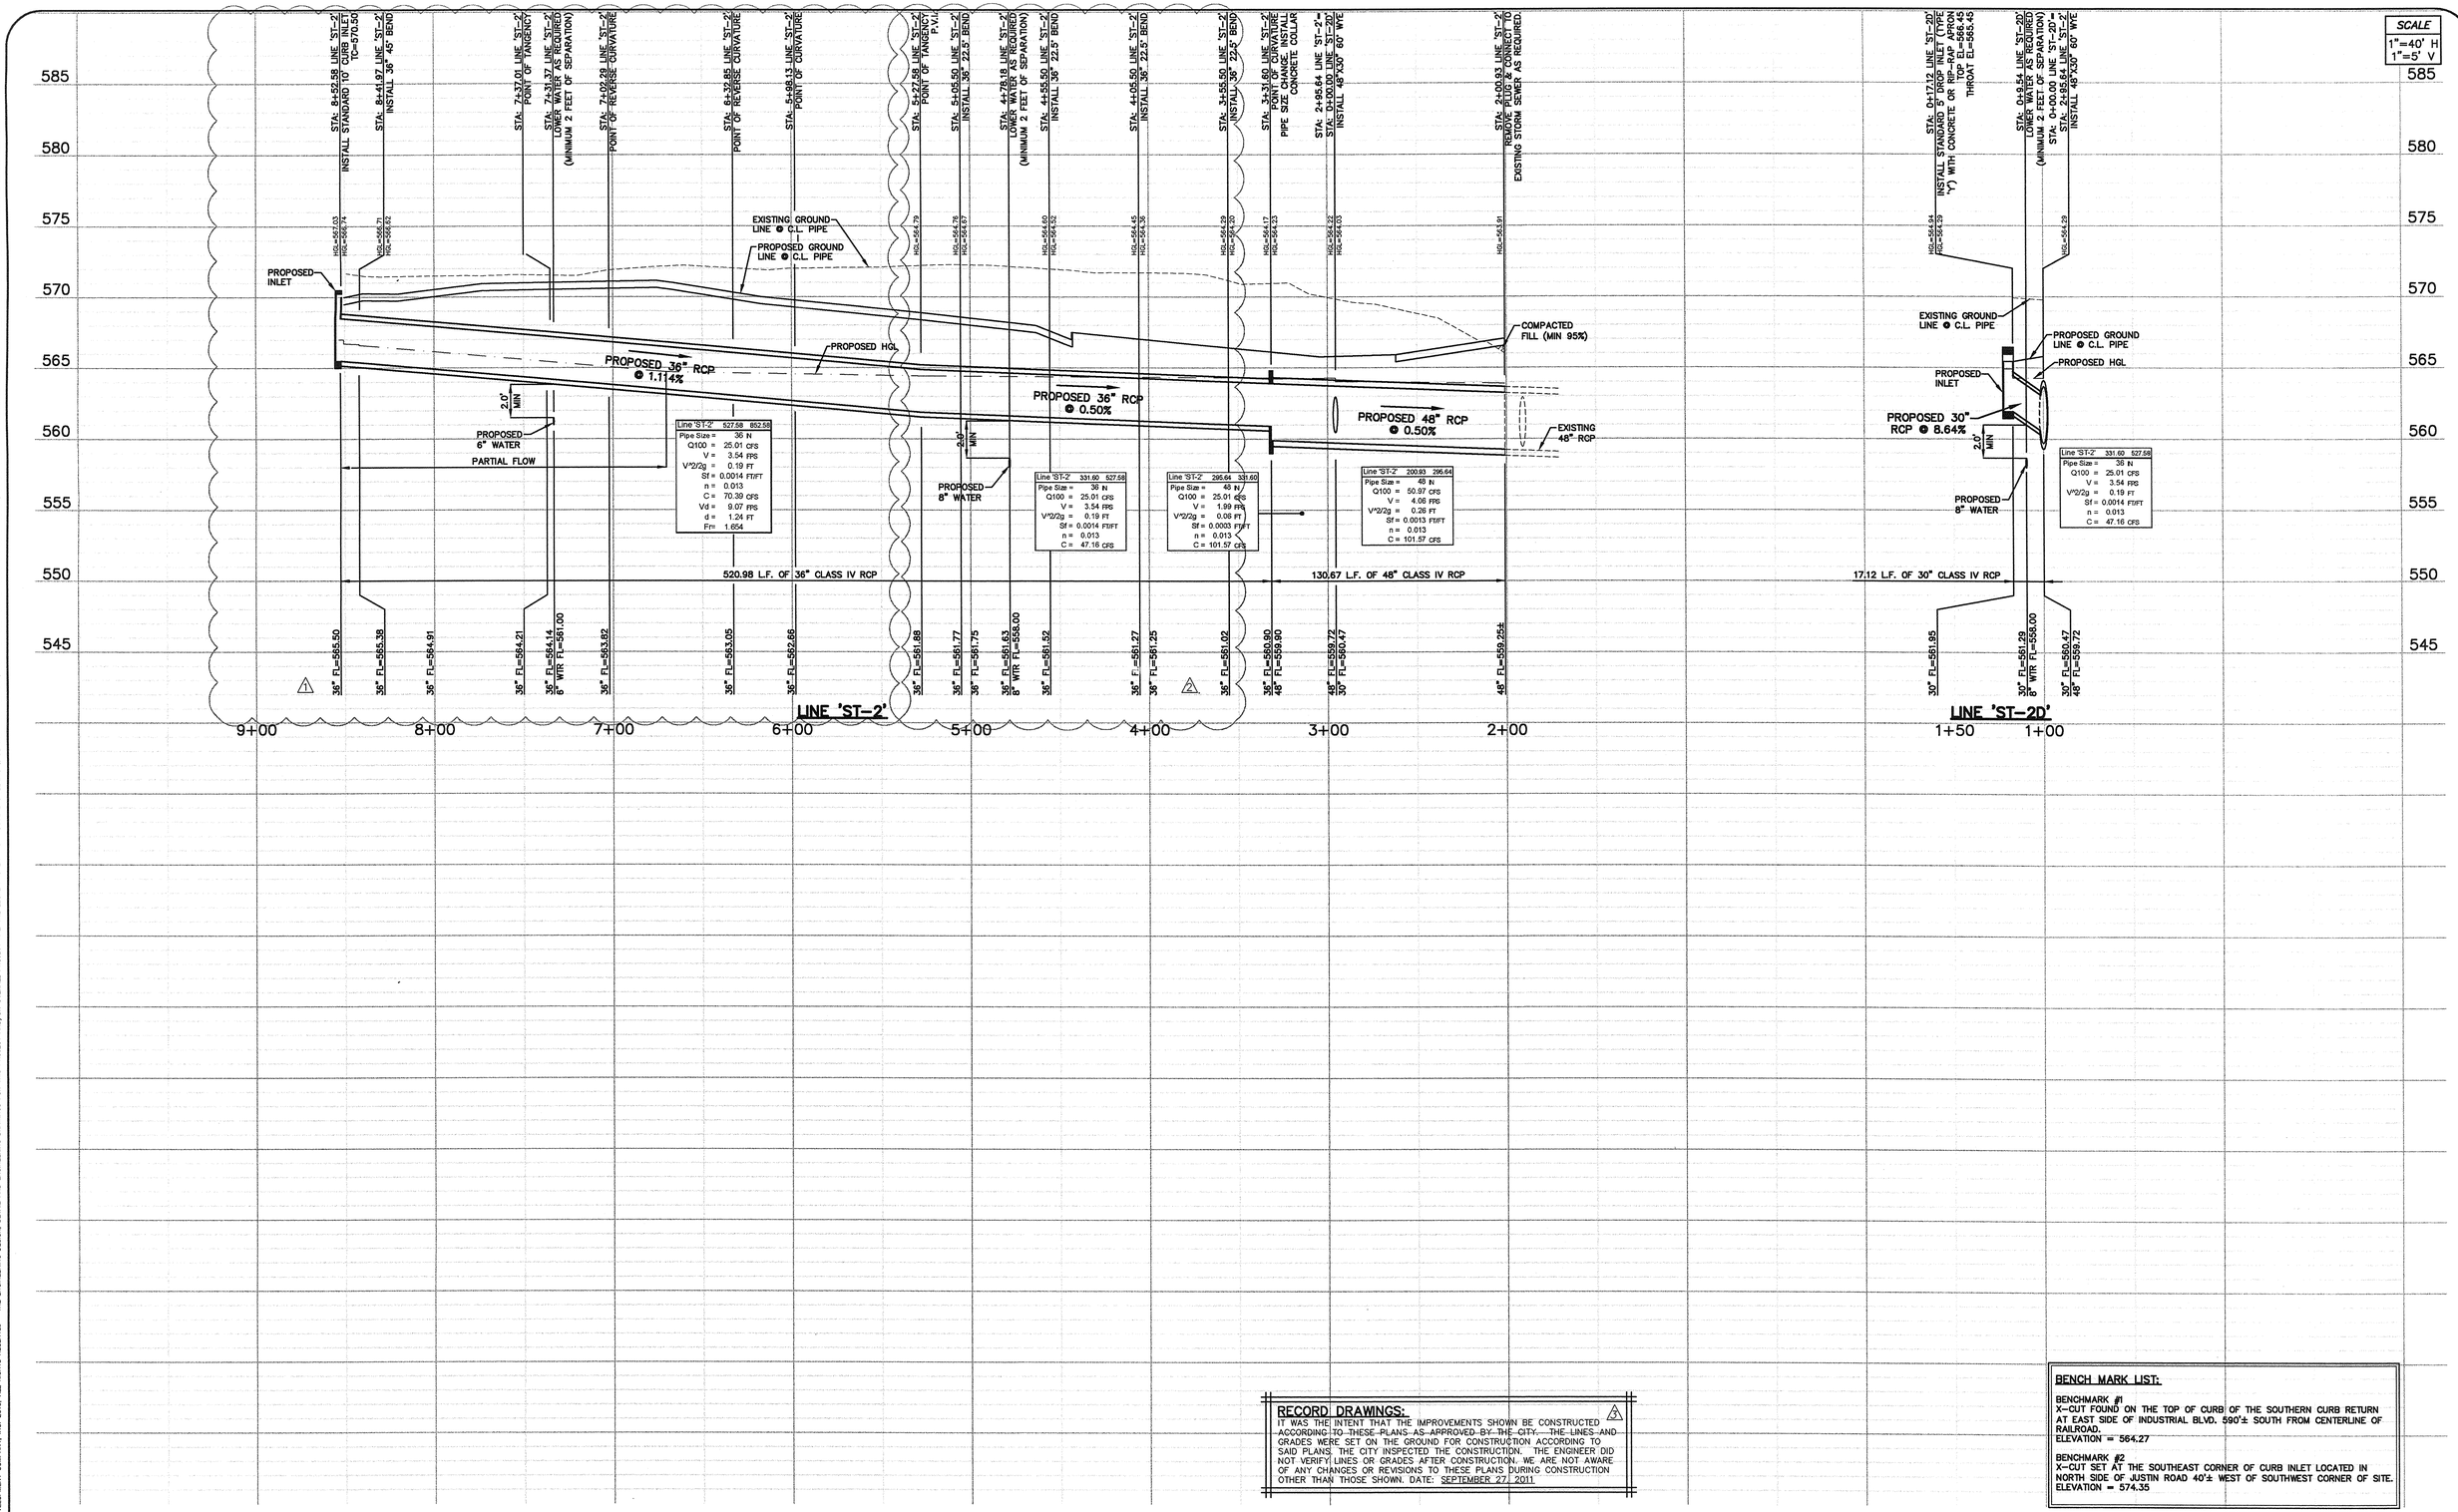

SPR PACKAGING – EXPANSION

RECORD DRAWINGS:

IT WAS THE INTENT THAT THE IMPROVEMENTS SHOWN BE CONSTRUCTED ACCORDING TO THESE PLANS AS APPROVED BY THE CITY. THE LINES AND GRADES WERE SET ON THE GROUND FOR CONSTRUCTION ACCORDING TO SAID PLANS. THE CITY INSPECTED THE CONSTRUCTION. THE ENGINEER DID NOT VERIFY LINES OR GRADES AFTER CONSTRUCTION. WE ARE NOT AWARE OF ANY CHANGES OR REVISIONS TO THESE PLANS DURING CONSTRUCTION OTHER THAN THOSE SHOWN. DATE: SEPTEMBER 27, 2011

BENCH MARK LIST:

BENCHMARK #1
X-CUT FOUND ON THE TOP OF CURB OF THE SOUTHERN CURB RETURN AT EAST SIDE OF INDUSTRIAL BLVD. 590'± SOUTH FROM CENTERLINE OF RAILROAD.
ELEVATION = 564.27

BENCHMARK #2
X-CUT SET AT THE SOUTHEAST CORNER OF CURB INLET LOCATED IN NORTH SIDE OF JUSTIN ROAD 40'± WEST OF SOUTHWEST CORNER OF SITE.
ELEVATION = 574.35

NO.	DATE	REVISION / DESCRIPTION
3	09-27-11	RECORD DRAWINGS
2	05-24-11	RFI #6 (ST-2; DELETED RADIUS PIPE)
1	05-17-11	COORDINATION AROUND 20" TREE

DESIGN	DRAWN	DATE	PI NUMBER
RPP	WTW	03-07-2011	1312-10-069

OWNER
FLEXLAND, L.P.
1480 JUSTIN ROAD
ROCKWALL, TEXAS 75087
MR. STEVEN ROSENBERG
(469) 252-1070 PHONE
(469) 252-1069 FAX

DEVELOPER
SPR PACKAGING, INC.
1480 JUSTIN ROAD
ROCKWALL, TEXAS 75087
MR. STEVEN ROSENBERG
(469) 252-1070 PHONE
(469) 252-1069 FAX

THE SEAL APPEARING ON THIS DOCUMENT WAS AUTHORIZED BY RANDALL P. POGUE, P.E. 84780 ON 09-07-2011. ALTERATION OF A SEALED DOCUMENT WITHOUT PROPER NOTIFICATION TO THE RESPONSIBLE ENGINEER IS AN OFFENSE UNDER THE TEXAS ENGINEERING PRACTICE ACT.

STATE OF TEXAS
RANDALL P. POGUE
84780
LICENSED
PROFESSIONAL ENGINEER

POGUE
ENGINEERING & DEVELOPMENT COMPANY, INC.
1512 BRAY CENTRAL DRIVE
SUITE 100
McKINNEY, TEXAS 75069
(214) 544-8880 PHONE
(214) 544-8882 FAX
www.PogueEngineering.com

STORM SEWER PROFILES

SPR PACKAGING – EXPANSION
BLOCK A, LOT 2, SPR PACKAGING ADDITION
NWC OF INDUSTRIAL BLVD. @ JUSTIN ROAD
CITY OF ROCKWALL, TEXAS

SHEET NO. C5.02

RPOGUE 09/27/2011 – 1:51PM
N:\JOBS\1300-1399\1312-10-069\DWG\1312-10-069-STORM PLAN.DWG
© POGUE ENGINEERING & DEVELOPMENT COMPANY, INC. 2010. ALL RIGHTS RESERVED. THE EXPANDING DESIGN, DETAIL AND ENGINEERING DRAWINGS FOR THIS PROJECT AND/OR OVERALL PROJECT ARE THE LEGAL PROPERTY OF POGUE ENGINEERING & DEVELOPMENT COMPANY, INC. THEIR USE FOR REPRODUCTION, CONSTRUCTION, OR DISTRIBUTION IS PROHIBITED UNLESS AUTHORIZED IN WRITING BY POGUE ENGINEERING & DEVELOPMENT COMPANY, INC.
TEXAS BOARD OF PROFESSIONAL ENGINEERS, CERTIFICATE OF REGISTRATION #F-000461; TEXAS BOARD OF PROFESSIONAL LAND SURVEYING, CERTIFICATE OF REGISTRATION 10042I-00