CONSTRUCTION PLANS
for
SWBC ROCKWALL

LOT 1, BLOCK A
SWBC ROCKWALL ADDITION, PHASE I
21.280 Acres

in the

J.M. ALLEN SURVEY, ABSTRACT NO. 2
CITY OF ROCKWALL
ROCKWALL COUNTY, TEXAS
DECEMBER 2018

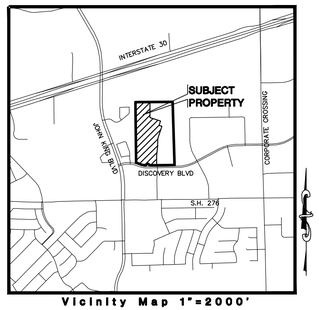

Vicinity Map 1"=2000'

Sheet List Table

C	COVER SHEET
C1	FINAL PLAT
C2	FINAL PLAT
C3	FINAL PLAT
C4	GENERAL NOTES
C5	OVERALL SITE & PHASING PLAN
C6	SITE & DIMENSIONAL CONTROL PLAN
C7	SITE & DIMENSIONAL CONTROL PLAN
C8	PAVING PLAN
C9	PAVING PLAN
C10	GRADING PLAN
C11	GRADING PLAN
C12	EXISTING DRAINAGE AREA MAP
C13	PROPOSED DRAINAGE AREA MAP
C14	ULTIMATE DRAINAGE AREA MAP
C15	DETENTION POND A
C16	DETENTION POND A DETAILS
C17	DETENTION POND A DETENTION CALCULATIONS
C18	DETENTION POND A OUTFALL CALCULATIONS
C19	DETENTION POND B
C20	DETENTION POND B DETAILS
C21	HYDRUALIC CALCULATIONS
C22	STORM SEWER PLAN
C23	STORM SEWER PLAN
C24	STORM SEWER PROFILES
C25	STORM SEWER PROFILES
C26	STORM SEWER PROFILES

Sheet List Table

C27	SANITARY SEWER PLAN
C28	SANITARY SEWER PLAN
C29	SANITARY SEWER PROFILE
C30	SANITARY SEWER PROFILES
C31	WATER PLAN
C32	WATER PLAN
C33	WATER PROFILES
C34	WATER PROFILES
C35	WATER PROFILE
C36	EROSION CONTROL PLAN
C37	EROSION CONTROL PLAN
C38	STANDARD CONSTRUCTION DETAILS
C39	STANDARD CONSTRUCTION DETAILS
C40	STANDARD CONSTRUCTION DETAILS
~~L1.0~~	~~LANDSCAPE PLAN~~
~~L1.1~~	~~LANDSCAPE PLAN~~
~~L1.2~~	~~LANDSCAPE PLAN~~
~~L1.3~~	~~LANDSCAPE PLAN~~
~~L2.0~~	~~HARDSCAPE PLAN~~
~~L2.1~~	~~HARDSCAPE PLAN~~
~~L2.2~~	~~HARDSCAPE PLAN~~
~~L2.3~~	~~HARDSCAPE PLAN~~
~~L3.0~~	~~LANDSCAPE DETAILS~~
~~L3.1~~	~~LANDSCAPE DETAILS~~
~~T1.0~~	~~TREE SURVEY~~
~~T1.1~~	~~TREE SURVEY~~

AS-BUILT RECORD DRAWING

THE INFORMATION ON THESE PLANS HAS BEEN REVISED TO REFLECT CHANGES TO PUBLIC IMPROVEMENTS MADE DURING CONSTRUCTION. UNLESS OTHERWISE NOTED, THE CONSTRUCTION OF THE PUBLIC IMPROVEMENTS IS IN GENERAL CONFORMANCE WITH THESE PLANS, BASED UPON INFORMATION PROVIDED BY THE CONTRACTOR AND FIELD VERIFICATIONS. THE RESPONSIBILITY FOR ACCURACY AND COMPLETENESS BELONGS TO THE CONTRACTOR.

Matthew G. St. Marie
THE JOHN R MCADAMS COMPANY, INC.

Date: 03/04/2021

OWNER/DEVELOPER
SWBC BUILDERS
5949 SHERRY LANE #750
DALLAS, TX 75225
Ph. (214) 987-6317
Contact: SPENCER BYINGTON

The John R. McAdams Company, Inc.
111 Hillside Drive
Lewisville, Texas 75057
972. 436. 9712

201 Country View Drive
Roanoke, Texas 76262
940. 240. 1012

TBPE: 19762 TBPLS: 10194440
www.gacon.com
www.mcadamsco.com

Contact: Matthew G. St. Marie, P.E.

The John R. McAdams Company, Inc.
111 Hillside Drive
Lewisville, Texas 75057
972. 436. 9712

201 Country View Drive
Roanoke, Texas 76262
940. 240. 1012

TBPE: 19762 TBPLS: 10194440
www.gacon.com
www.mcadamsco.com

SWBC ROCKWALL
Lot 1, Block A
SWBC ROCKWALL ADDITION, PHASE I
21.280 Acres
in the
J.M. ALLEN SURVEY, ABSTRACT NO. 2
CITY OF ROCKWALL
ROCKWALL COUNTY, TEXAS

COVER SHEET

STATE OF TEXAS
MATTHEW G. ST. MARIE
110326
LICENSED
PROFESSIONAL ENGINEER

MCADAMS
TBPE: 19762

Drawn By:	MD
Date:	12/19/2017
Scale:	N.T.S.
Revisions:	
03/23/2018	AS-BUILTS:
05/16/2018	03/04/2021
07/16/2018	
08/13/2018	
10/12/2018	
11/07/2018	
12/14/2018	
12/26/2018	

17193

C

CONSTRUCTION PLANS

SWBC ROCKWALL

File: Z:\2017\17193\drawings\As-Builts\As-Built Sheets\17193 ASB COV
Plotted: 3/2/2021 7:35 AM by Matthew Scott - 3/2/2021 7:35 AM by zmoore