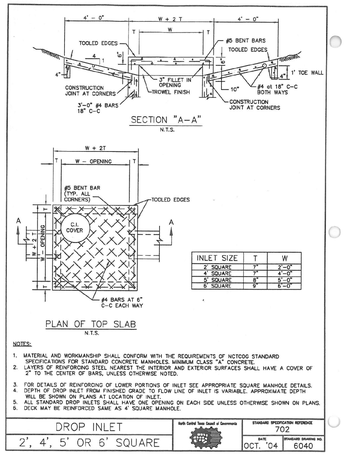

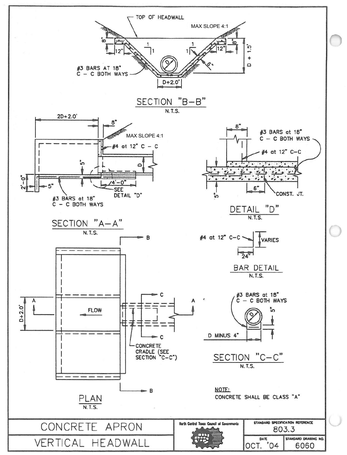

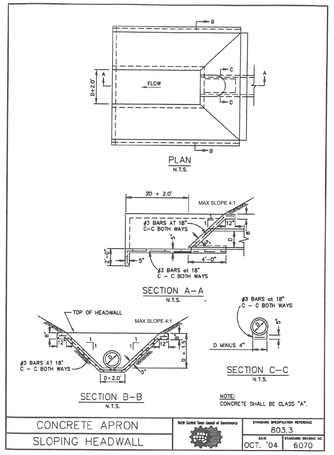

NOTES FOR DETAILS 6040, 6060, 6070:

1. ALL CONCRETE FOR STRUCTURES SHALL BE CLASS F (4200 PSI, MINIMUM 6.5 SACK CEMENT)
2. NO FLY ASH IS ALLOWED IN CONCRETE FOR STRUCTURES.

GENERAL NOTES

1. CONTRACTOR TO USE DETAILS AS OUTLINED IN THE STANDARD SPECIFICATIONS FOR PUBLIC WORKS CONSTRUCTION, NORTH CENTRAL TEXAS, THIRD EDITION AND CITY OF ROCKWALL STANDARDS OF DESIGN AND CONSTRUCTION.
2. SOME OF THE DETAILS IN THE STANDARD SPECIFICATIONS FOR PUBLIC WORKS CONSTRUCTION, NORTH CENTRAL TEXAS, FOURTH EDITION HAVE BEEN ADJUSTED PER THE CITY OF ROCKWALL'S STANDARDS OF DESIGN AND CONSTRUCTION SECTION 8 SPECIAL PROVISIONS TO THE NCTCOG'S STANDARD SPECIFICATIONS FOR PUBLIC WORKS CONSTRUCTION STANDARDS.

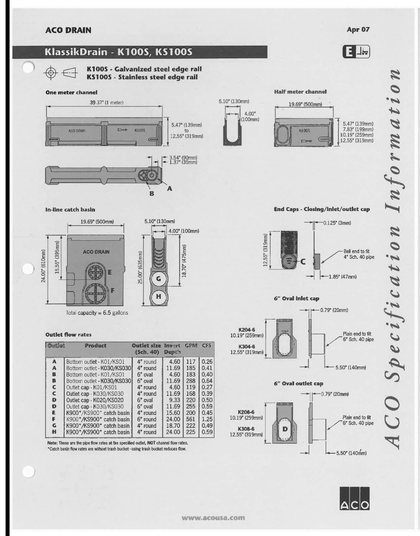

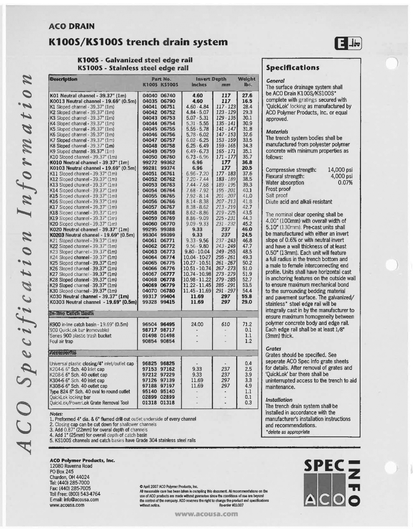

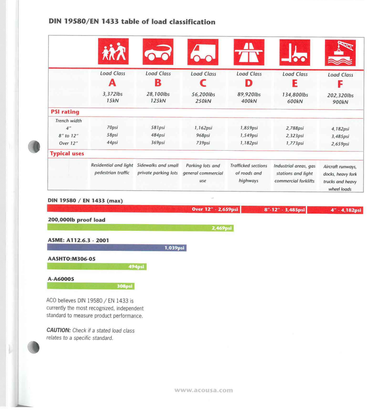

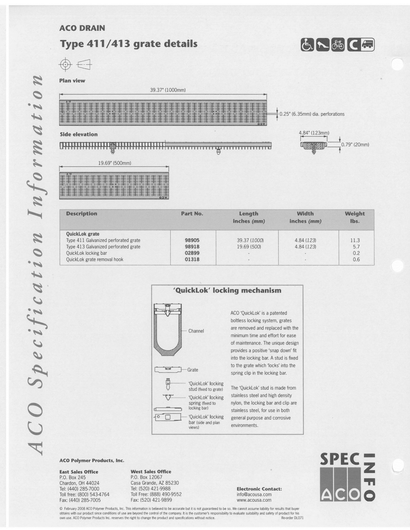

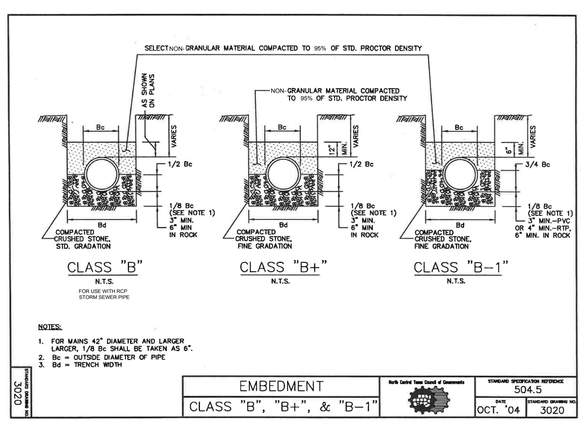

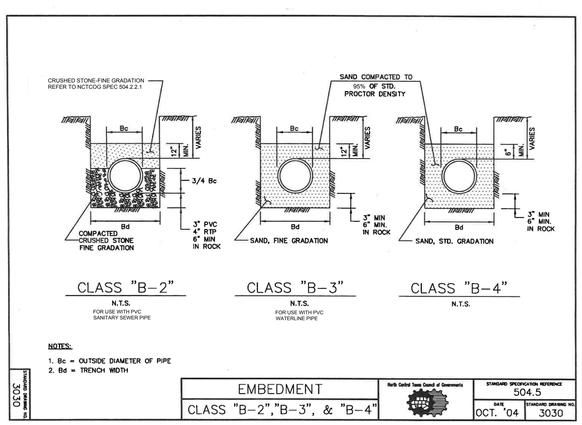

* H–20: AXLE LOADING= 32,000 LBS OR WHEEL LOADING= 16,000

CLASS C LOADING= 56,200 LBS

THEREFORE CLASS C IS GREATER THAN OR EQUAL TO H–20.

AS-BUILT RECORD DRAWING

THE INFORMATION ON THESE PLANS HAS BEEN REVISED TO REFLECT CHANGES TO PUBLIC IMPROVEMENTS MADE DURING CONSTRUCTION. UNLESS OTHERWISE NOTED, THE CONSTRUCTION OF THE PUBLIC IMPROVEMENTS IS IN GENERAL CONFORMANCE WITH THESE PLANS, BASED UPON INFORMATION PROVIDED BY THE CONTRACTOR AND FIELD VERIFICATIONS. THE RESPONSIBILITY FOR ACCURACY AND COMPLETENESS BELONGS TO THE CONTRACTOR.

Matthew G. St. Marie
THE JOHN R MCADAMS COMPANY, INC.

Date: 03/04/2021

STATE OF TEXAS
MATTHEW G. ST. MARIE
110326
LICENSED PROFESSIONAL ENGINEER

MCADAMS
TBPE: 19762

Revisions:
03/23/2018 AS–BUILTS:
05/16/2018 03/04/2021
07/16/2018
08/13/2018
10/12/2018
11/07/2018
12/14/2018
12/26/2018

Drawn By: ASC
Date: 12/19/2017
Scale: N.T.S.

17193

C40

OWNER/DEVELOPER
SWBC BUILDERS
5949 SHERRY LANE #750
DALLAS, TX 75225
Ph. (214) 987-6317
Contact: SPENCER BYINGTON

The John R. McAdams Company, Inc.
1150 Hidden Ridge
Lewisville, Texas 75057
972.436.9712
201 Country View Drive
Roanoke, Texas 76262
940.240.1012
TBPE: Firm No. F-19440
www.mcadamsco.com

McADAMS

SWBC ROCKWALL

STANDARD CONSTRUCTION DETAILS

SWBC ROCKWALL
Lot 1, Block A
SWBC ROCKWALL ADDITION, PHASE I
21.2280 Acres
in the
J.M. ALLEN SURVEY, ABSTRACT NO. 2
CITY OF ROCKWALL
ROCKWALL COUNTY, TEXAS

File: Z:\2017\17193\Drawings\As-Built\As-Built Sheets\17193 ASB DET
Plotted: 3/5/2021 10:29 AM by St. Marie, Matthew; Saved: 3/5/2021 10:20 AM by stmarie