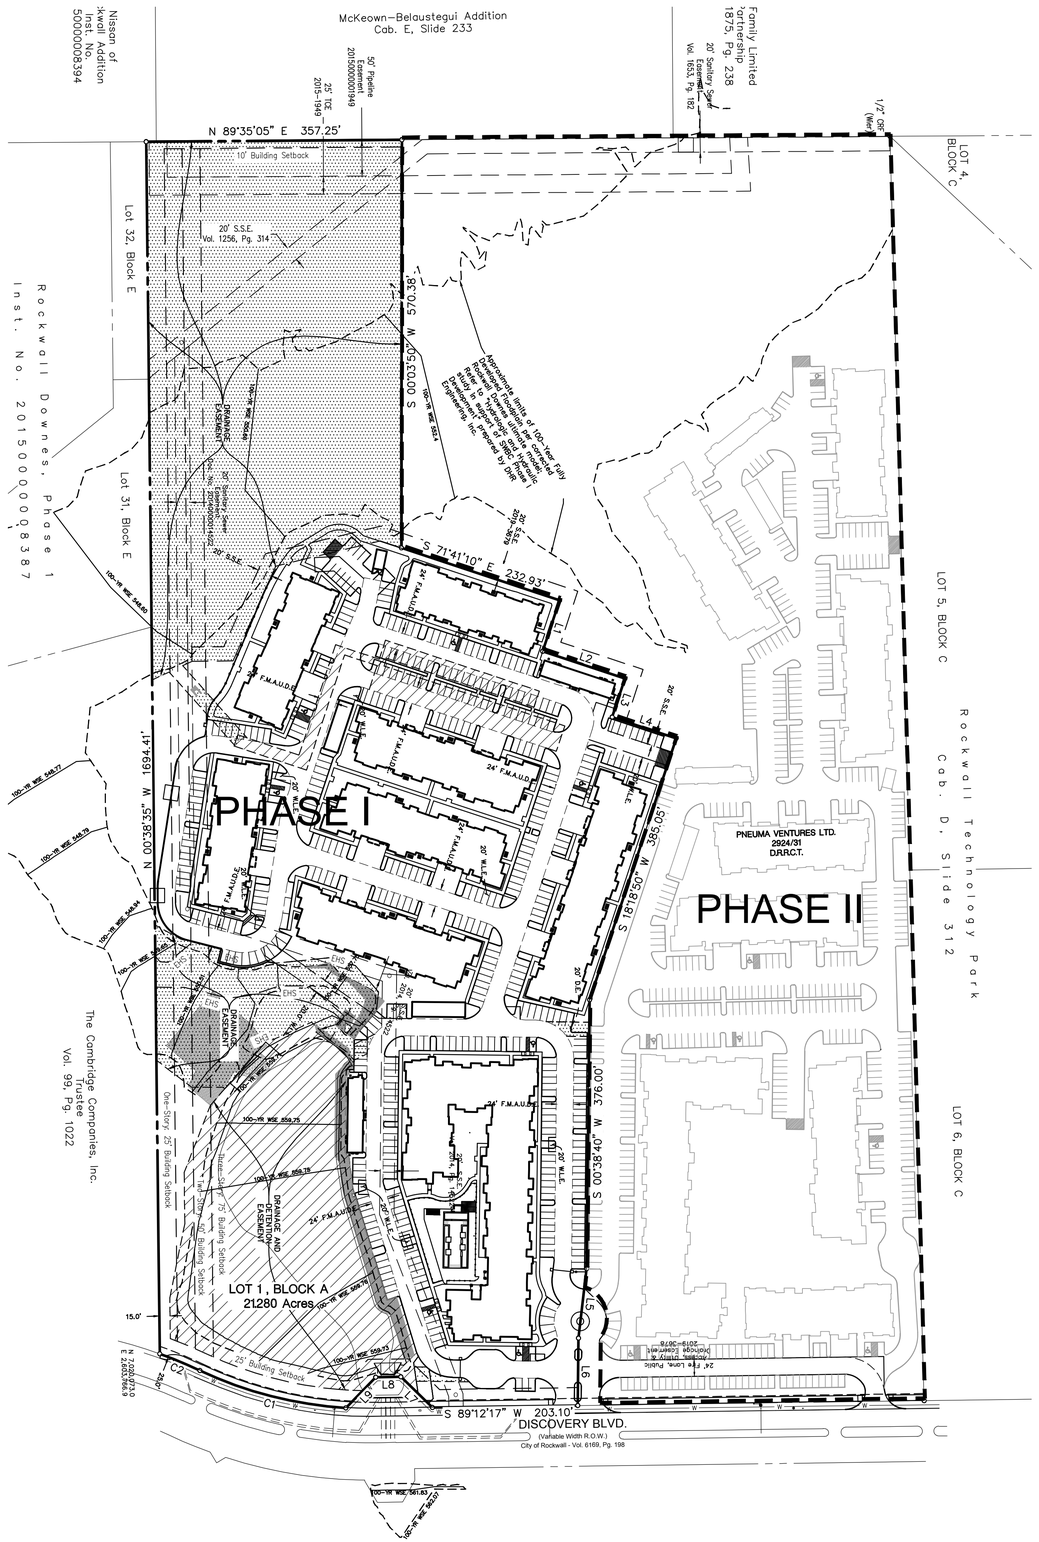
McKeown-Belaustegui Addition
Cab. E, Slide 233
Nissan of Rockwall Addition
Inst. No. 20150000008394
Family Limited Partnership
18775, Pg. 238
N 89°35'05" E 357.25'
50' Pipeline Easement 20150000001949
25' TDE 2015-1949
20' Sanitary Sewer Easement Vol. 1653, Pg. 182
1/2" CIRF (Wit.)
LOT 4, BLOCK C
10' Building Setback
20' S.S.E. Vol. 1256, Pg. 314
Lot 32, Block E
Rockwall Downes, Phase 1
Inst. No. 20150000008387
S 00°38'46" W 570.38'
20' S.S.E. Vol. 1256, Pg. 314
Lot 31, Block E
100-YR WSE 548.83
20' Sanitary Sewer Easement 20150000001949
S 71°41'10" E 232.93'
24' F.M.A.U.D.E.
PHASE I
N 00°36'35" W 1694.41'
100-YR WSE 548.77
100-YR WSE 548.79
100-YR WSE 548.84
100-YR WSE 548.85
EHS
DRAINAGE EASEMENT
100-YR WSE 554.75
100-YR WSE 559.78
One-Story 25' Building Setback
24' F.M.A.U.D.E.
DRAINAGE AND DETENTION EASEMENT
LOT 1, BLOCK A
21280 Acres
100-YR WSE 559.73
15.0'
25' Building Setback
The Cambridge Companies, Inc.
Trustee
Vol. 99, Pg. 1022
C2
C1
L8
S 89°12'17" W 203.10'
DISCOVERY BLVD.
(Variable Width R.O.W.)
City of Rockwall - Vol. 6169, Pg. 198
100-YR WSE 561.83
100-YR WSE 562.07
PNEUMA VENTURES LTD.
2924/31
DRRCT.
PHASE II
S 18°12'50" W 395.05'
S 00°38'46" W 376.00'
LOT 5, BLOCK C
LOT 6, BLOCK C
Rockwall Technology Park
Cab. D, Slide 312
24' Fire Lane, Public Access Easement & Utility Easement 2019-3618
L1
L2
L3
L4
L5
L6
L7
L9
