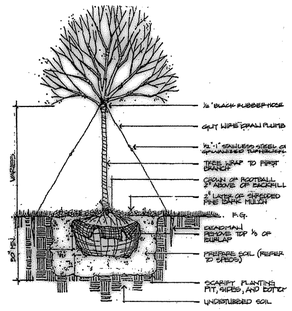

LARGE CANOPY TREE PLANTING DETAIL

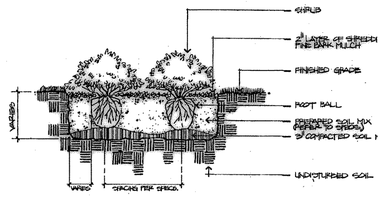

SHRUB PLANTING DETAIL

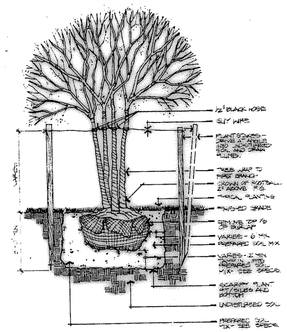

ORNAMENTAL TREE PLANTING DETAIL

NOTES:

1. All concrete by others
2. All finish grades to be brought to top of curb by **Genral Contractor** to +/- 1/10'
3. **Landscape Contractor** shall be responsible for making himself familiar with all underground utilities, structures and line runs
4. Refer to planting plan for planting locations and plant materials legend for specifications
5. **Landscape Contractor** shall be responsible for any coordination with subcontractors as required to accomplish all planting operations
6. Landscape Contractor is responsible for verifying all quantities per drawings and specifications provided by landscape architect
7. Landscape Contractor shall haul off and remove all of his own debris from site
8. All landscape areas are to be automatically irrigated

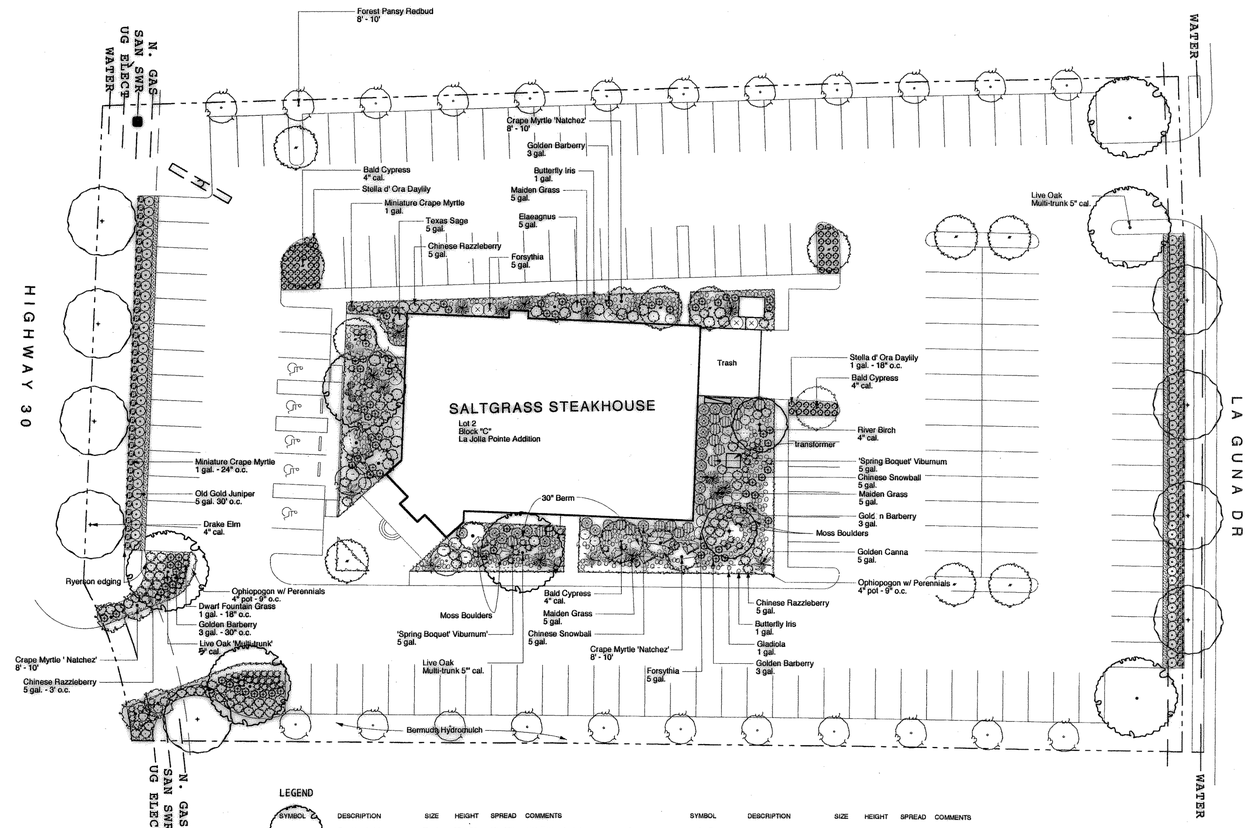

LEGEND

SYMBOL	DESCRIPTION	SIZE	HEIGHT	SPREAD	COMMENTS
	Quercus virginiana Live Oak	5" cal.	22'- 24'	15' - 18"	Multi-Trunk, straight, nursery grown, & uniform branchin Specimen
	Ulmus parvifolia 'Drake' Drake Elm	4" cal.	14' – 16'	6' – 8'	Single Trunk, straight, nursery grown, & uniform branching
	Taxodium distichum Bald Cypress	4" cal.	15' – 16'	5' – 7'	Single Trunk, straight, nursery grown, &
	Betual nigra River Birch	4" cal.	15' – 16'	5' – 7'	Single Trunk, straight, nursery grown, &
	Cercis canadensis 'Forest Pansy 8' - 10' Forest Pansy Redbud	8' - 10'	4'- 6'		Single trunk, well branched
	Leucophyllum frutescens Texas Sage	5 gal.	18"	15"	Full and compact, not leggy
	Forsythia x intermedia Forsythia	5 gal.	24"	24"	Full
	Eleeagnus pungens 'Fruitlandi'S gal. Eleagnus	30"		30"	Full
	Miscanthis sinensis 'Gracillimus' 5 agal. Maiden Grass	30"		24"	Full
	Berberis spp. 'Razzleberry' Chinese Razzleberry	5 gal.	30"	18"	Full and compact
	Berberis thunbergi 'Aurea' GoldenBarberry	3 gal.	18""	18"	Full and compact
	Canna flaoida Golden Canna	5 gal.	30"	24"	Full & leafed out
	Viburnum macrocephalum Chinese Snowball	5gal.	36"	24"	Full &non-chloristic
	Viburnum tinus 'S. B.' Spring Bloquet Viburnum	5 gal.	24"	18"	Full & compact, not leggy
	Amplelo chinensis "Pltzeriana' O.G.	5 gal.	24" o.c.	18"	Full & compactplant 30' o.c.
	Pennisetum alopecuroides 'Hameli'	1 gal.	18"	15"	Full
	Lagerstroemia indica'Miniature' '	1gal.	12"	15"	Full, plant 24" o.c.
	Bermuda Hydromulch Cynodon dactylon				See specifications for installation

SYMBOL	DESCRIPTION	SIZE	HEIGHT	SPREAD	COMMENTS
	Ophiopogon japonicum Mondo Grass	4" pot	6"	6'	Plant 9" o.c. w/ perennials
	Hemerocallis x 'Stella d'Ora Stella d'Ora daylily	1 gal.	15"	18"	Plant 18" o.c.
	Ryerson Steel Edging 4"				Install to within 1" of finish grade
	Moss Boulders				
	Colorado River	5"-6" diam. min.			Install to 6" depth
	PERENNIALS (All perennials to be planted in ophiopogon beds)				
	Coreopsis grandiflora 'E.S.' Tickseed 'Early Sunrise'	4" pot	6"	12"	Plant 9" o.c.
	Zephranthes spp. Rain Lily	4" pot	4"	4"	Plant 9" o.c.
	Aquilegia canadensis Columbine 'McKana's Giant	4" pot	12"	4"	Locate by Landscape Architect in field
	Heuchera sanguinea 'White Cloud' 4" pot Heuchera 'Coral Bells'		8"	6"	Locate by Landscape Architect in field
	Campanula carpatica 'White Cap' 4" pot Carpathian Bellflower		12"	8"	Locate by Landscape Architect in field
	Campanula persicifolia 'Alba' Peach-leaved Bellflower	4" pot	12"	8"	Locate by Landscape Architect in field
	Gazania 'Aztec Queen' Treasure Flower	4" pot	6"	6"	Plant 9" o.c.
	Veronica x 'Icicle' Speedwell	4' pot	6"	6"	Locate by Landscape Architect in field
	Iris spp. Butterfly Iris	1 gal.	12"	12"	Locate by Landscape Architect in field
	Gladiolus spp. Gladiolus 'Rec'	1 gal.	12"	12"	Locate by Landscape Architect in field

KELLY JAMES
Design Group
2725 Canton Street
Dallas, Texas 75226

CONTRACTOR SHALL VERIFY ALL CONDITIONS AND DIMENSIONS AT THE JOB SITE AND NOTIFY THE ARCHITECT OF ANY DIMENSIONAL DISCREPANCIES BEFORE PROCEEDING WITH ANY BIDDING OR FABRICATING ANY WORK. – DO NOT SCALE DRAWINGS.

THESE DOCUMENTS, THE IDEAS AND THE DECISIONS INCORPORATED HEREIN ARE THE PROPERTY OF SALTGRASS, INC. AND ARE NOT TO BE USED IN WHOLE OR IN PART FOR ANY OTHER PROJECT WITHOUT WRITTEN AUTHORIZATION OF SALTGRASS, INC.

SALTGRASS STEAK HOUSE
9039 KATY FREEWAY, SUITE 250
HOUSTON, TX 77024
PHONE: 713-467-1161
FAX: 713-200-2066

LANDSCAPE PLAN

SALT GRASS STEAK HOUSE
IH-30 @ HORIZON ROAD
ROCKWALL, Texas

ASA ENGINEERING
1781-B SHERIDAN, SUITE 215
DALLAS, TEXAS 75252
(972) 248-9651
FAX (972) 248-9651

REVISIONS:
NO. DATE: DESCRIPTION:
1 ??/??/00 ????????

ISSUE DATE: ??/??/00
ISSUED FOR:
PERMIT
ADA
BID
CONST.
DRAWN BY: MIR ALI
CHECKED BY:
SG Q.C. BY:
DATE:
VERSION:

C-7