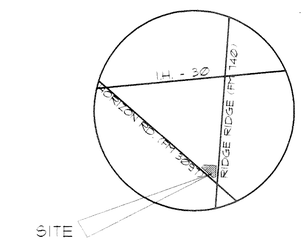

VICINITY MAP

NTS

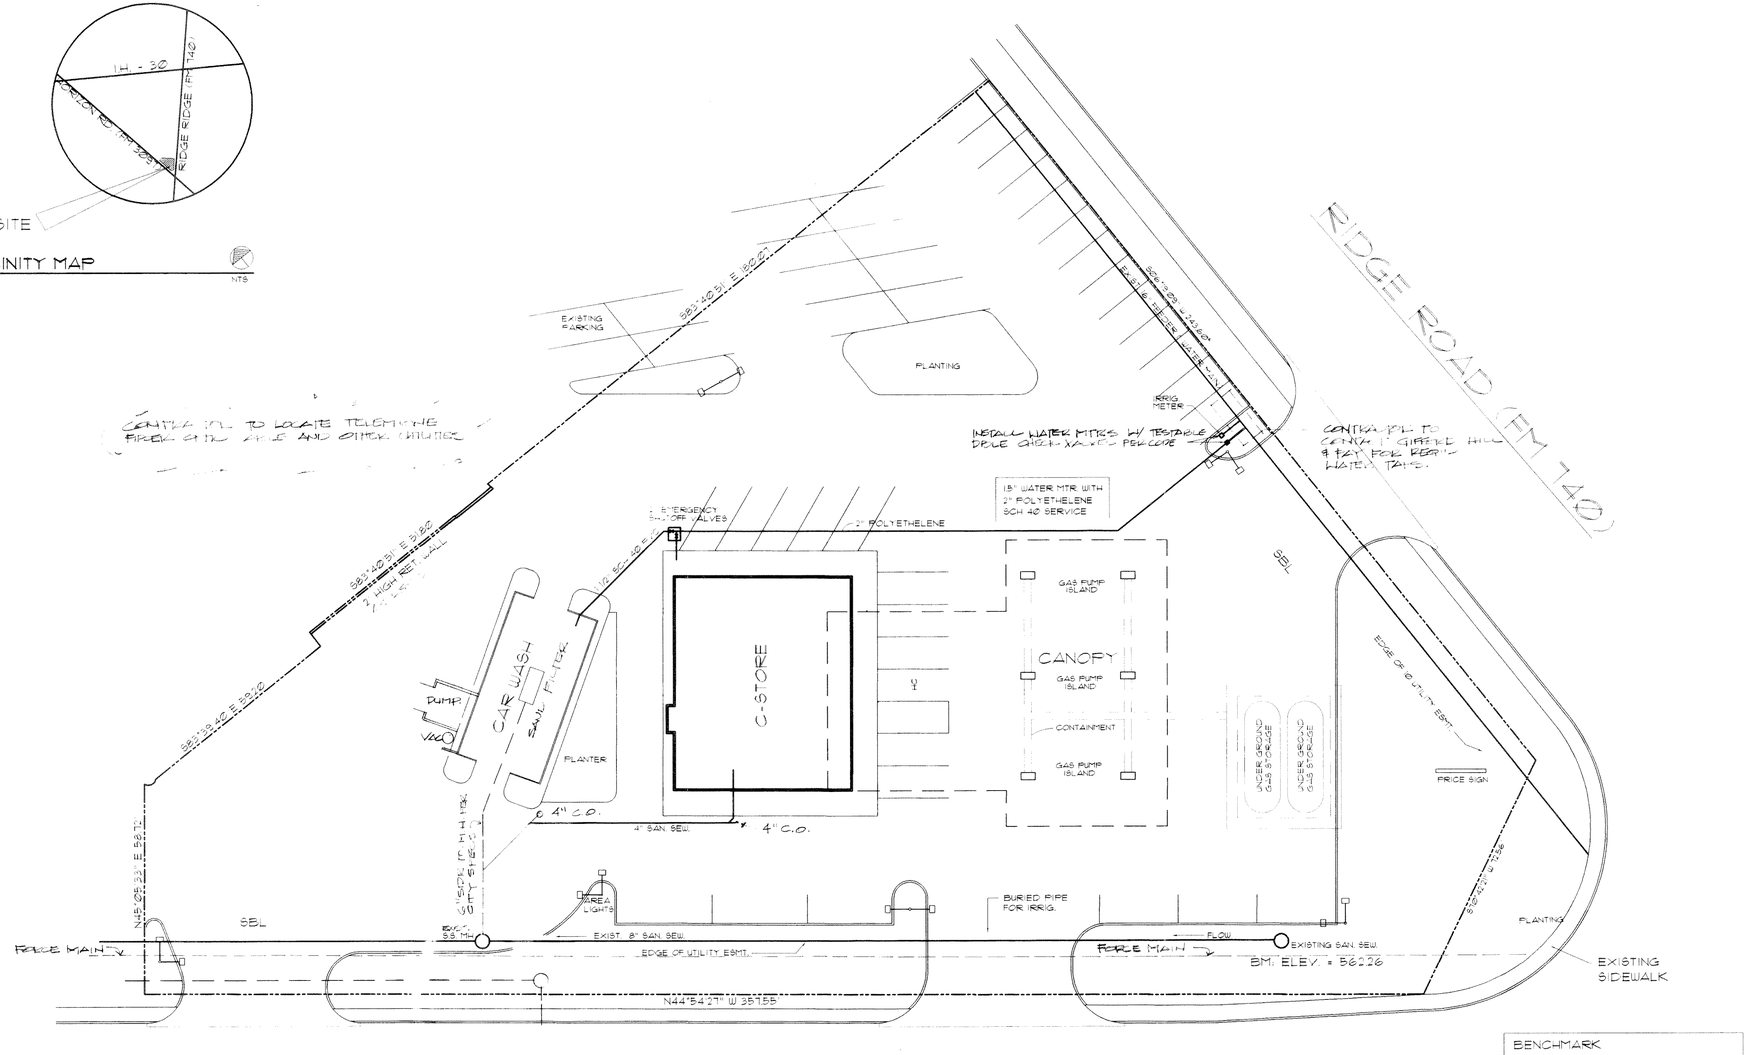

BENCHMARK
TOP OF EXIST. SAN. SEW. MH ON SITE NEAR INTERSECTION OF HORIZON & RIDGE ROADS.
BM. ELEV. = 56.26

WATER AND WASTEWATER PLAN

SCALE: 1= 20.0'

REVISIONS	BY
1- 8/17/98	WLS
2-9/19/98	WLS
3-9/28/98	WLS
4-9/29/98	WLS

WATER/ WASTEWATER

A & A DESIGN
116 ADAMS ROAD
LONGVIEW, TX 75604
(903) 759-8631
FAX 903-759-8634

8/21/98

SCOTTIES CONV. STORE
HORIZON RD. @ RIDGE RD. = FM. 740

JM AMERICAN CANOPIES
1710 NORTH MAIN - GLADEWATER, TX - (903) 845-4066

DRAWN BY HDT
CHECKED BY WLS
DATE 06/05/98
FIT SCOT-WSP
JOB NO. 0605-98
SHEET C-3
OF SHEETS