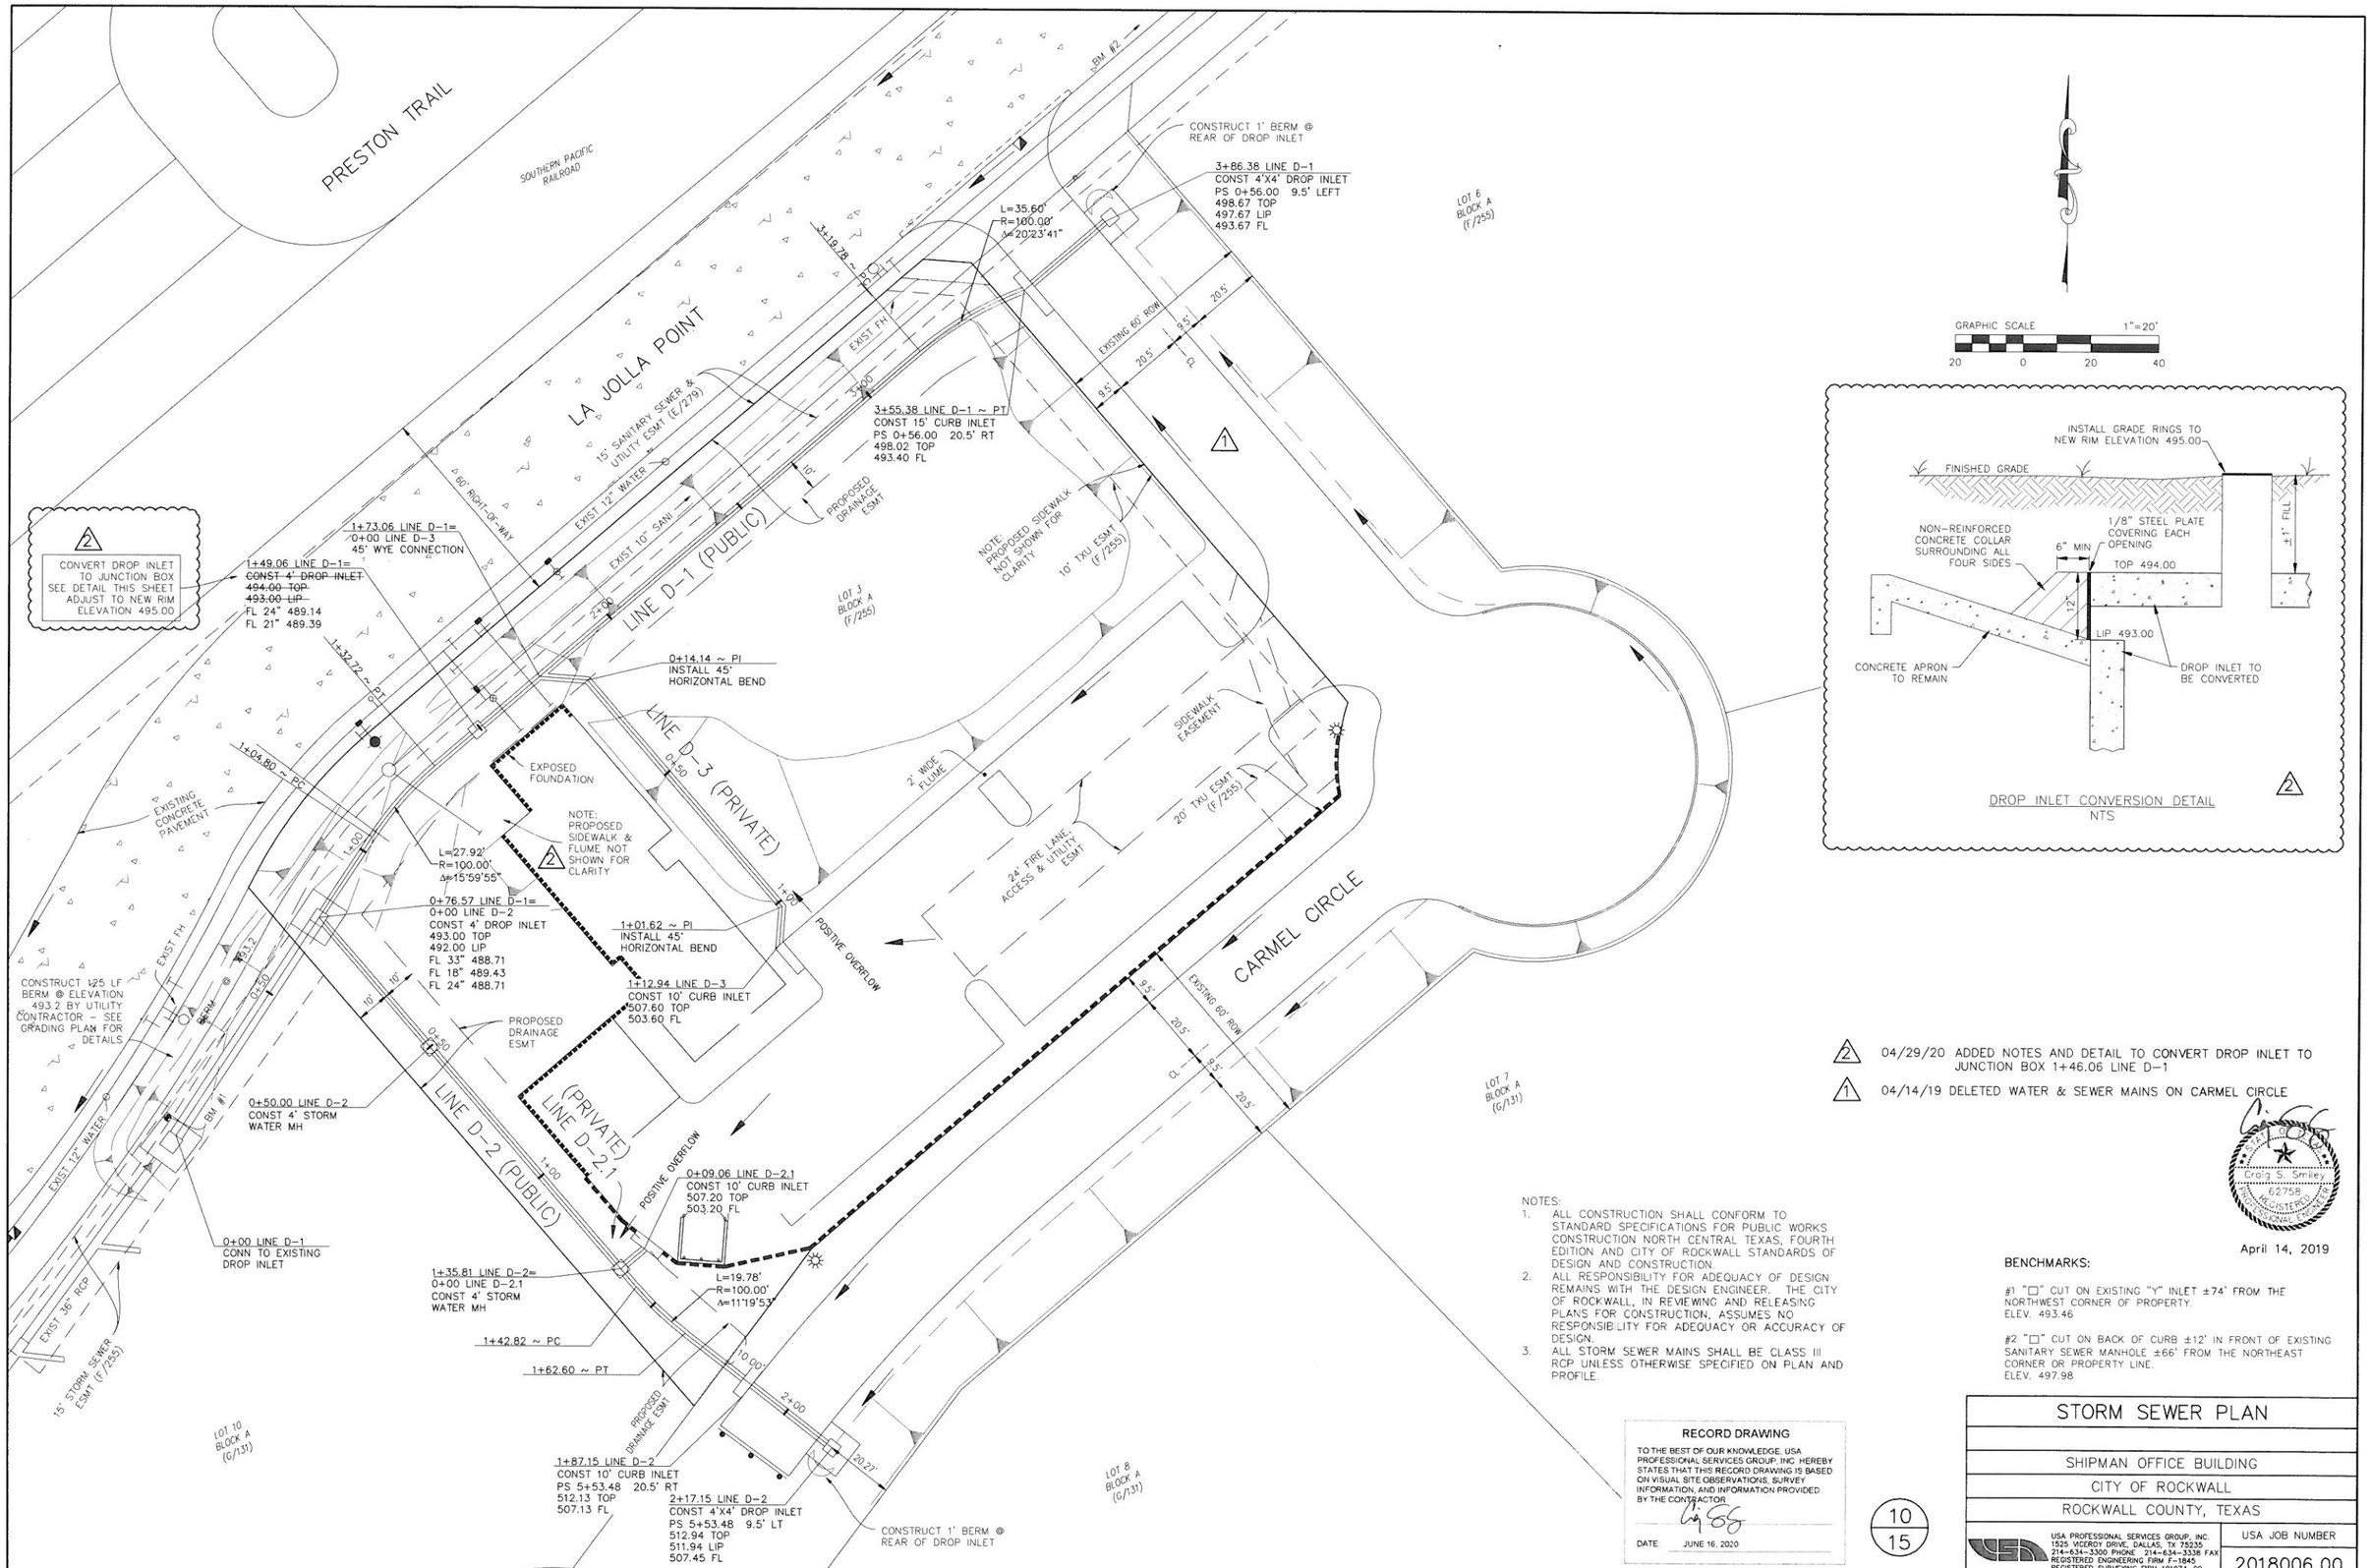

2 04/29/20 ADDED NOTES AND DETAIL TO CONVERT DROP INLET TO JUNCTION BOX 1+46.06 LINE D-1

1 04/14/19 DELETED WATER & SEWER MAINS ON CARMEL CIRCLE

Craig S. Smiley
62798
REGISTERED PROFESSIONAL ENGINEER
TEXAS

April 14, 2019

NOTES:

1. ALL CONSTRUCTION SHALL CONFORM TO STANDARD SPECIFICATIONS FOR PUBLIC WORKS CONSTRUCTION NORTH CENTRAL TEXAS, FOURTH EDITION AND CITY OF ROCKWALL STANDARDS OF DESIGN AND CONSTRUCTION.
2. ALL RESPONSIBILITY FOR ADEQUACY OF DESIGN REMAINS WITH THE DESIGN ENGINEER. THE CITY OF ROCKWALL, IN REVIEWING AND RELEASING PLANS FOR CONSTRUCTION, ASSUMES NO RESPONSIBILITY FOR ADEQUACY OR ACCURACY OF DESIGN.
3. ALL STORM SEWER MAINS SHALL BE CLASS III RCP UNLESS OTHERWISE SPECIFIED ON PLAN AND PROFILE.

RECORD DRAWING

TO THE BEST OF OUR KNOWLEDGE, USA PROFESSIONAL SERVICES GROUP, INC. HEREBY STATES THAT THIS RECORD DRAWING IS BASED ON VISUAL SITE OBSERVATIONS, SURVEY INFORMATION, AND INFORMATION PROVIDED BY THE CONTRACTOR.

DATE: JUNE 16, 2020

BENCHMARKS:

#1 "□" CUT ON EXISTING "Y" INLET ±74' FROM THE NORTHWEST CORNER OF PROPERTY.
ELEV. 493.46

#2 "□" CUT ON BACK OF CURB ±12' IN FRONT OF EXISTING SANITARY SEWER MANHOLE ±66' FROM THE NORTHEAST CORNER OR PROPERTY LINE.
ELEV. 497.98

10
15

STORM SEWER PLAN

SHIPMAN OFFICE BUILDING

CITY OF ROCKWALL

ROCKWALL COUNTY, TEXAS

USA PROFESSIONAL SERVICES GROUP, INC.
1525 VICEROY DRIVE, DALLAS, TX 75235
214-634-3300 PHONE 214-634-3336 FAX
REGISTERED ENGINEERING FIRM F-1845
REGISTERED SURVEYING FIRM 101074-00

USA JOB NUMBER

2018006.00