


LOCATION MAP
NO SCALE

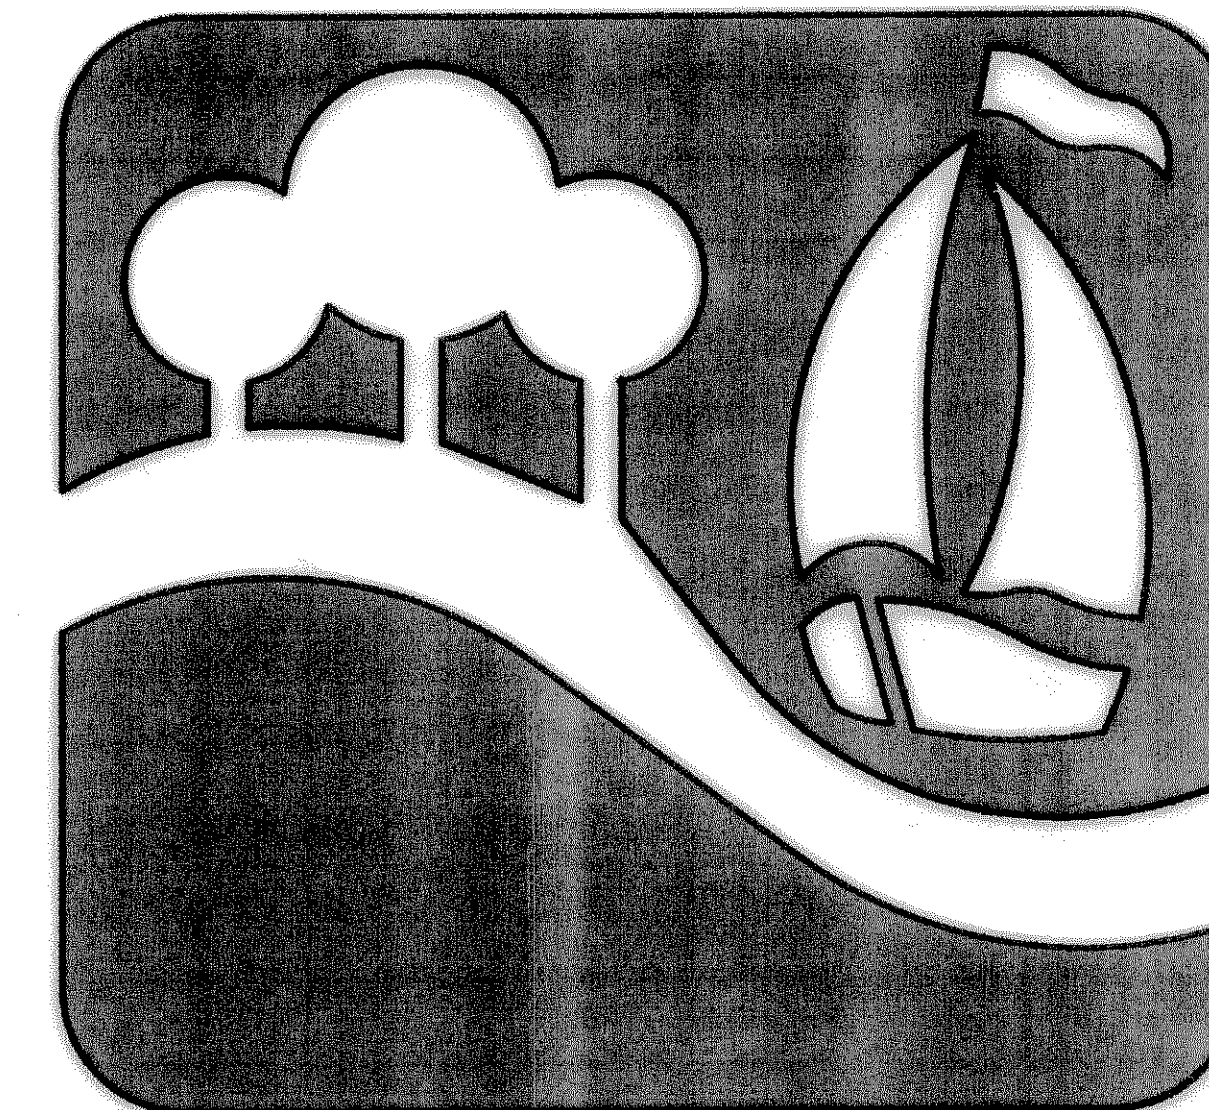


"THE NEW HORIZON"


SITE CONSTRUCTION PLANS
FOR
THE SHOPS AT RIDGE CREEK
BLOCK 1, LOT 1
IN THE
CITY OF ROCKWALL, TEXAS

SHEET INDEX

Sheet No.	Description
1	Cover Sheet
2	Plat
SP1	Site Plan
C1	Dimension Control
C2	Grading Plan
C3	Drainage Area Map
C4	Water / Sanitary Sewer & Drainage
C5	Erosion Control
C6	Typical Details & Notes
LP1	Landscape Plan

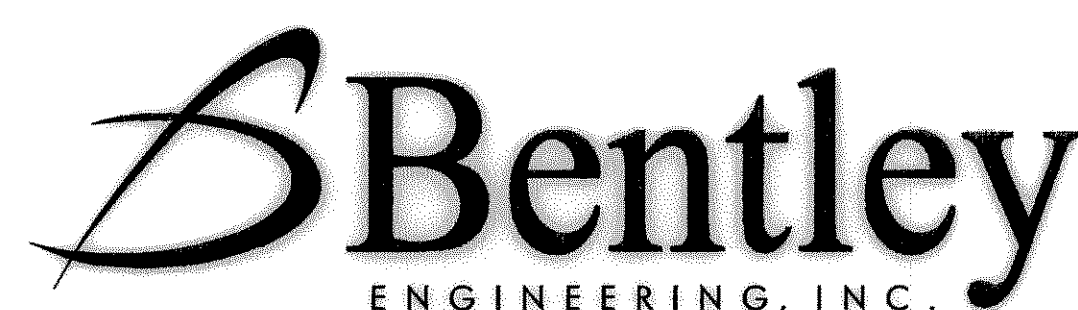

4125 BROADWAY BLVD.
SUITE A250
GARLAND, TEXAS 75043
PH. 972.240.4821
FAX. 972.240.0922

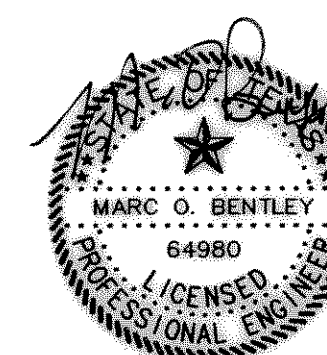

THE SEAL APPEARING ON THIS DOCUMENT WAS AUTHORIZED BY MARC O. BENTLEY, P.E. NO. 64980 ON 12/29/05

OWNER:
QUAIL RUN PARTNERS, LTD.
14860 MONTFORT ROAD, SUITE 241
DALLAS, TX 75254
214-363-1998

NOVEMBER 2005

RECORD DRAWING

IMPROVEMENTS INDICATED ON THIS PLAN WHERE MADE IN ACCORDANCE WITH THE PROJECT PLANS & SPECIFICATIONS. THE DESIGN ENGINEER IS NOT AWARE OF ANY CHANGES TO THESE PLANS OTHER THAN THOSE INDICATED.

DATE: APRIL 11, 2007

RECORD DRAWING

THE SHOPS AT RIDGE CREEK 25127