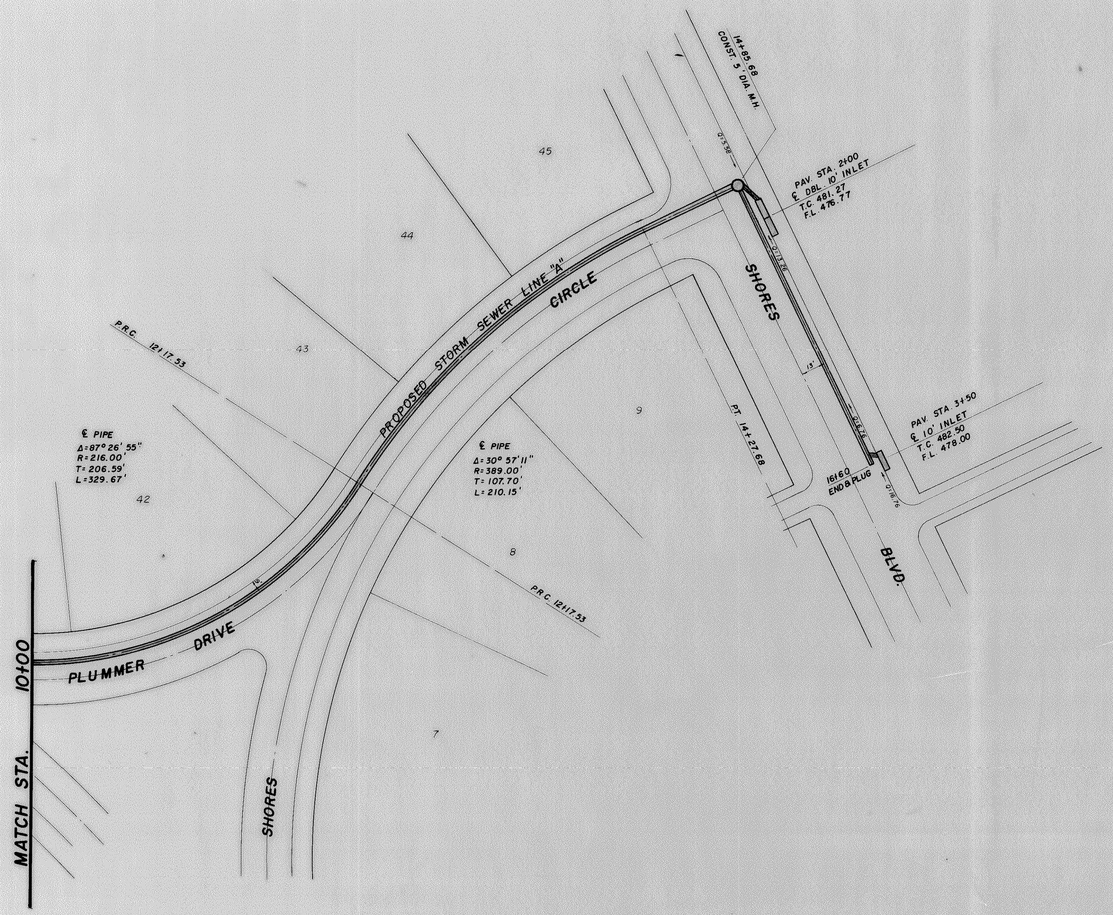

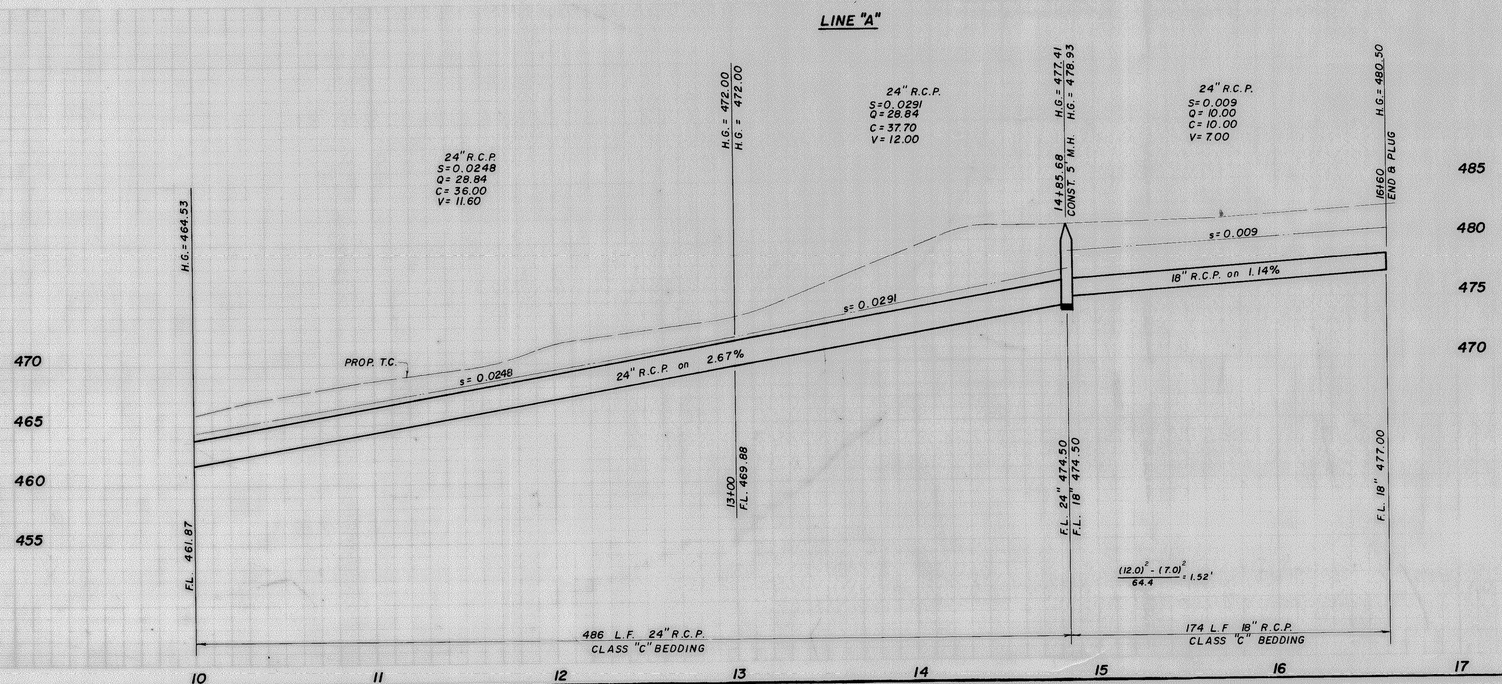

"AS BUILT"

THE SHORES						
PROPOSED STORM SEWER						
HAROLD L. EVANS ∿ CONSULTING ENGINEER						
DESIGN	DRAWN	DATE	SCALE	NOTES	FILE	NO.
H.L.E.	Danny O.	11-17-77	1"=40' H. 1"=6' V.			7.2.285