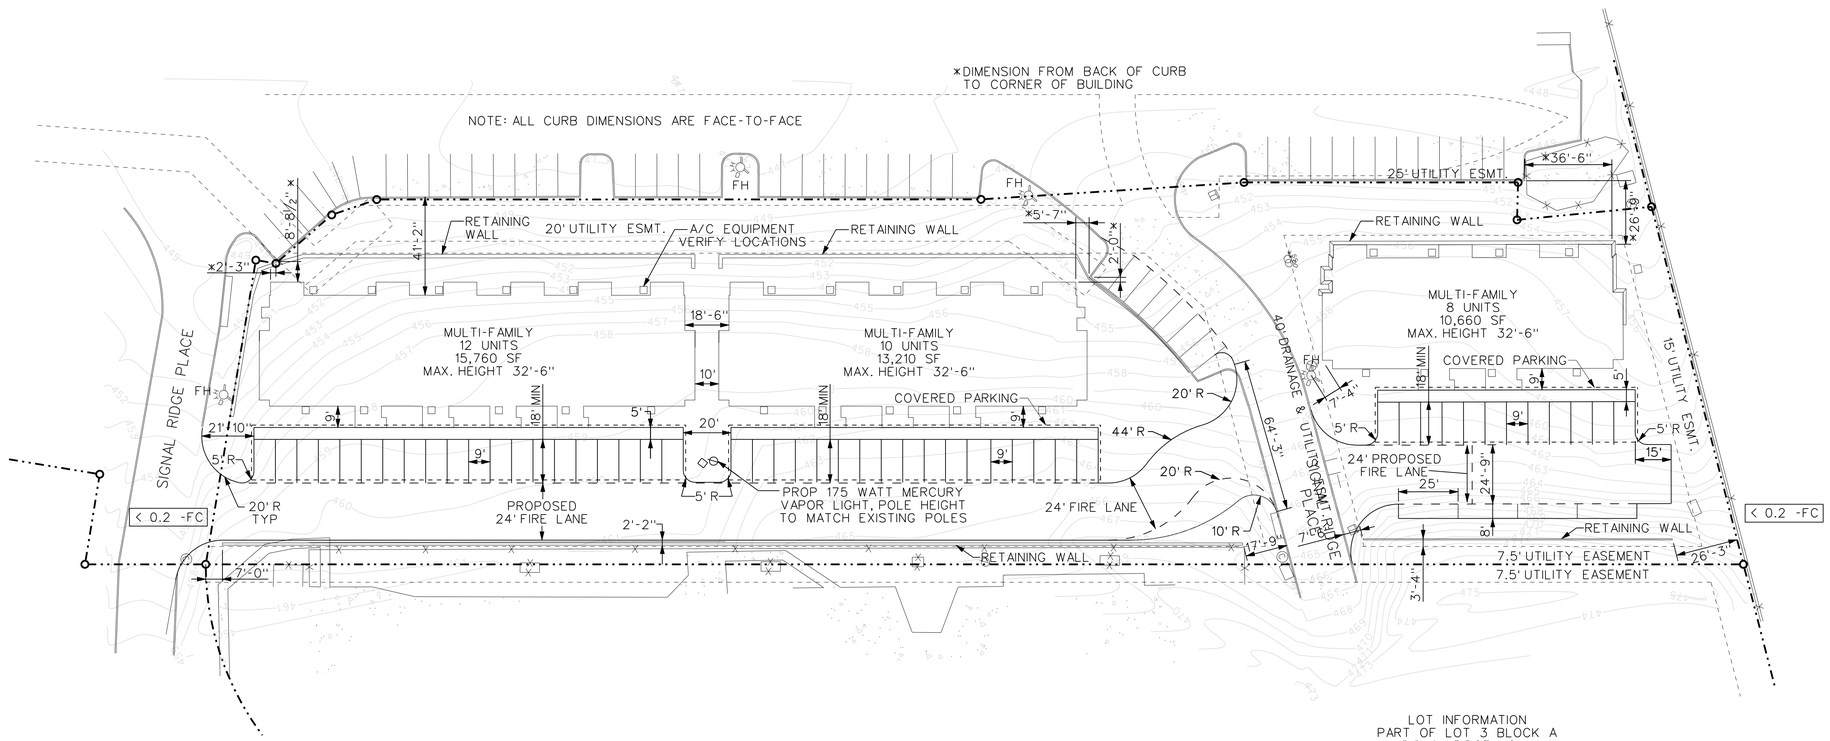

LOT INFORMATION
PART OF LOT 3 BLOCK A
SIGNAL RIDGE NO. 4
CABINET B, SLIDE 91
2.16 ACRES
CITY OF ROCKWALL, TEXAS

NOTE:
TO THE BEST OF OUR KNOWLEDGE ERIC L. DAVIS ENGINEERING, INC., HEREBY STATES THAT THIS PLAN IS AS-BUILT. THE INFORMATION PROVIDED IS BASED ON SURVEYING CONDUCTED AT THE SITE AND INFORMATION PROVIDED BY THE CONTRACTOR.

DATE	BY	REV	REVISION

ERIC L. DAVIS
ENGINEERING, INC.
425 Pinson Road Ste. G
Forney, Texas 75126
972/564-0592 Fax 972/564-6523
E-Mail ericdavis@eldengineering.com

SITE PLAN

SIGNAL RIDGE PLACE
CITY OF ROCKWALL, ROCKWALL CO, TX

DEVELOPER:

JOB NO.:
DRAWN BY:
CHECKED BY:
DATE:

AS-BUILT

STATE OF TEXAS
MITCHELL K. LENAMOND
92714
LICENSED
PROFESSIONAL ENGINEER

SCALE: 1"=30'

SHEET 2 OF 12

SHEET 2

Signal_Ridge_Place_02_Site-PlanAB.dgn
PLOTTED BY: David
6/2/2008 2:59:59 PM